
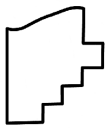


PARENT PARCEL: 06-24-039-000-042, -043, -056, -051, -052, -077 & -040-101-009, -031, -039, -040, -041 & -038-101-020

CHILD PARCEL: 06-24-039-000-080, -081, 06-24-040-101-057, -058 & 06-24-038-101-020

STARTING POINT: CL OF GRISWOLD RD. & LAKE AVE.

23-04647

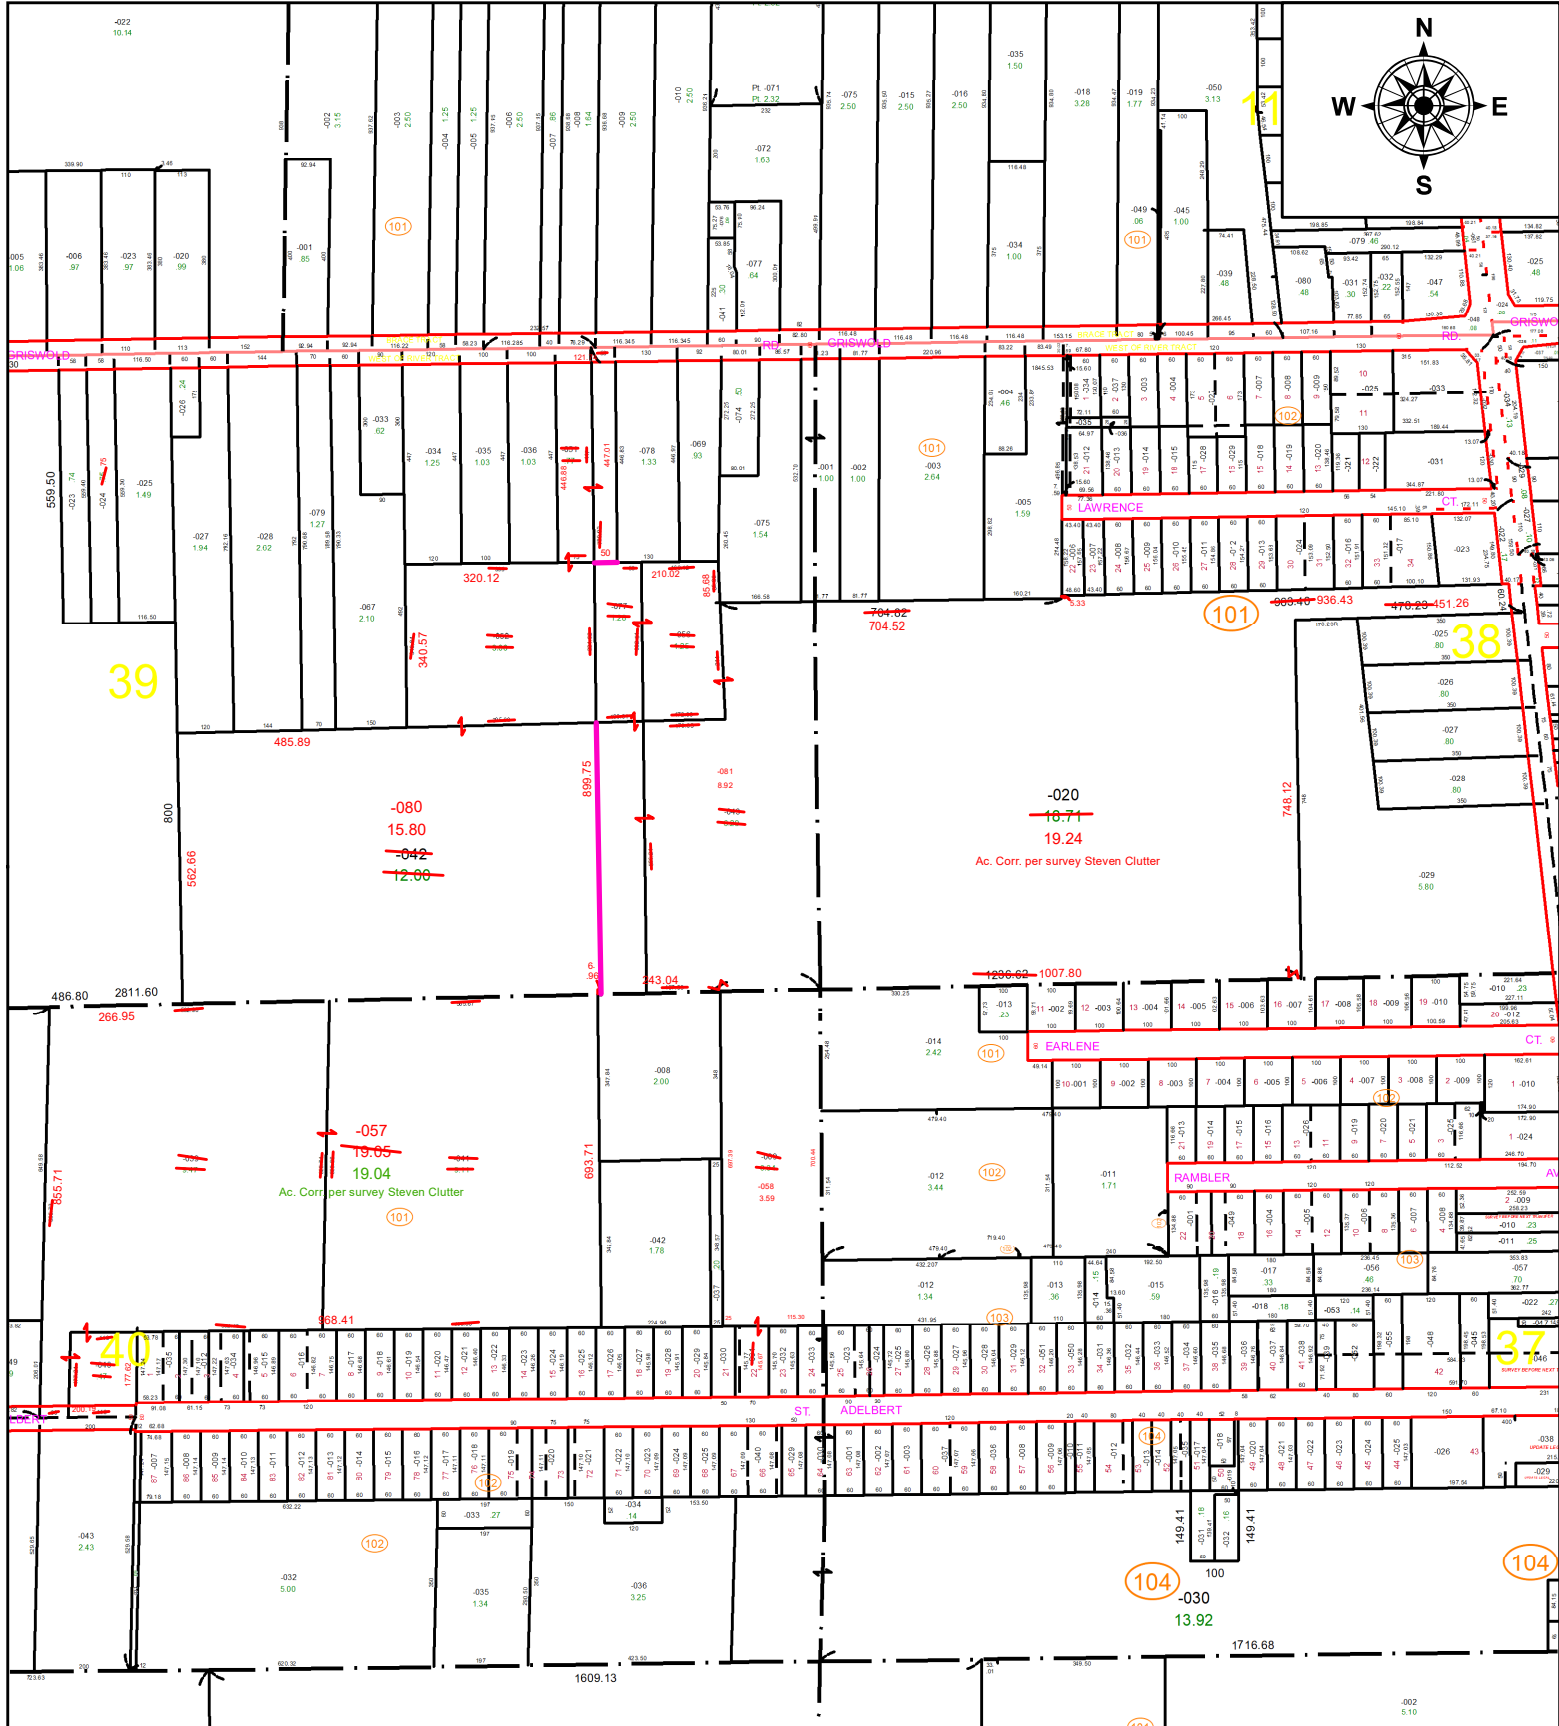

SPLITS/DEEDS PROCESSED
 LORAIN COUNTY TAX MAP DEPARTMENT
 226 MIDDLE AVE. ELYRIA, OH

SURVEYED BY: STEVEN CLUTTER **SURVEY #:** 50836
CLOSURE: 1:4244532
MAP PAGE(S): 06-24-038, -039 & -040
APPROVED BY: DMA **DATE:** 3/8/2023
SCALE: 1" = 400' **PRIOR INSTRUMENT:** 2006-177336