


PARENT PARCEL: 11-00-089-000-021, -022


CHILD PARCEL: **MAP CORRECTION ONLY**


STARTING POINT: C/L OF BUTTERNUT RIDGE RD AND SOUTH LINE OF OL 89

21-04650-C

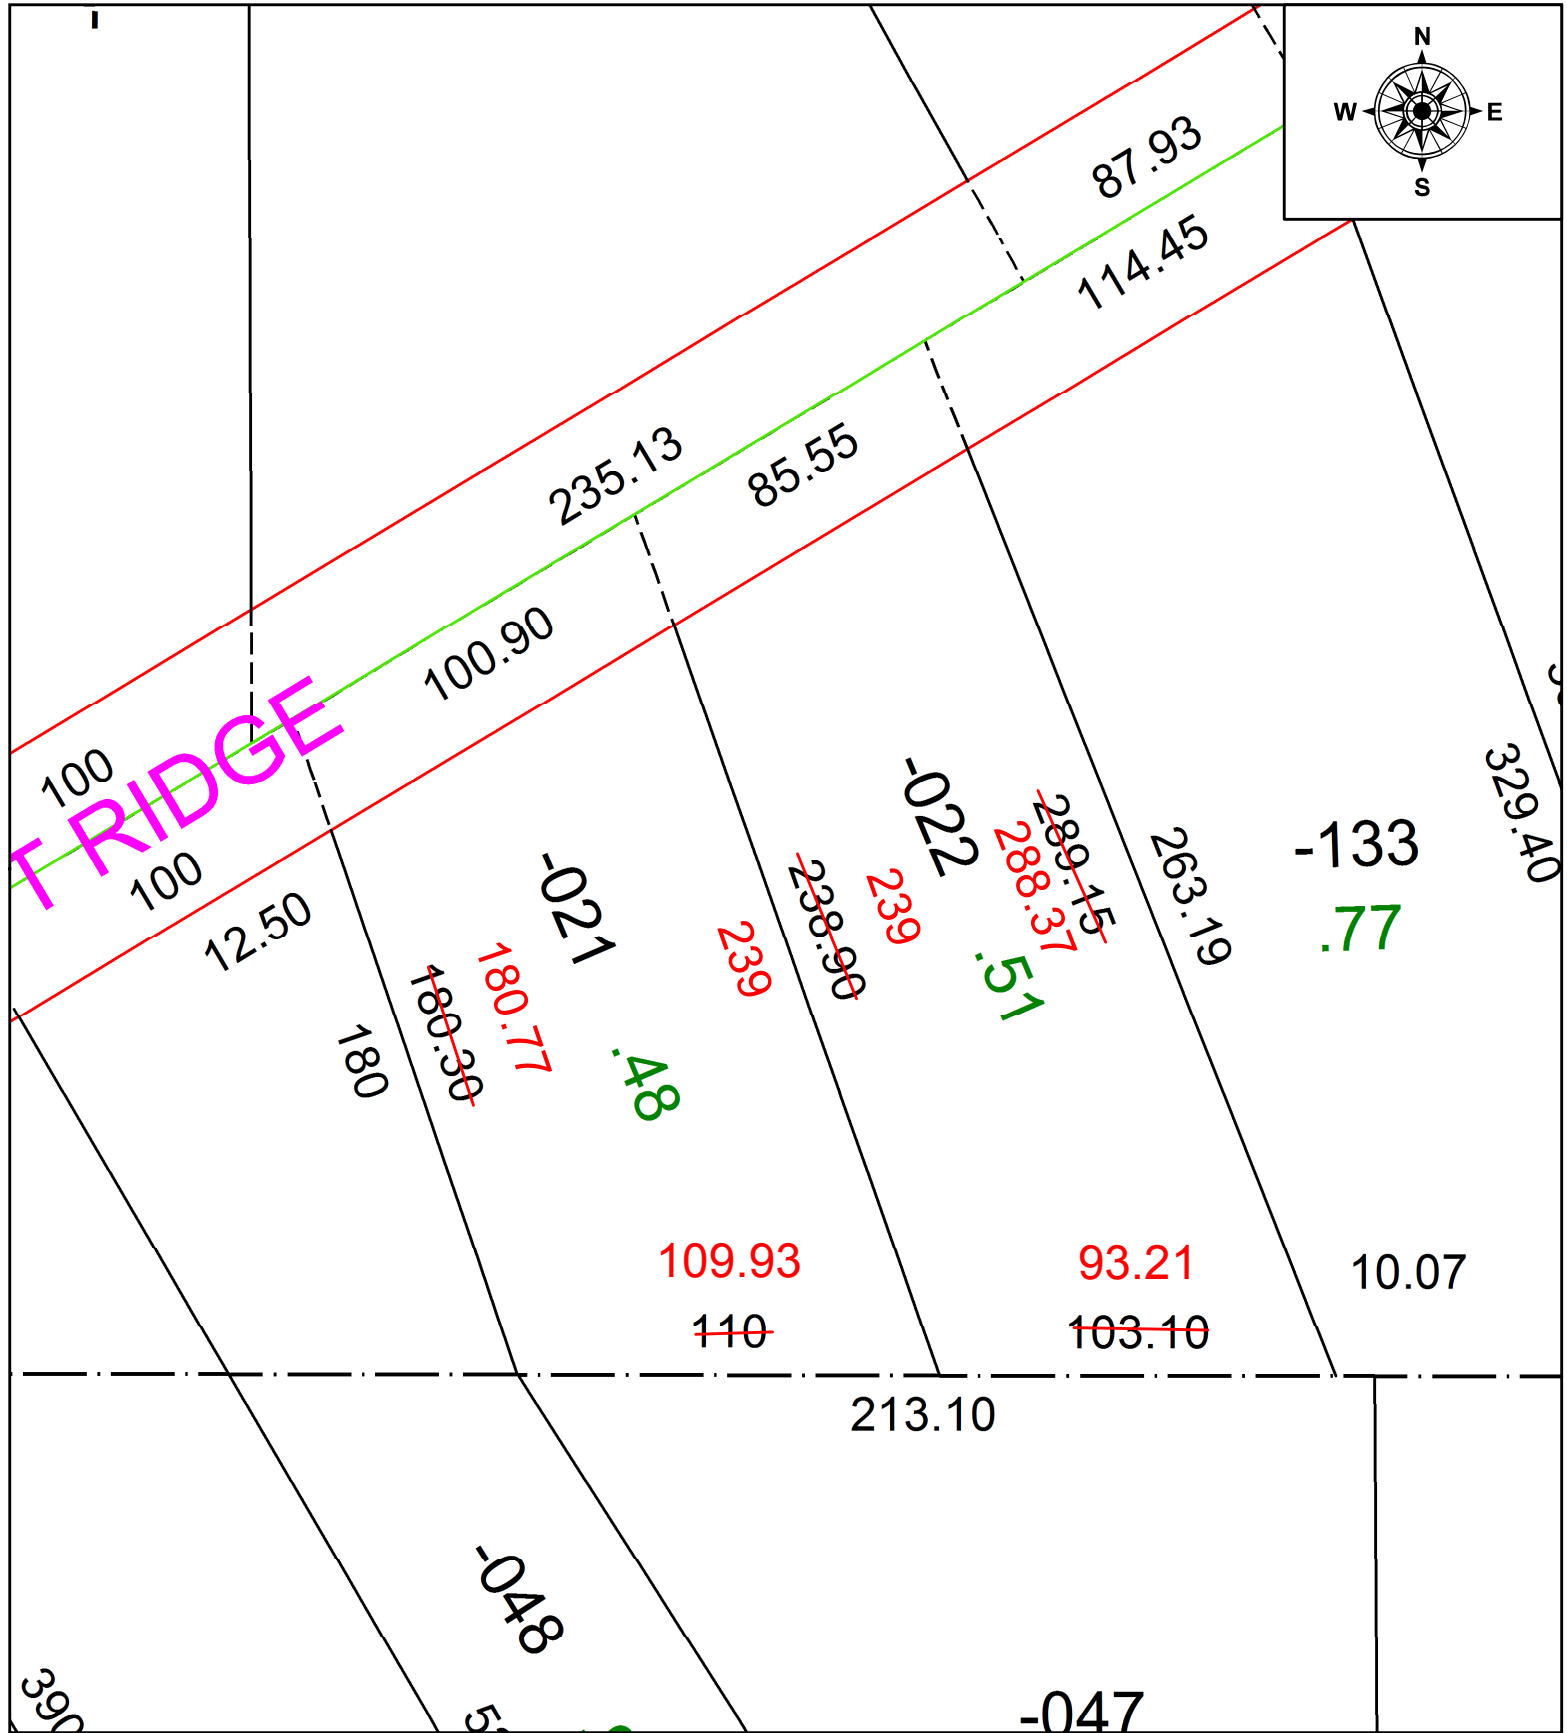

BUTTERNUT RIDGE

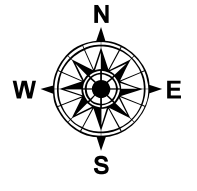

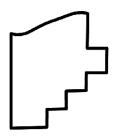 **SPLITS/DEEDS PROCESSED**
 LORAIN COUNTY TAX MAP DEPARTMENT
 226 MIDDLE AVE. ELYRIA, OH

SURVEYED BY: BRIAN SIEBENTHAL
 CLOSURE: 1: 140408
 MAP PAGE(S): 11-00-089
 APPROVED BY: AC DATE: 9/2/2021
 SCALE: 1" = 50 PRIOR INSTRUMENT: 2011- 0390122