
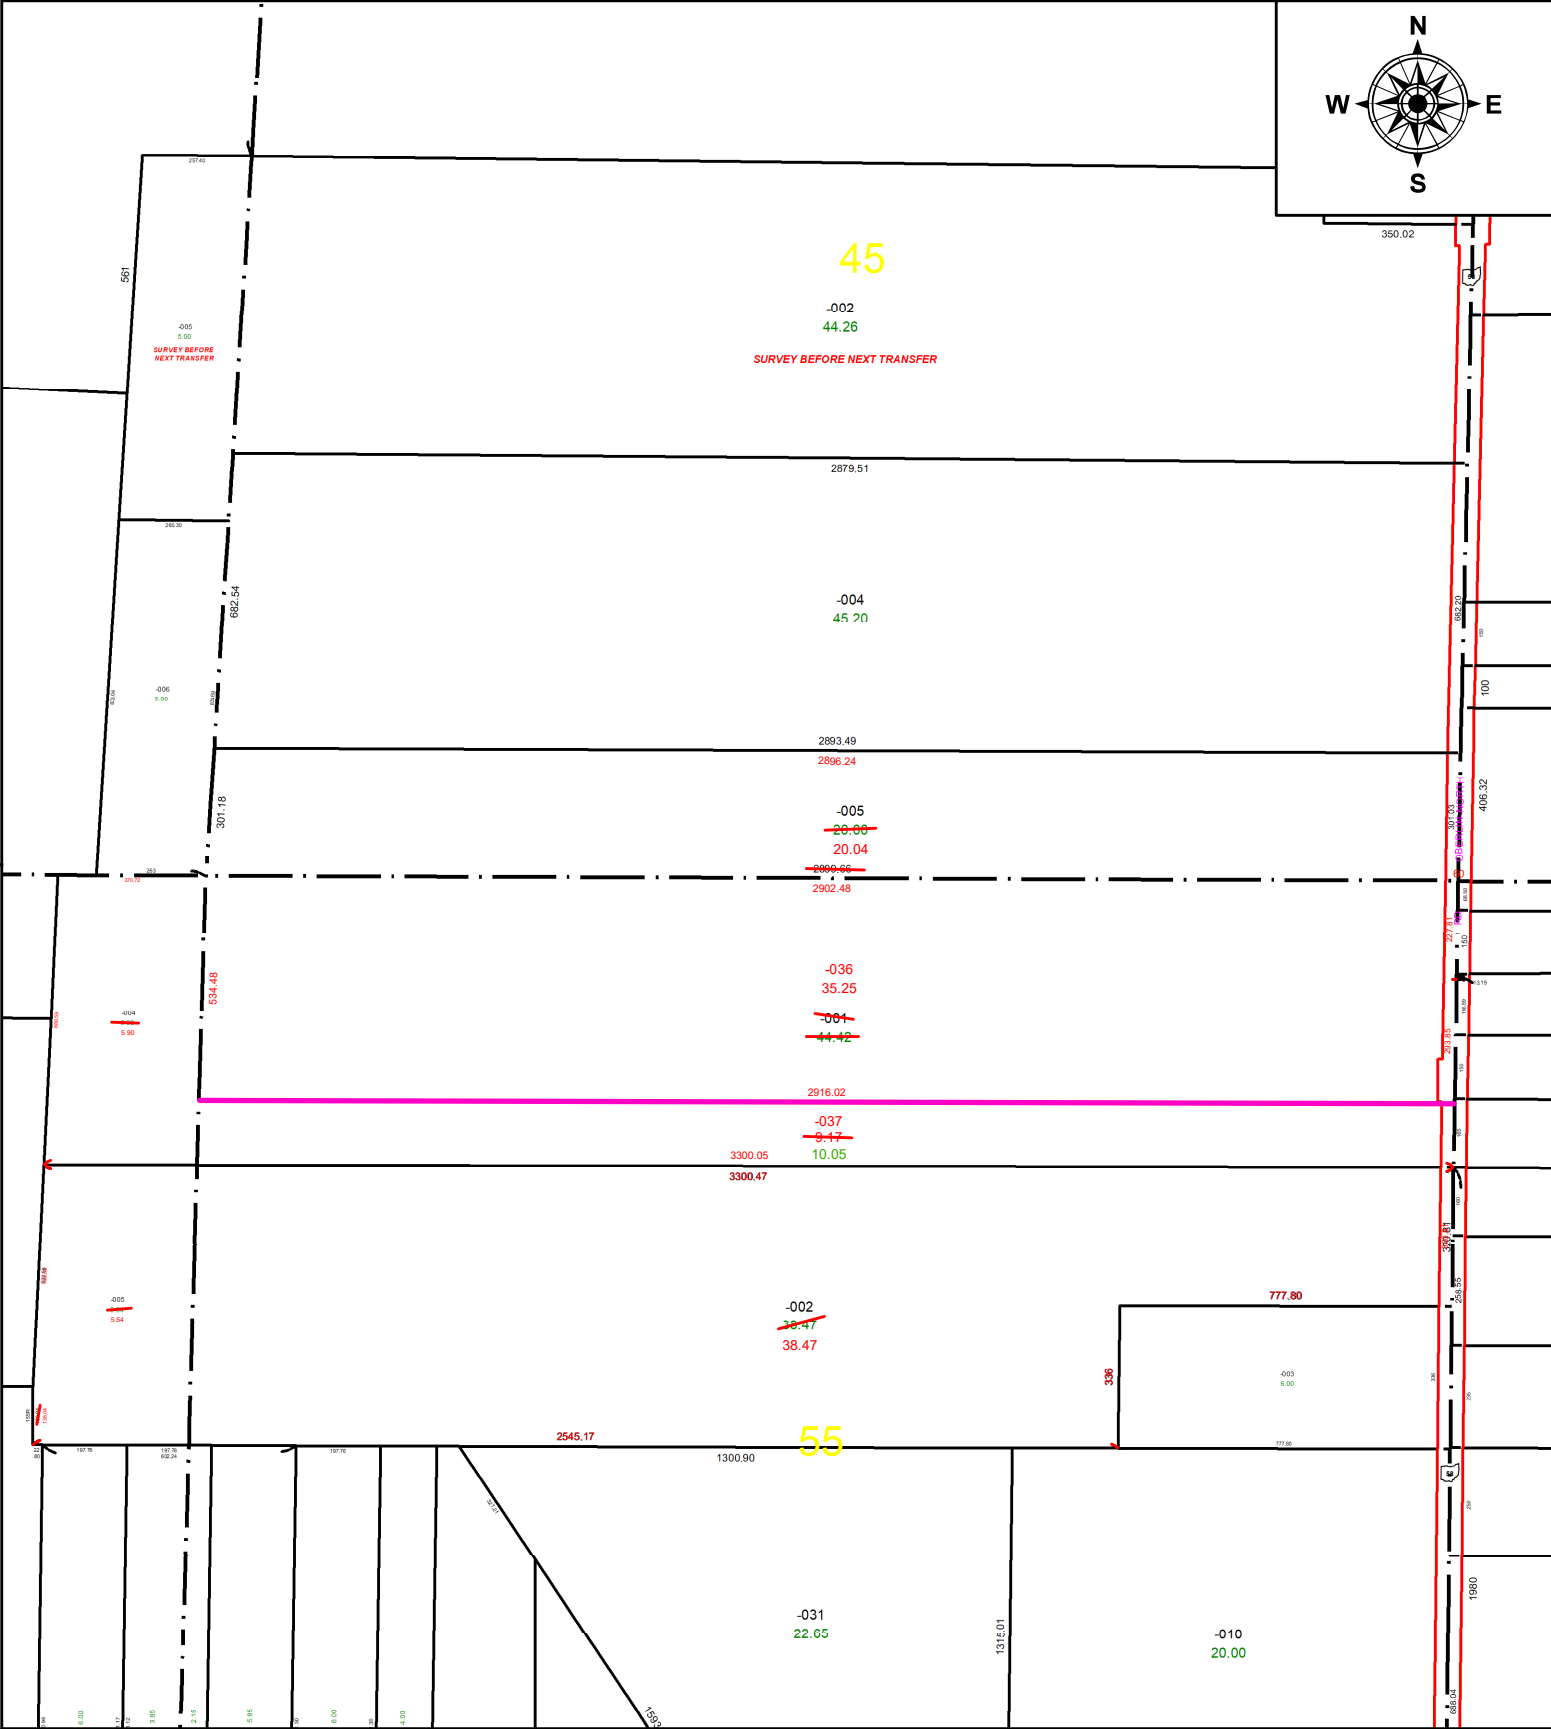


PARENT PARCEL: 09-00-045-000-005, 09-00-054-000-004 & 09-00-055-000-001

CHILD PARCEL: 09-00-055-000-036 & -037, 09-00-045-000-005 Str. Trns

STARTING POINT: CL OF S.R. 58 & BUTTERNUT RIDGE RD.

23-04652

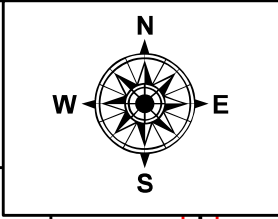

SPLITS/DEEDS PROCESSED
LORAIN COUNTY TAX MAP DEPARTMENT
226 MIDDLE AVE. ELYRIA, OH

SURVEYED BY: DANIEL CLIPSE SURVEY #: 50835
CLOSURE: 1:601900
MAP PAGE(S): 09-00-045, -054 & -055
APPROVED BY: DMA DATE: 3/8/2023
SCALE: 1" = 450' PRIOR INSTRUMENT: 1998-0520019