
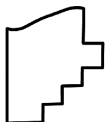
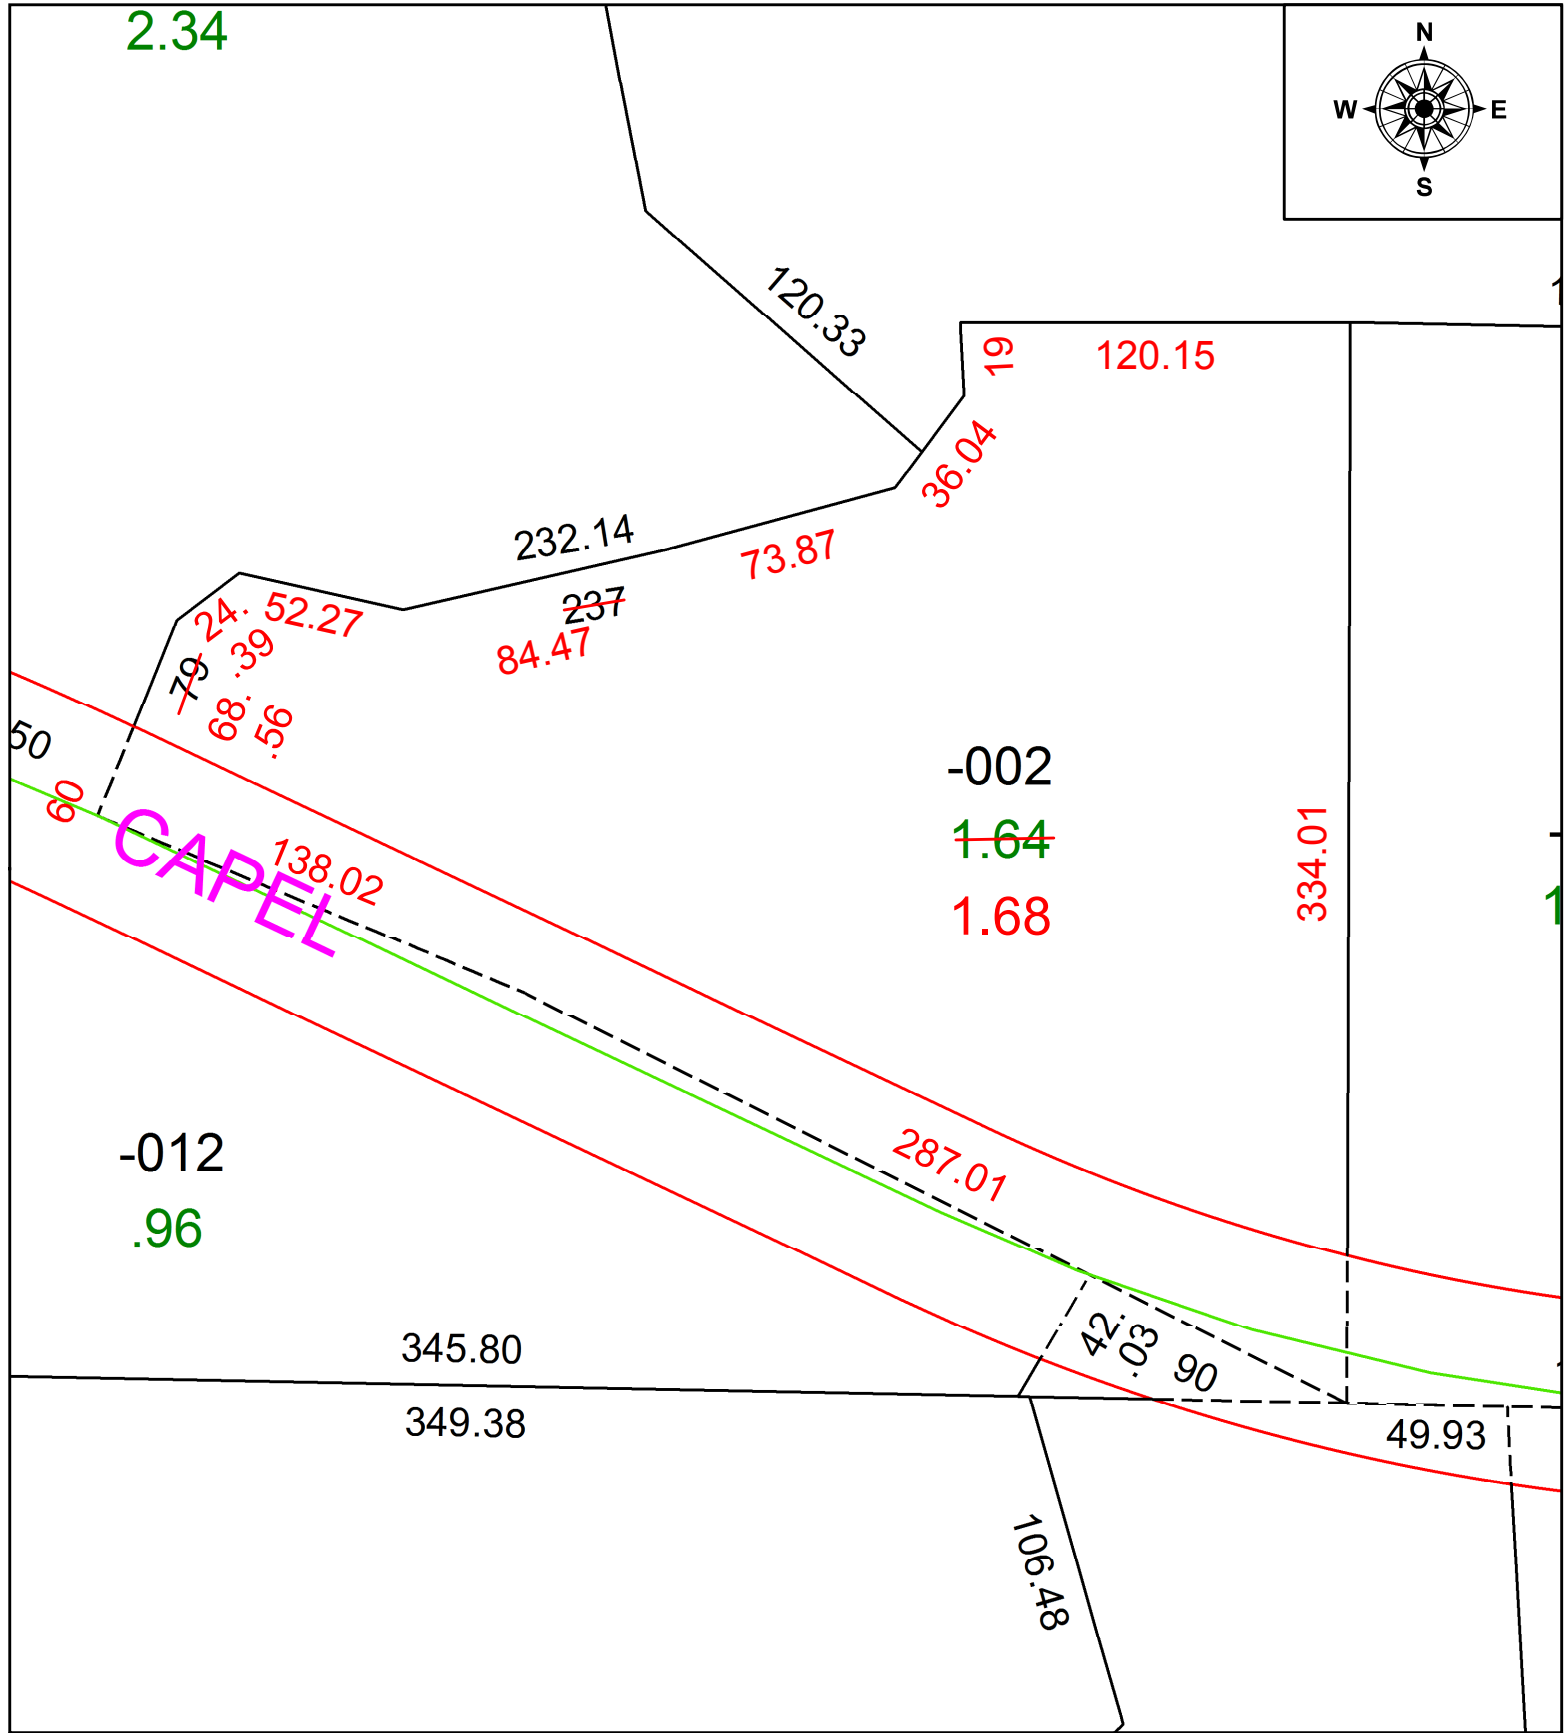


PARENT PARCEL: 11-00-084-000-002

CHILD PARCEL: **AC CORR PER SURV BY JOHN A. DECHANT JR.**

STARTING POINT: C/L OF OL 84 AND CAPEL RD

21-04654-D

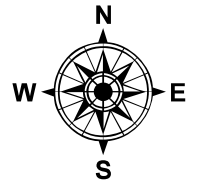

SPLITS/DEEDS PROCESSED
LORAIN COUNTY TAX MAP DEPARTMENT
226 MIDDLE AVE. ELYRIA, OH

SURVEYED BY: JOHN A. DECHANT JR.
CLOSURE: 1: 139568
MAP PAGE(S): 11-00-084
APPROVED BY: AC DATE: 9/7/2021
SCALE: 1" = 60 PRIOR INSTRUMENT: 2015-0551701