


PARENT PARCEL: 01-00-004-116-001

CHILD PARCEL: 01-00-004-116-002 & -003

STARTING POINT: 5/8" I.P. FD. S.W. CORNER OF SUNNYSIDE BEACH SUB. & SOUTH LINE OF O.L. 4

23-04654

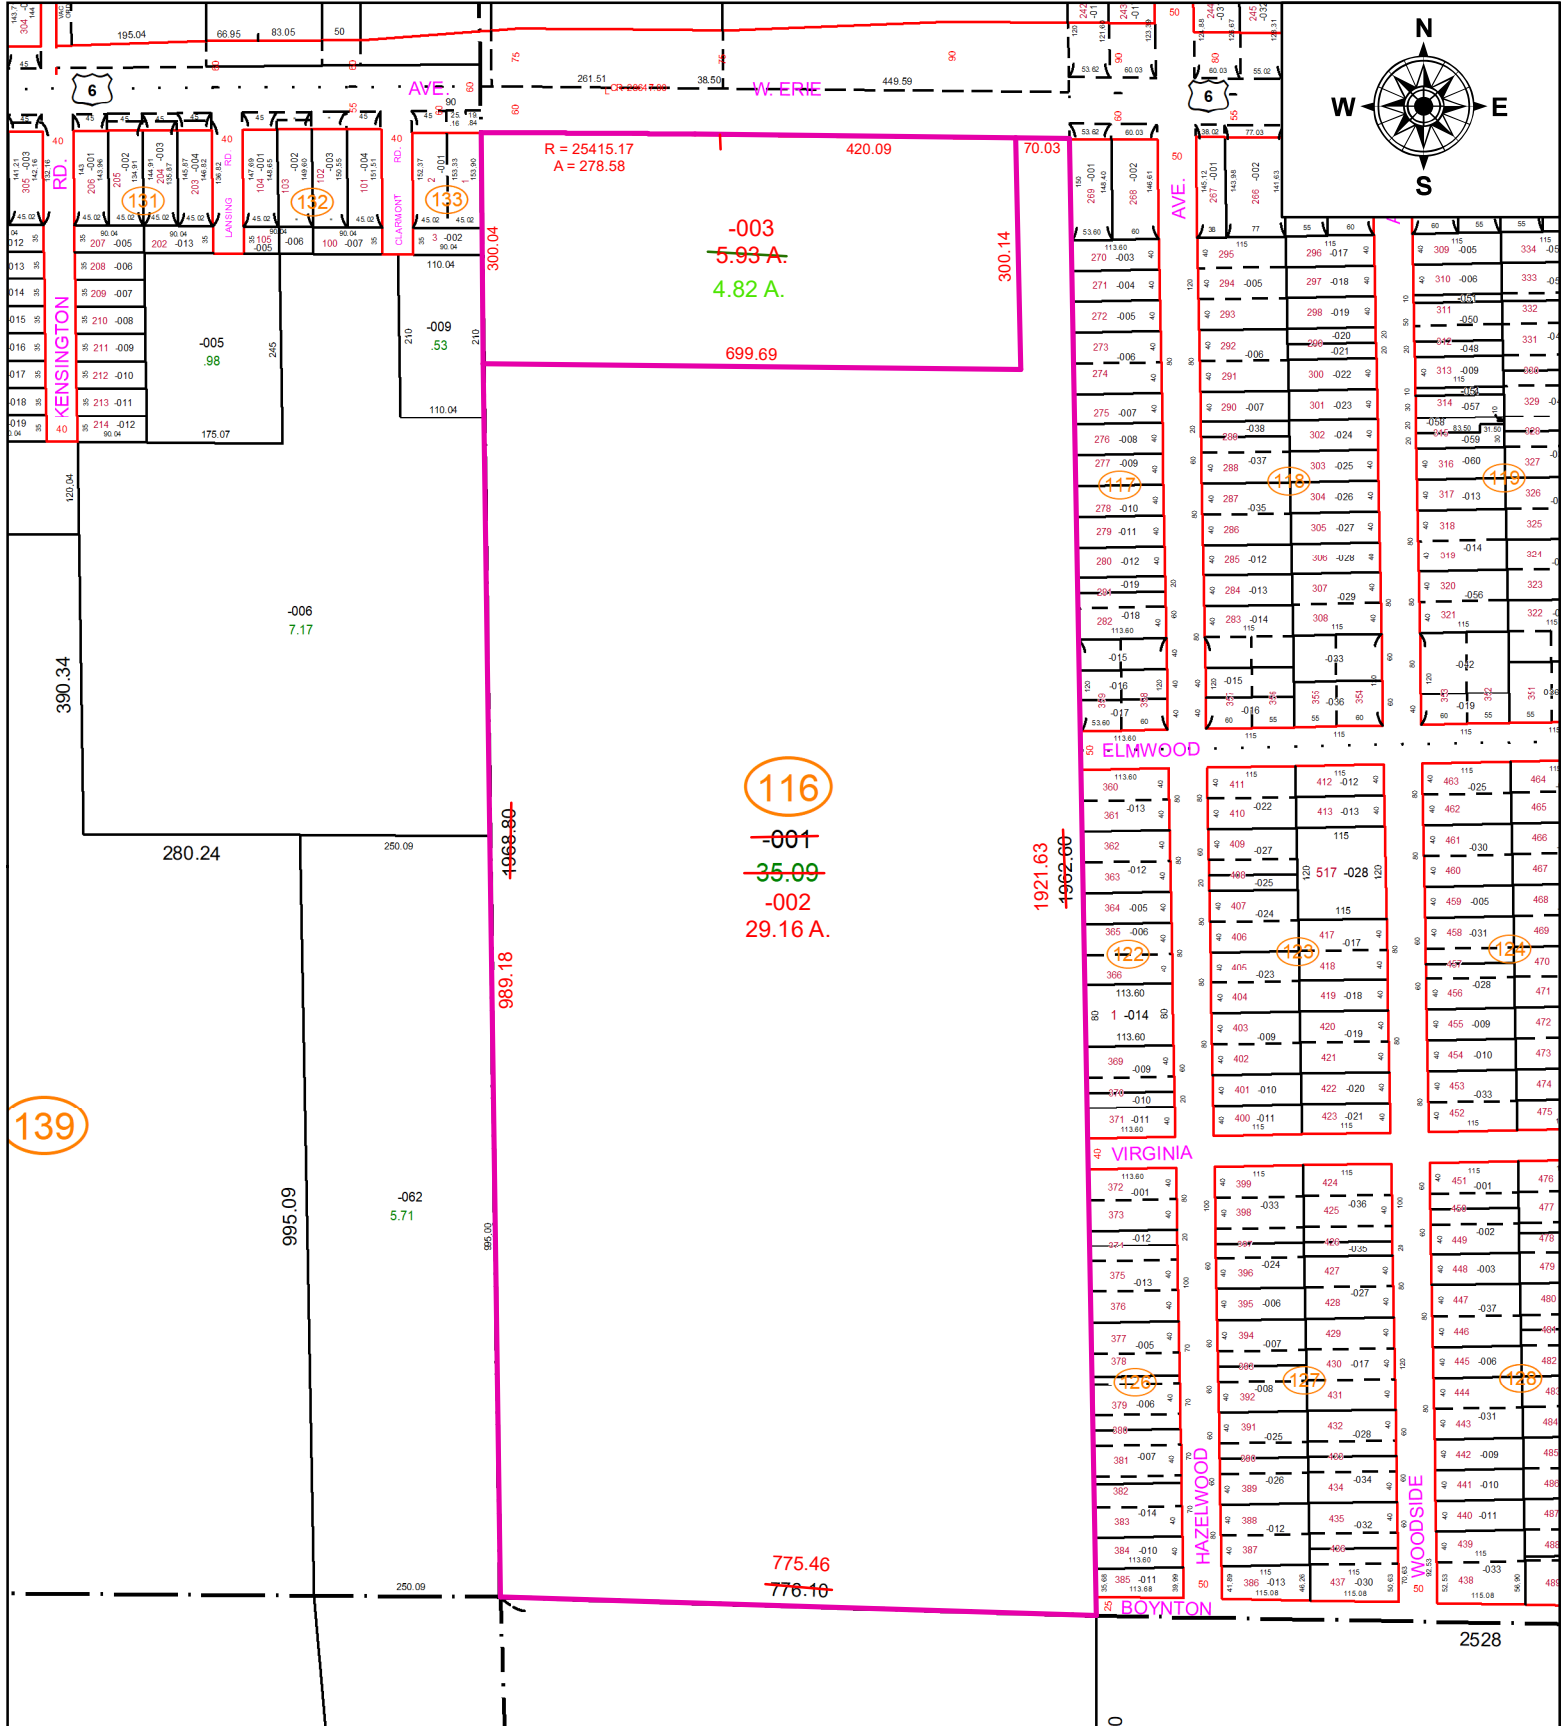

**SPLITS/DEEDS PROCESSED**  
 LORAIN COUNTY TAX MAP DEPARTMENT  
 226 MIDDLE AVE. ELYRIA, OH

**SURVEYED BY:** NATHAN W. SAUTTER  
**CLOSURE:** 1:1905271  
**MAP PAGE(S):** 1-00-004  
**APPROVED BY:** TJS **DATE:** 3/14/2023  
**SCALE:** 1" = 250' **PRIOR INSTRUMENT:** OR 518/211