


PARENT PARCEL: 05-00-091-106-004, -012, 05-00-091-105-008, 09-00-002-000-002, -003, -008, -009, 09-00-001-102-022

CHILD PARCEL: 05-00-091-106-013, 09-00-002-000-057 ST:05-00-091-106-004, -012, 05-00-091-105-008, 09-00-001-102-022

23-04658

STARTING POINT: AC CORR PER SURV BY THOMAS A. SIMON

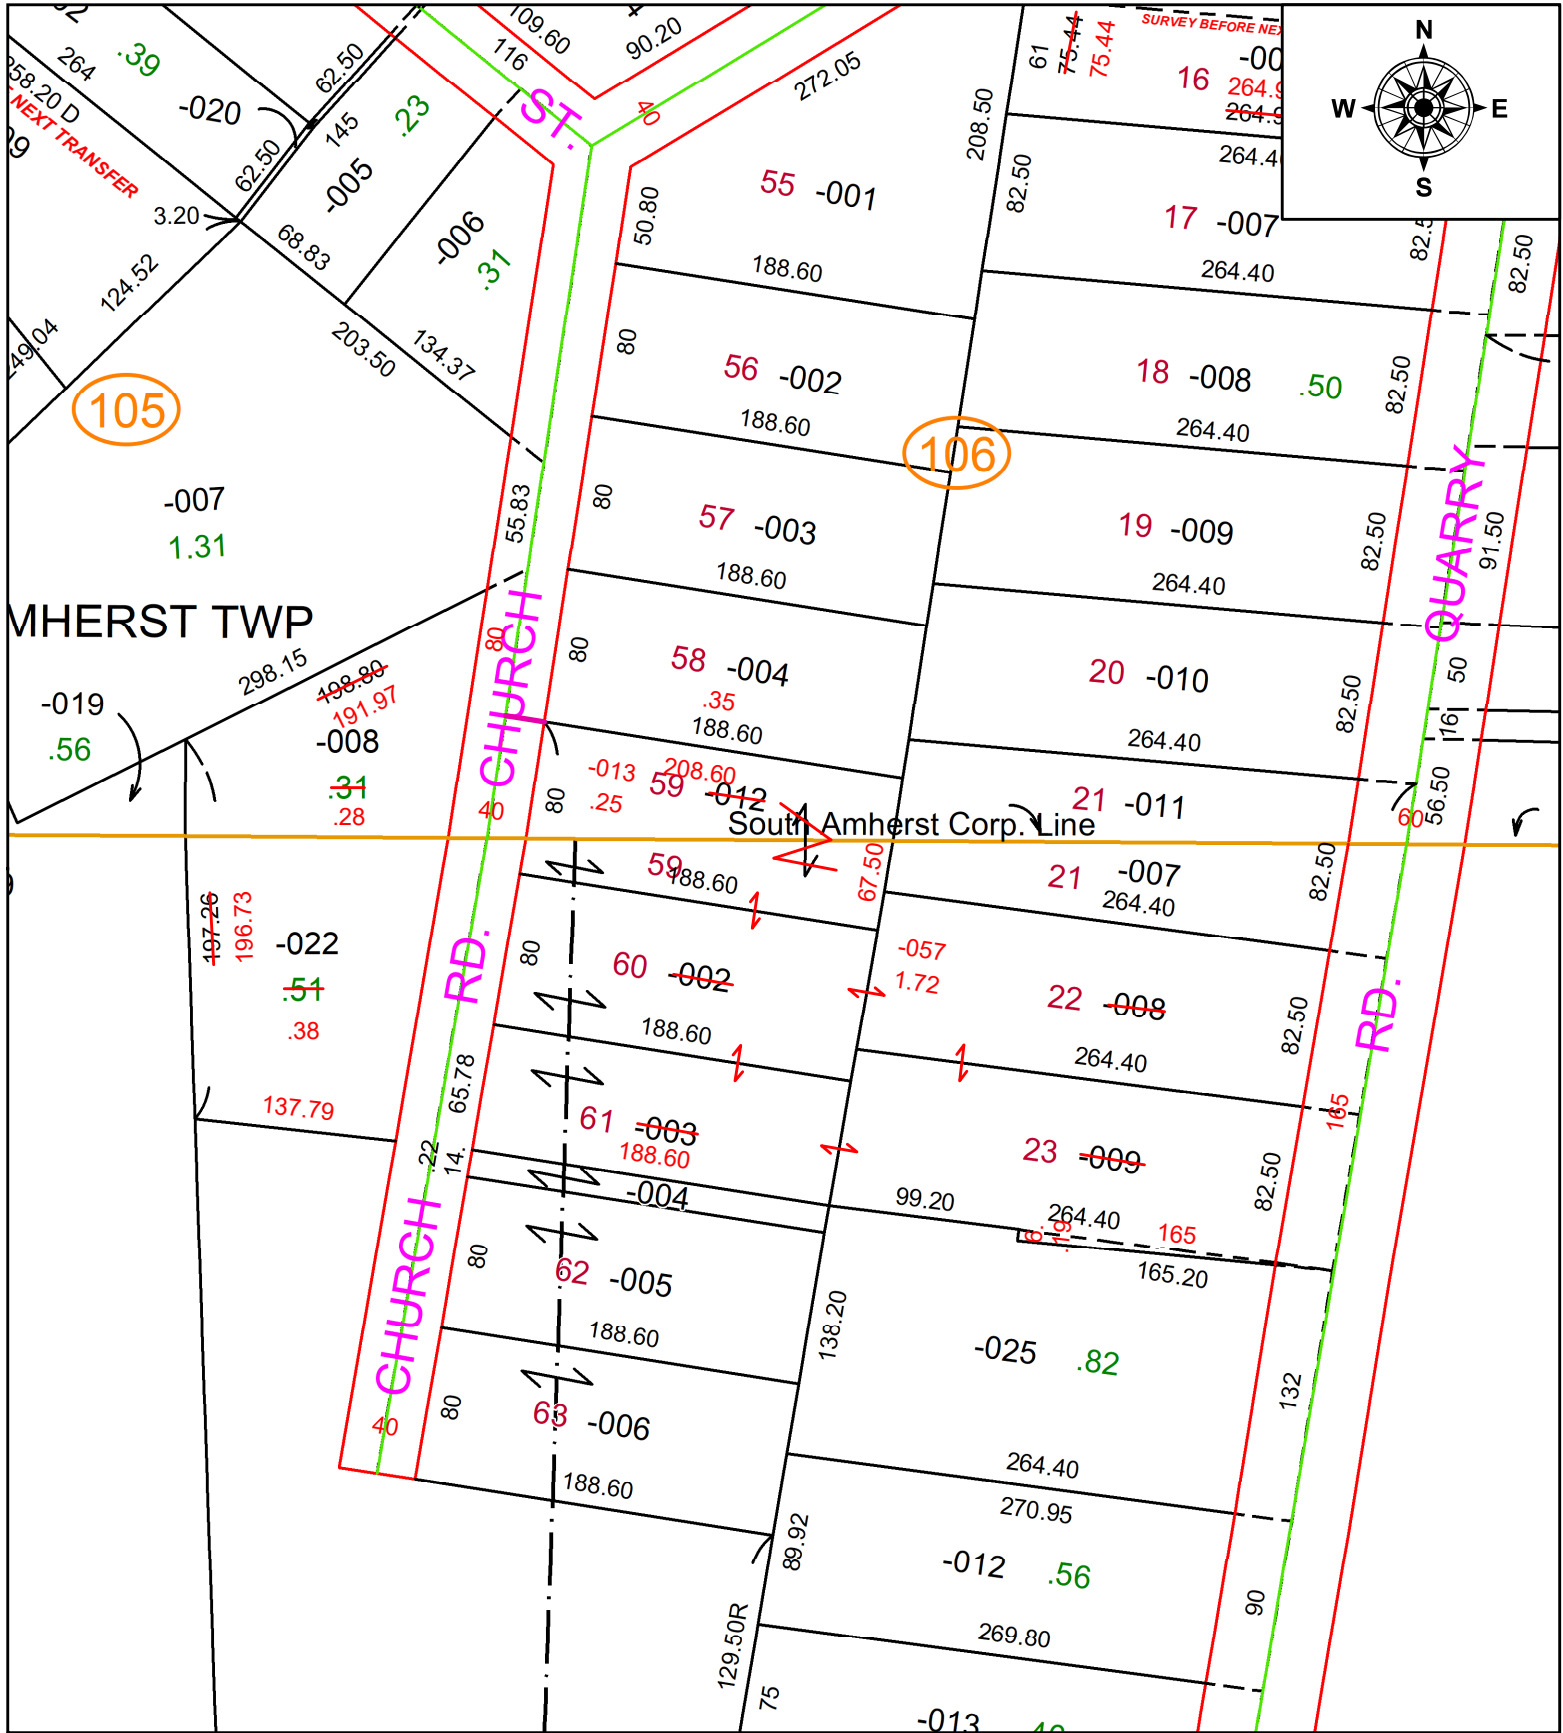

**SPLITS/DEEDS PROCESSED**  
 LORAIN COUNTY TAX MAP DEPARTMENT  
 226 MIDDLE AVE. ELYRIA, OH

**SURVEYED BY:** THOMAS A. SIMON **SURV #** 50840  
**CLOSURE:** 1: 100789  
**MAP PAGE(S):** 05-00-091-B  
**APPROVED BY:** AC **DATE:** March 20, 2023  
**SCALE:** 1 in = 100 ft **PRIOR INSTRUMENT:** 2000- 0722037