

PARENT PARCEL:

01-00-005-102-033

CHILD PARCEL:



01-00-005-102-038 & -039

N/A

23-04659

STARTING POINT:

INTERSECTION OF WESTERLY LINE OF O.L. 5 & FORMER C/L OF LIBERTY AVE

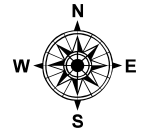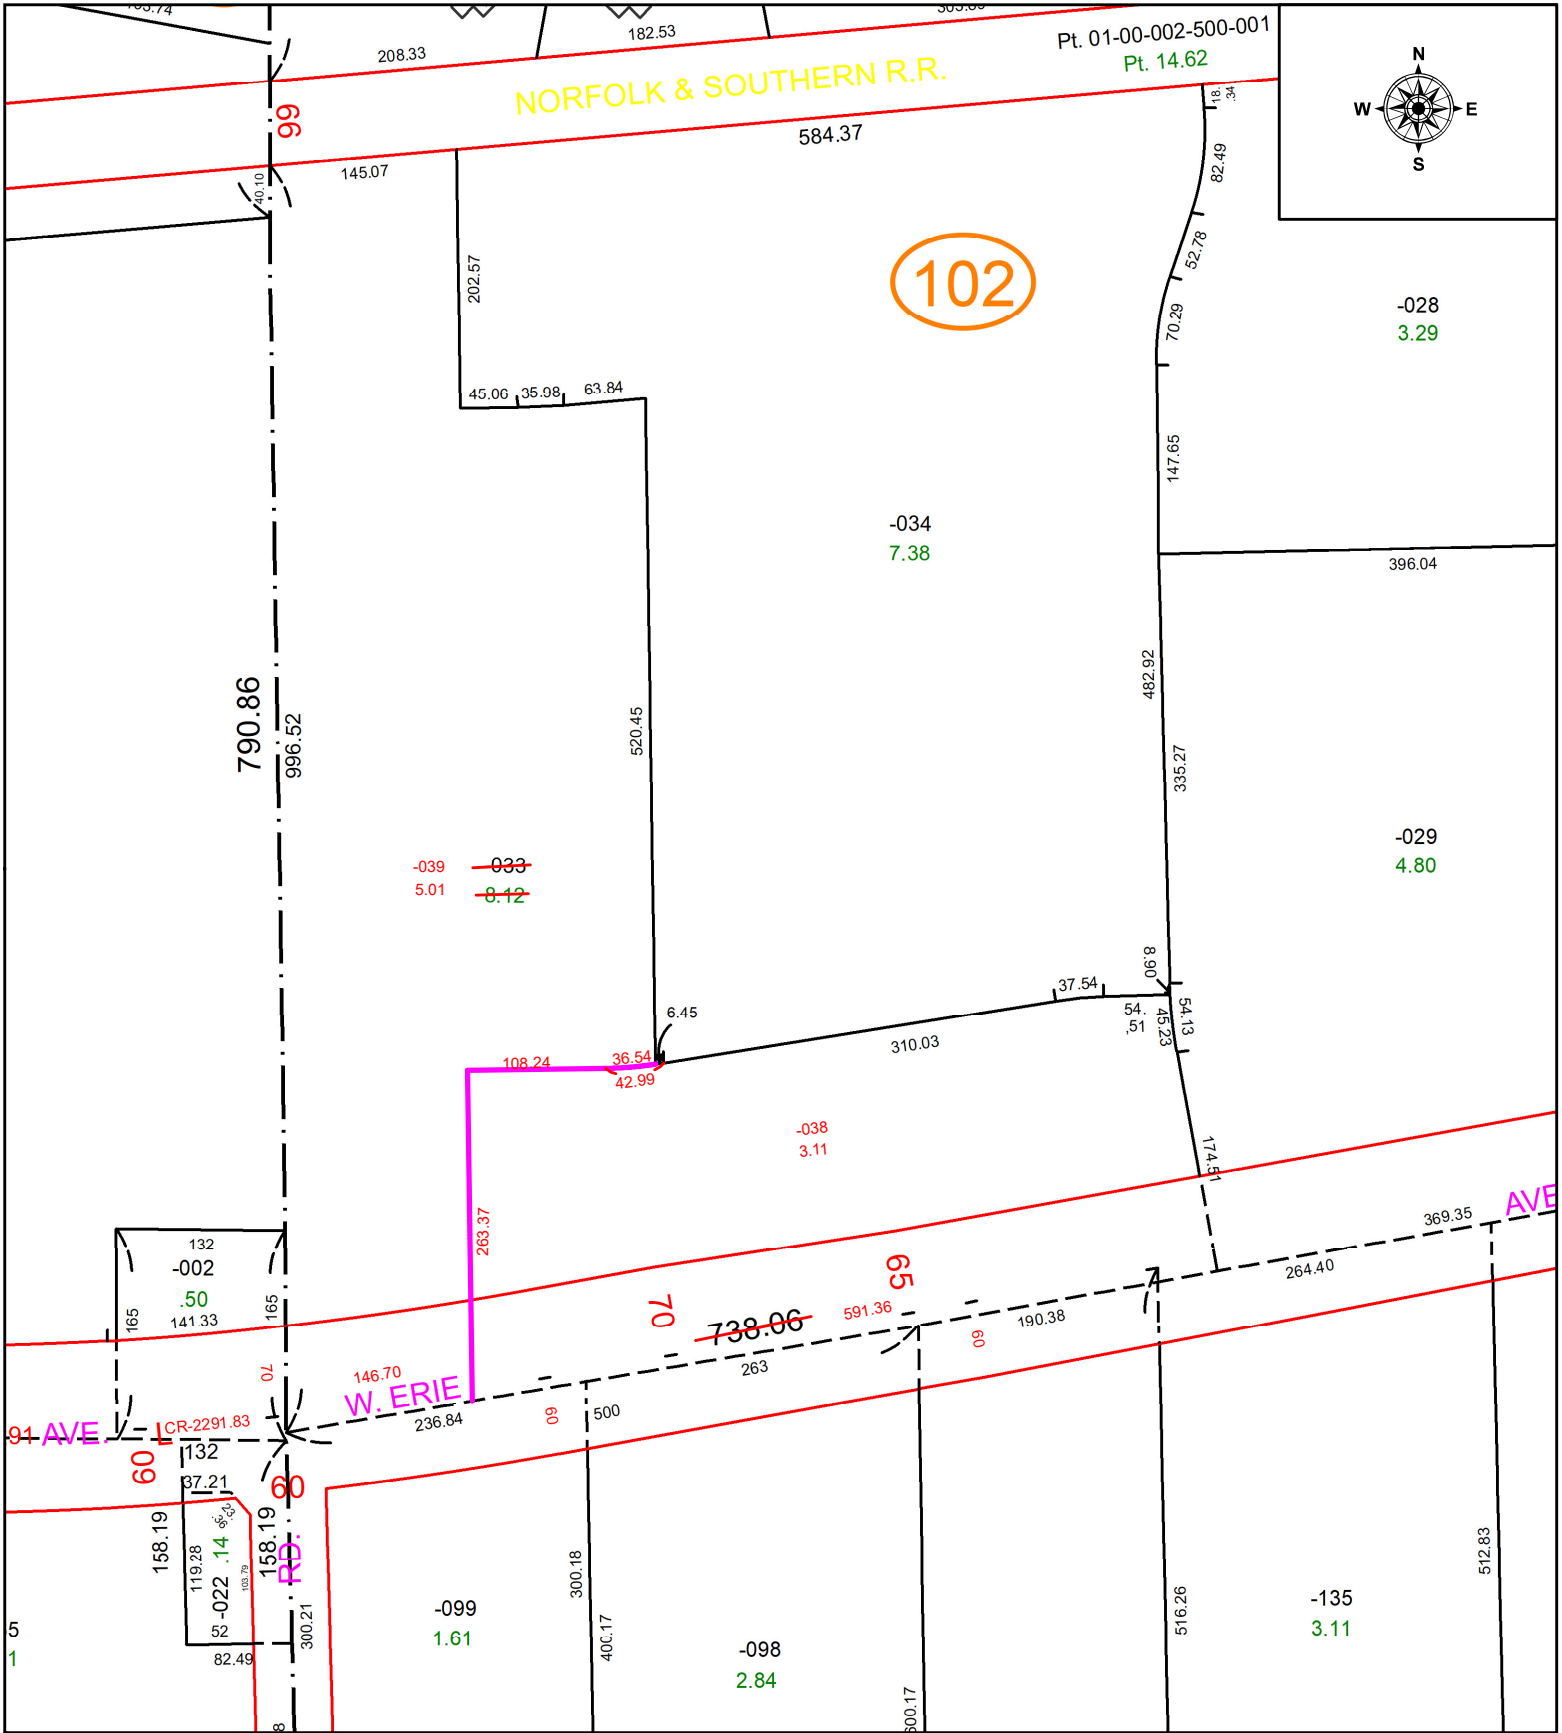

102

~~-039~~ 5.01
~~0.33~~ 8.12

-038
3.11


-028
3.29

-029
4.80

-099
1.61

-098
2.84

-135
3.11

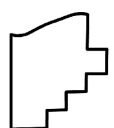

SPLITS/DEEDS PROCESSED
LORAIN COUNTY TAX MAP DEPARTMENT
226 MIDDLE AVE. ELYRIA, OH

SURVEYED BY: BRENT ANDERSON	SURVEY # 50841
CLOSURE: 1: 293348	
MAP PAGE(S): 01-00-005	
APPROVED BY: WRZ	DATE: 3/21/2023
SCALE: 1" = 150	PRIOR INSTRUMENT: #2019-0738925