
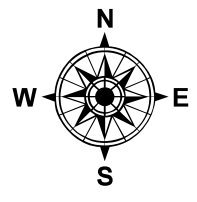


PARENT PARCEL: 15-00-099-101-212, -213

CHILD PARCEL: 15-00-099-101-241, -242, & -243

STARTING POINT: AC CORR PER SURV BY RICHARD A. FREDRICKSON

23-04660

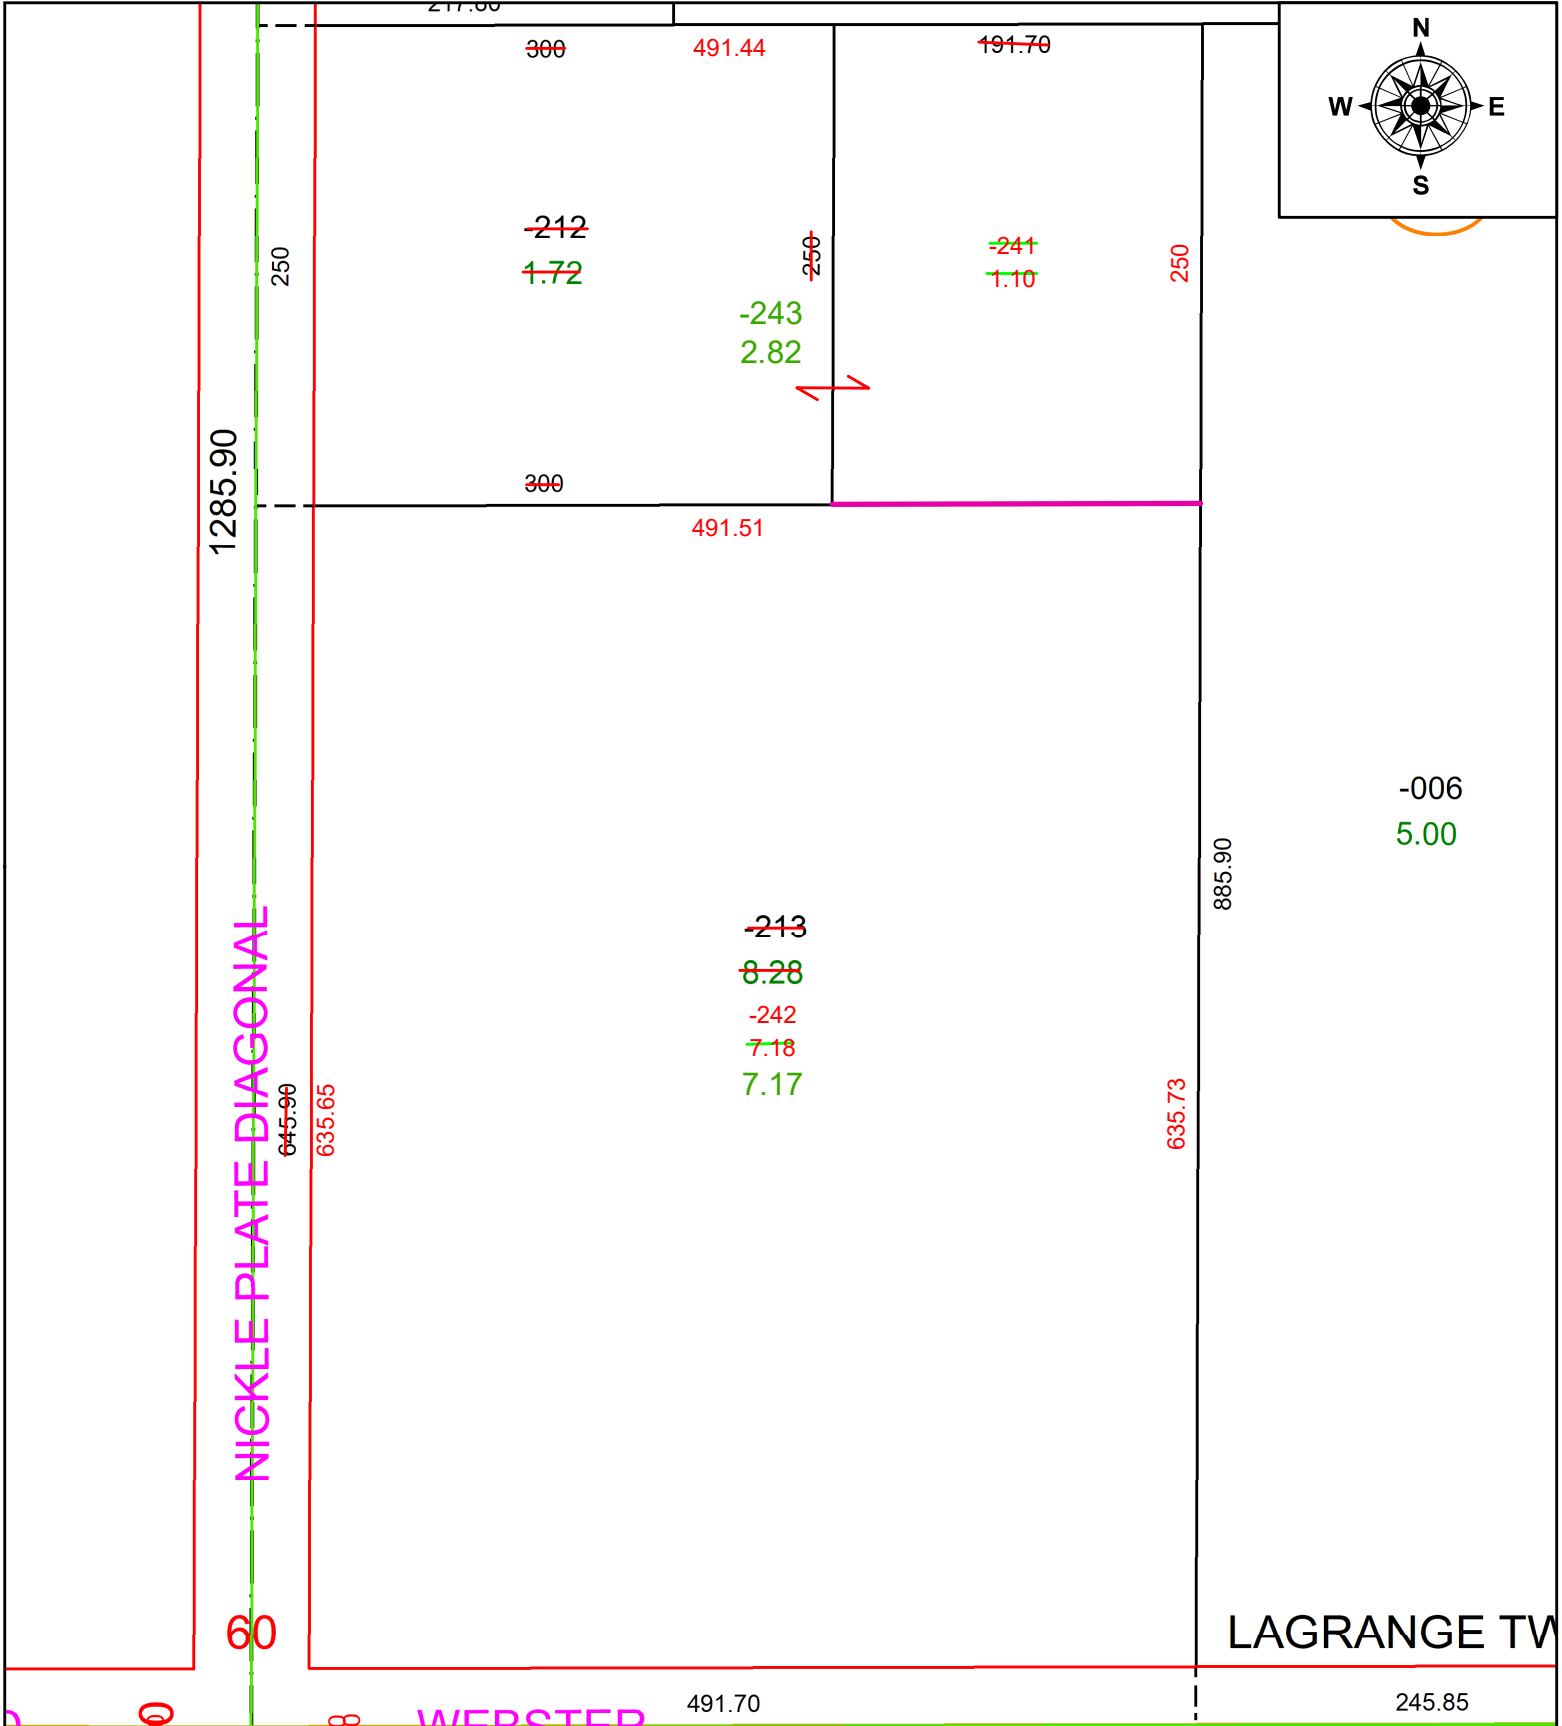

1285.90

NICKLE PLATE DIAGONAL

645.90
635.65

60

217.80

300 491.44

~~-212~~
1.72

~~-250~~
-243
2.82

300

491.51

~~-213~~
~~8.28~~
-242
7.18
7.17

191.70

~~-241~~
1.10

250

635.73

885.90


-006
5.00

491.70

245.85

LAGRANGE TWP

WEBSTER

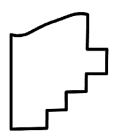

SPLITS/DEEDS PROCESSED
 LORAIN COUNTY TAX MAP DEPARTMENT
 226 MIDDLE AVE. ELYRIA, OH

SURVEYED BY:	RICHARD A. FREDRICKSON	SURV #	50842
CLOSURE:	1: 222434		
MAP PAGE(S):	15-00-099-A		
APPROVED BY:	AC	DATE:	March 21, 2023
SCALE:	1 in = 100 ft	PRIOR INSTRUMENT:	2020- 0792907