
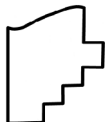
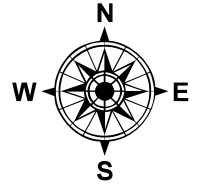


PARENT PARCEL: ADD TO DUPLICATE

CHILD PARCEL: 14-00-096-000-056 PER DV. 83 PG. 347

STARTING POINT: CL OF S.R. 58 & S.W. CORNER OF GEORGE WAITE

21-04665-A

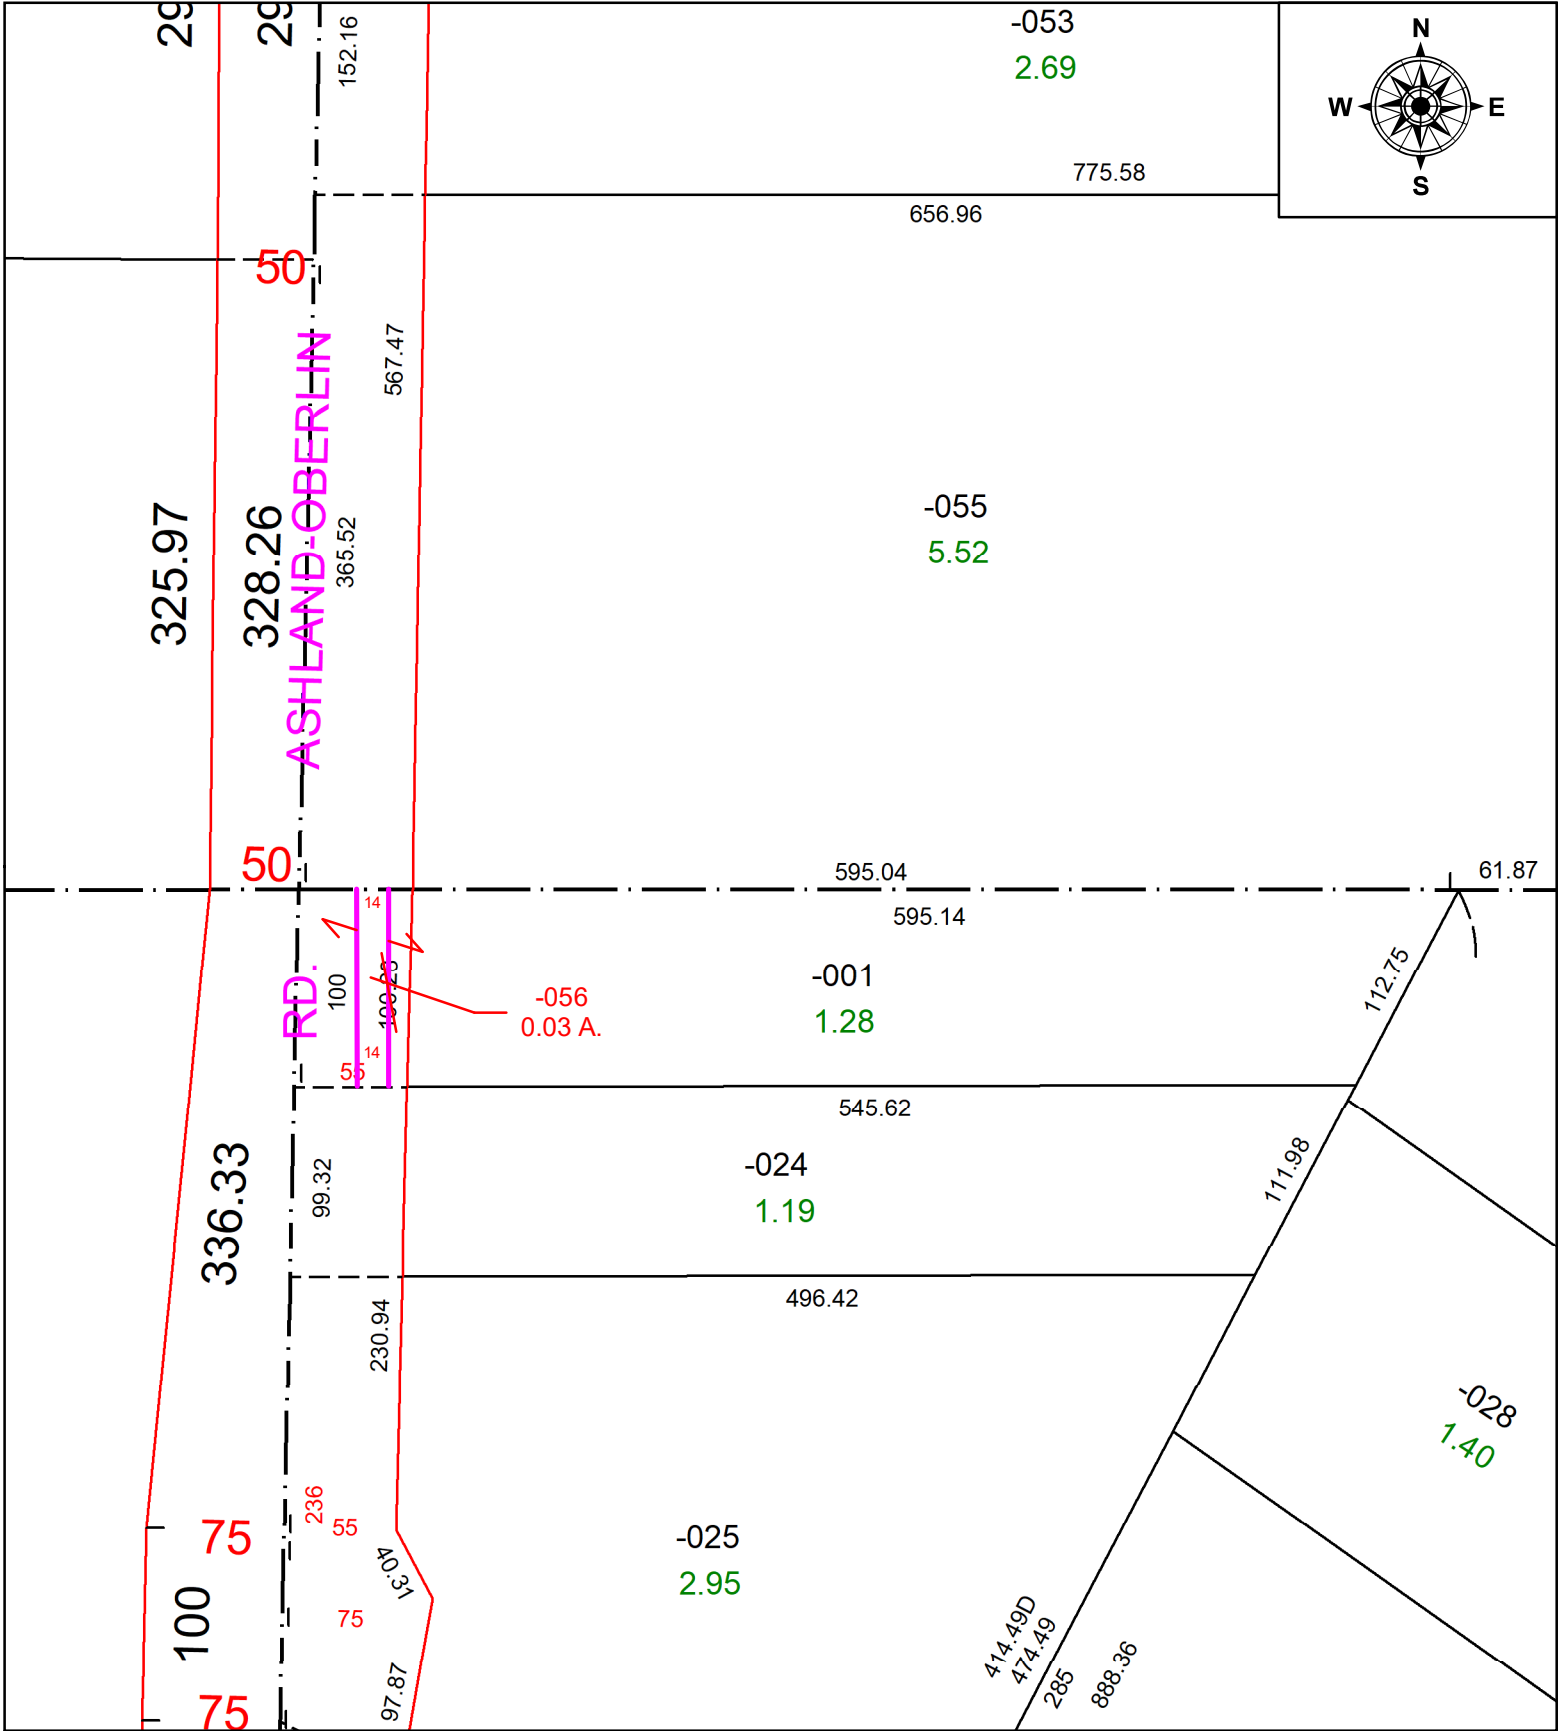

SPLITS/DEEDS PROCESSED
 LORAIN COUNTY TAX MAP DEPARTMENT
 226 MIDDLE AVE. ELYRIA, OH

SURVEYED BY: GARY PENFOUND
CLOSURE: 1: 33,000
MAP PAGE(S): 14-00-096
APPROVED BY: TJS **DATE:** 3/14/2022
SCALE: 1" = 100' **PRIOR INSTRUMENT:** 2017-0625710