
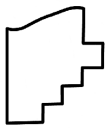


PARENT PARCEL: 07-00-023-102-044 & -066

CHILD PARCEL: **07-00-023-102-072--COMBINATION**

STARTING POINT: CL OF CLEAR CREEK DR. & CHESTNUT RIDGE RD.

23-04665

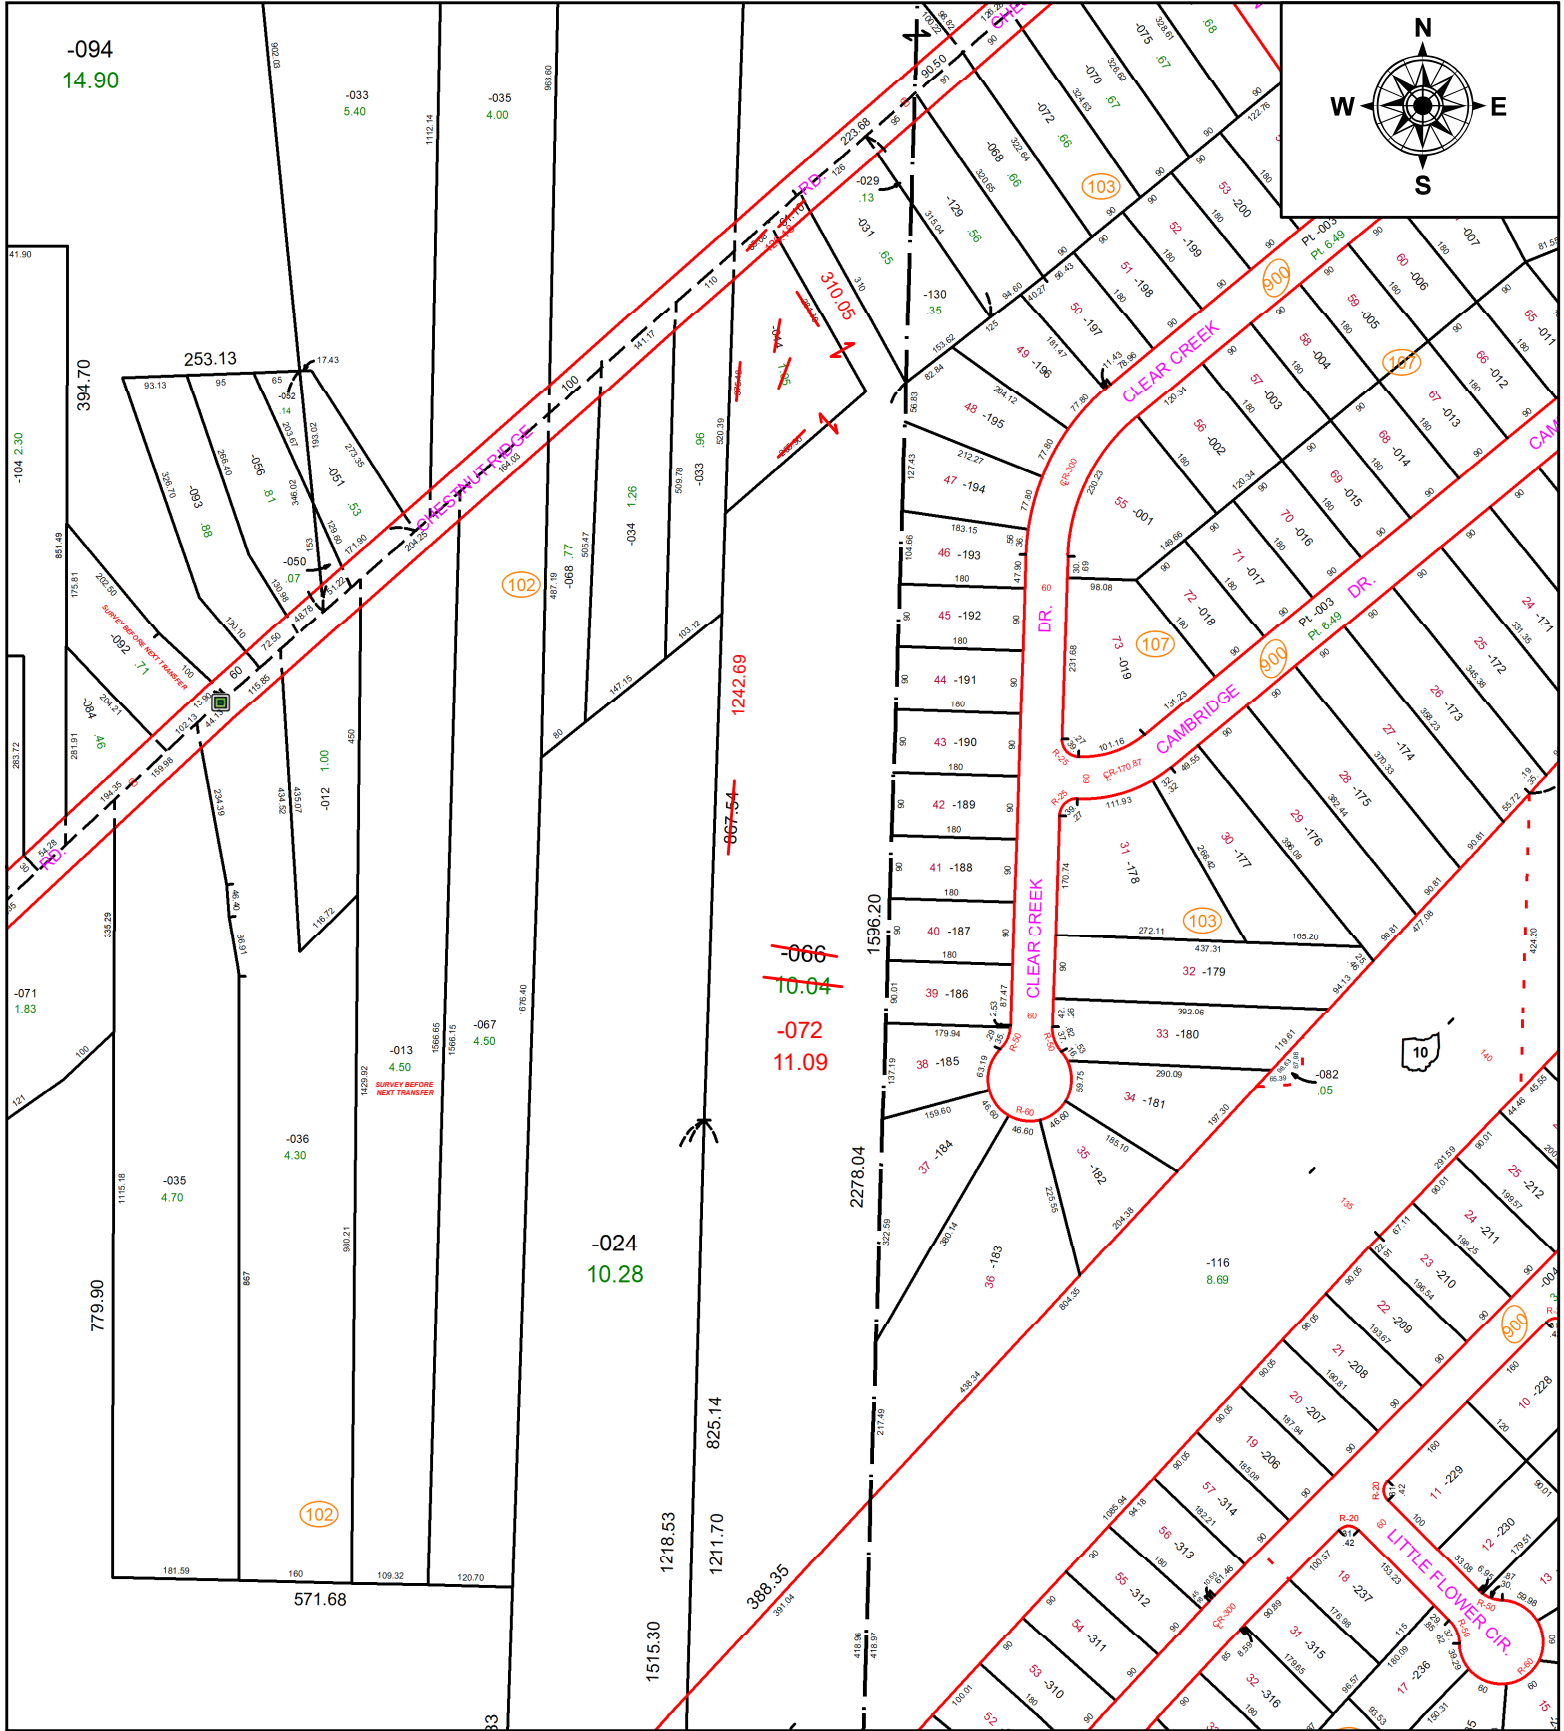

SPLITS/DEEDS PROCESSED
 LORAIN COUNTY TAX MAP DEPARTMENT
 226 MIDDLE AVE. ELYRIA, OH

SURVEYED BY: WILFREDO BARBOSA **SURVEY #:** 50847
CLOSURE: 1:1165396
MAP PAGE(S): 07-00-023
APPROVED BY: DMA **DATE:** 3/24/2023
SCALE: 1" = 275' **PRIOR INSTRUMENT:** 2022-0890519