
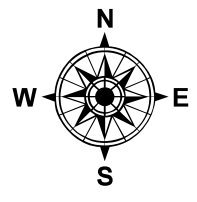


PARENT PARCEL: 05-00-035-105-013

CHILD PARCEL: 05-00-035-105-190 & -191

STARTING POINT: STATION P.I. 1180+90.93

23-04666

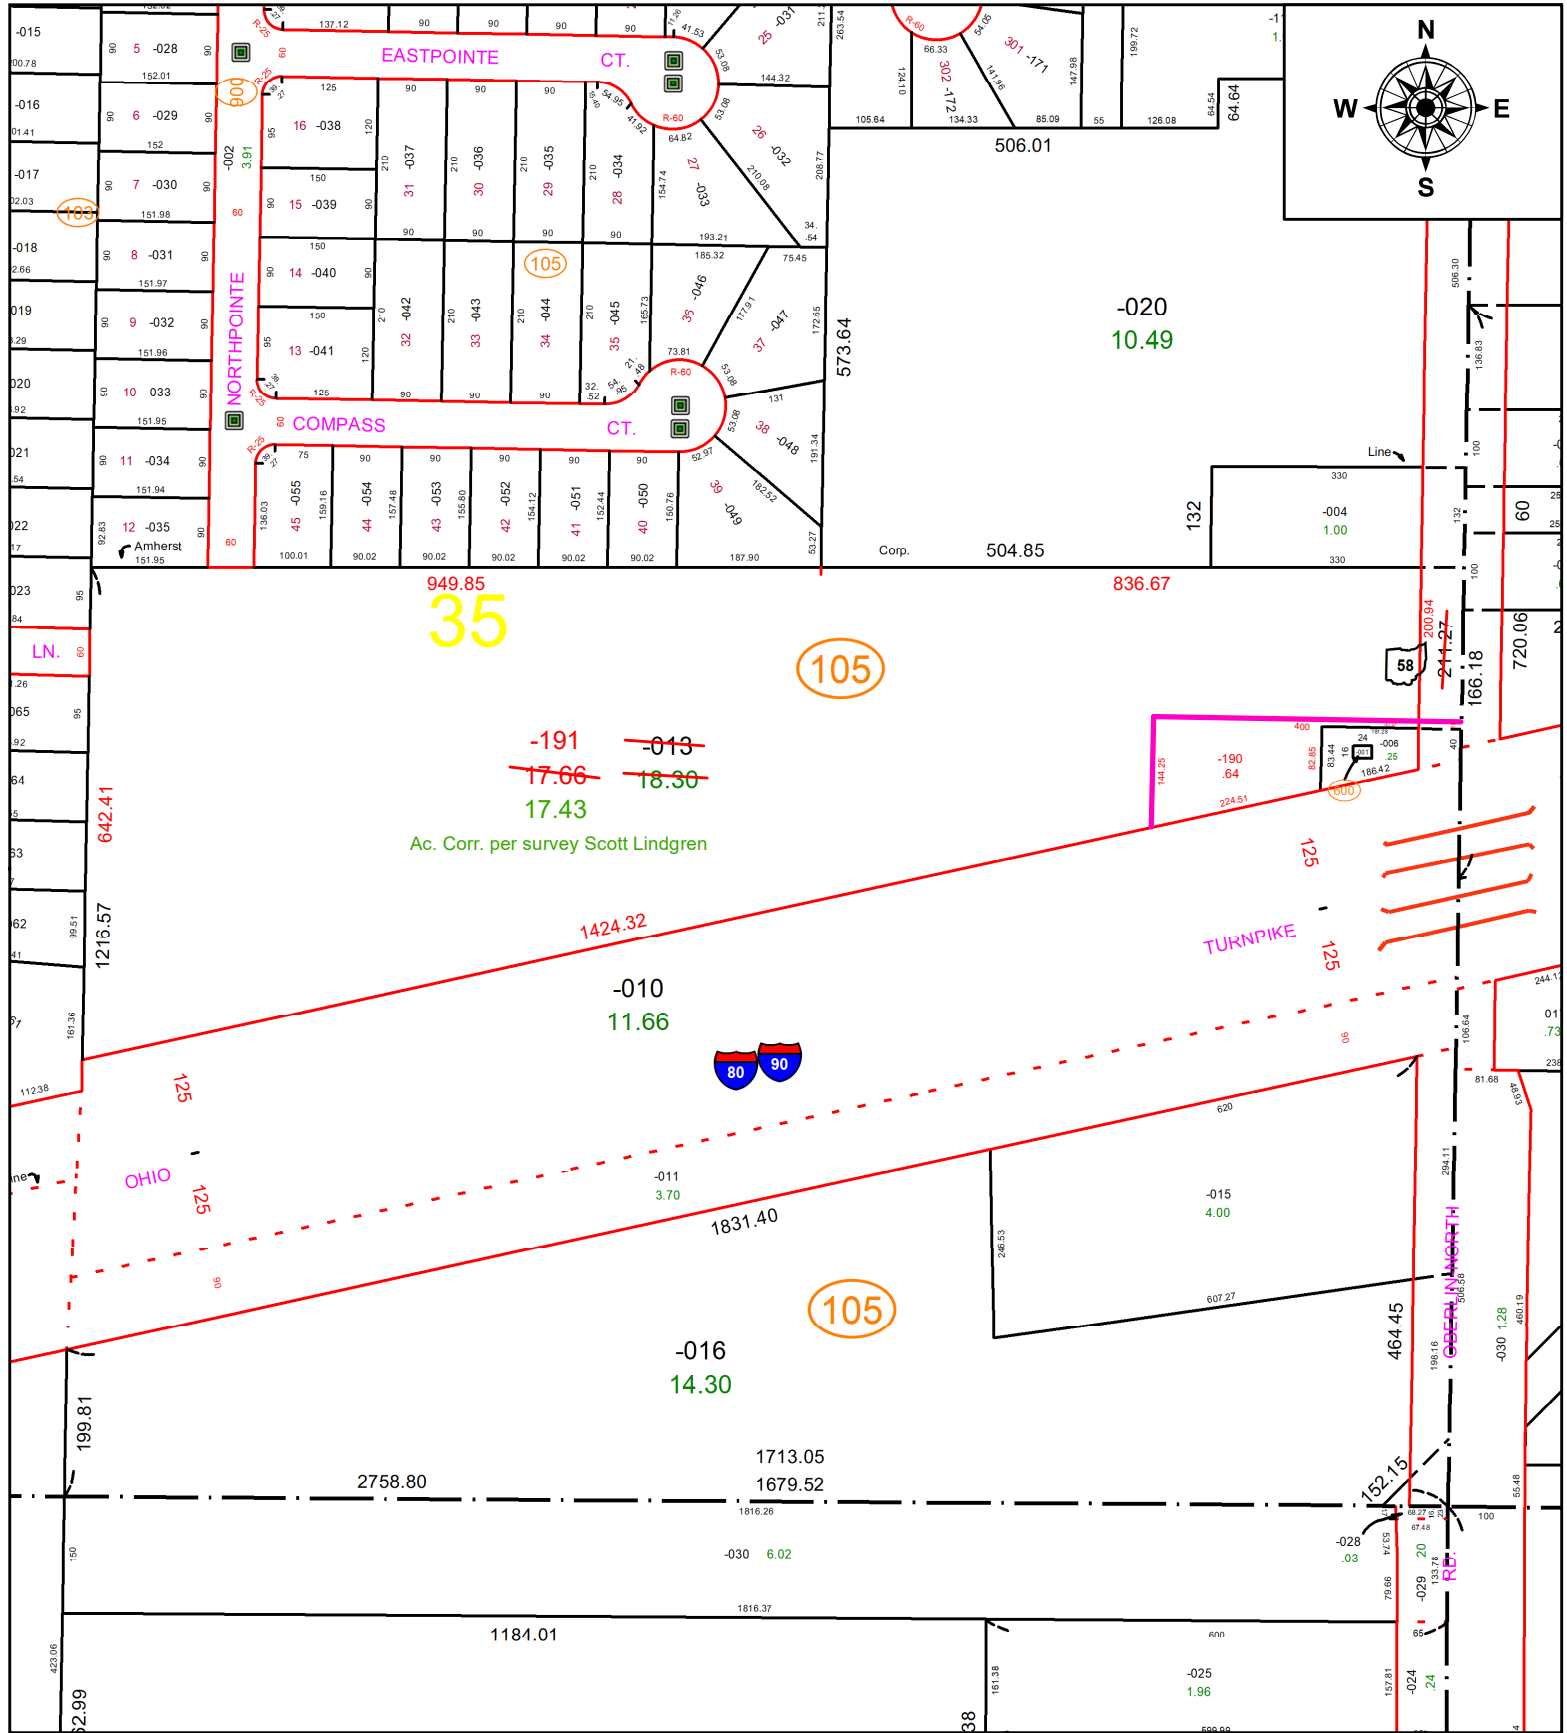

SPLITS/DEEDS PROCESSED
 LORAIN COUNTY TAX MAP DEPARTMENT
 226 MIDDLE AVE. ELYRIA, OH

SURVEYED BY: SCOTT LINGREN **SURVEY #:** 50850
CLOSURE: 1:185977
MAP PAGE(S): 05-00-035
APPROVED BY: DMA **DATE:** 3/29/2023
SCALE: 1" = 250' **PRIOR INSTRUMENT:** 2018-0698968