


PARENT PARCEL: 06-25-173-000-013

CHILD PARCEL: **AC CORR PER SURV BY MATTHEW HILDEBRANDT**

STARTING POINT: C/L OF GULF RD AND NE CORNER OF O/L 173

21-04668-C

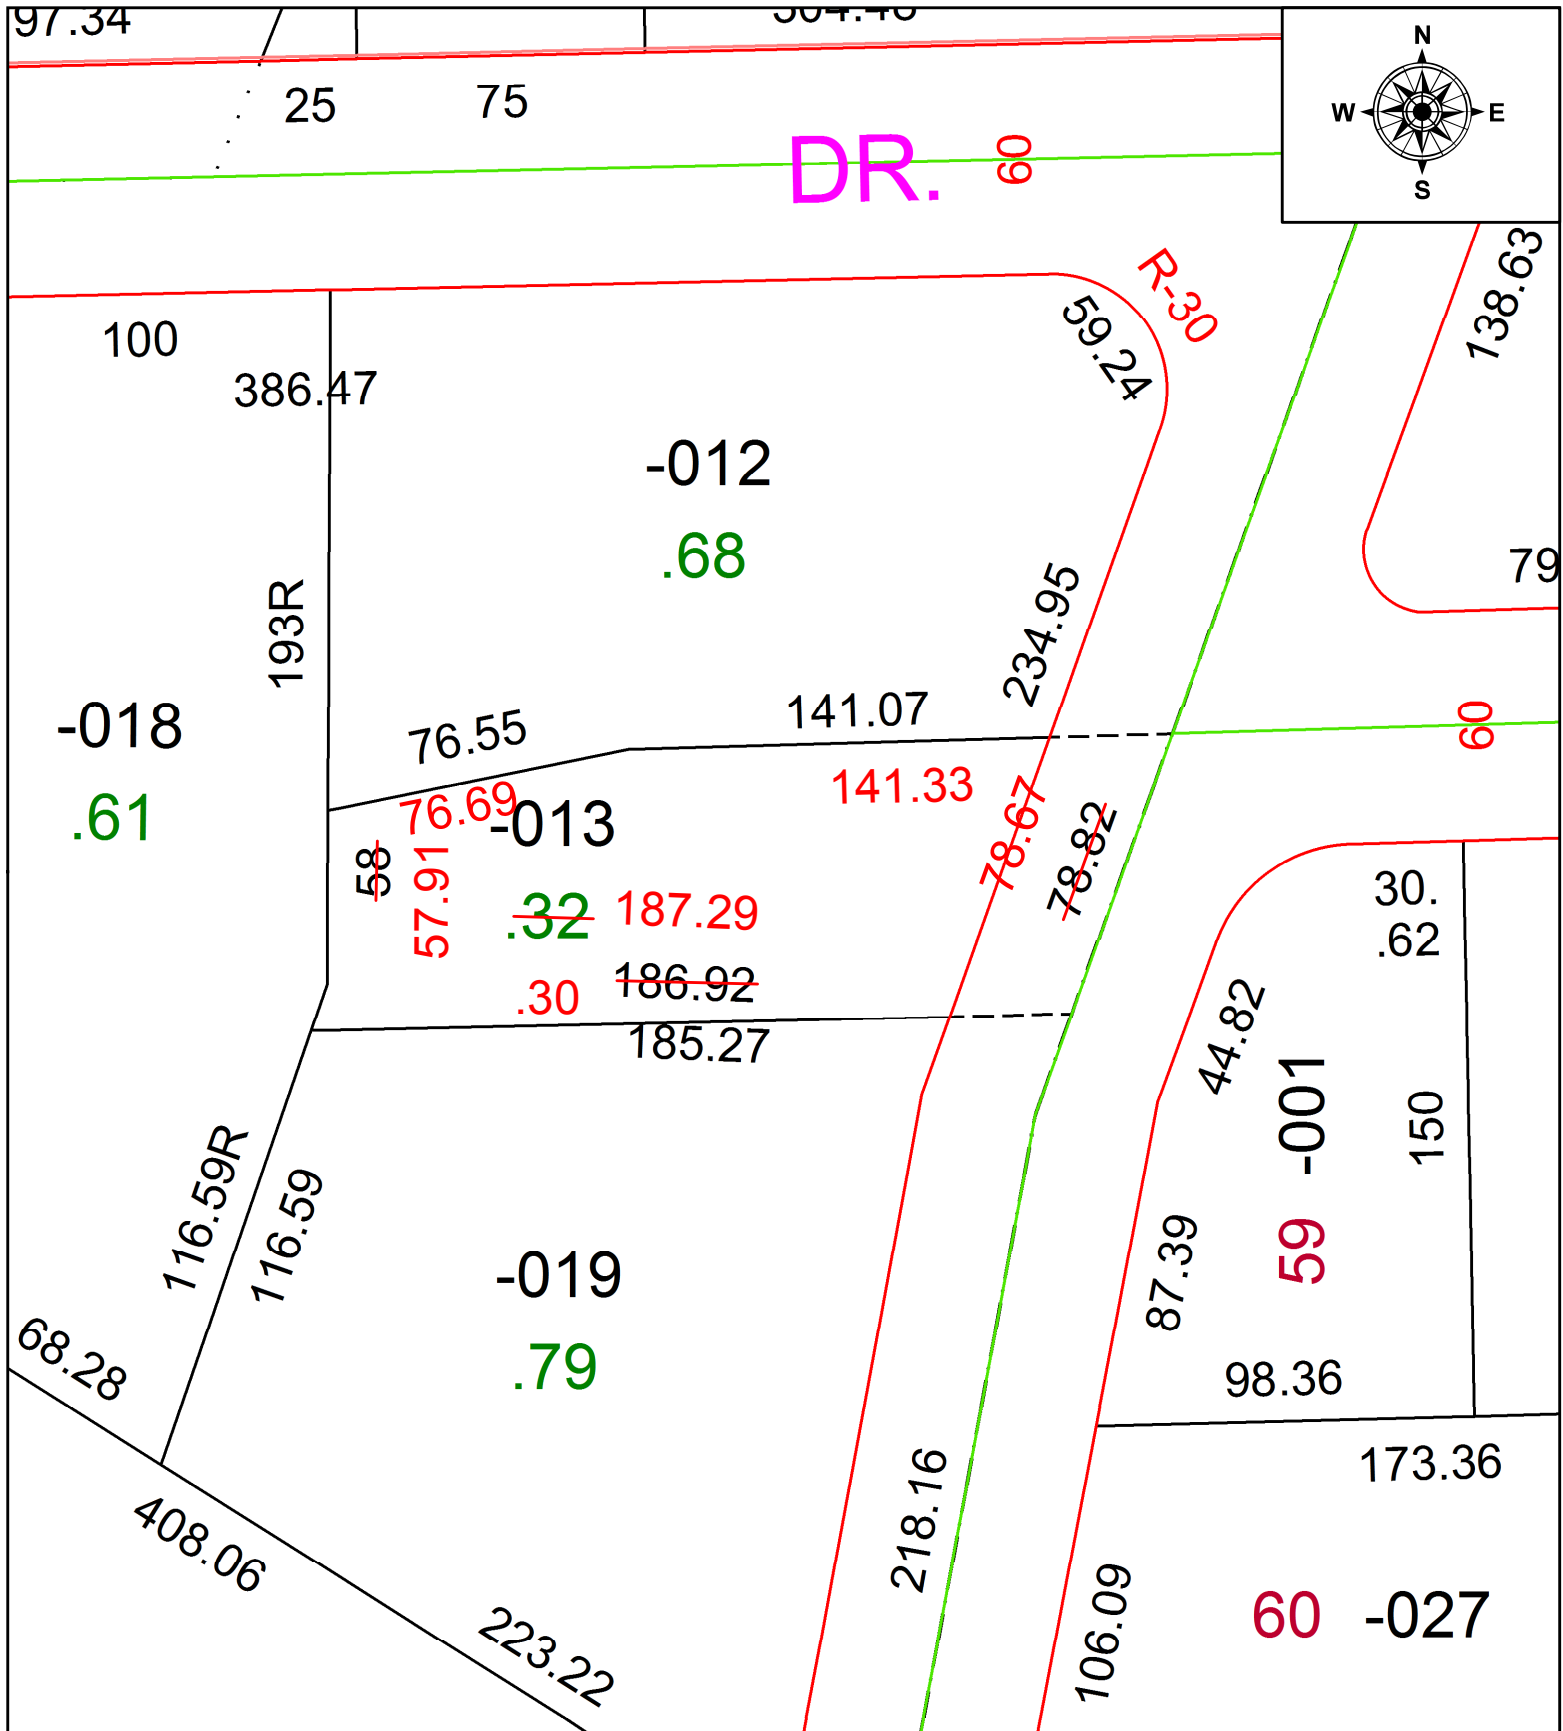

**SPLITS/DEEDS PROCESSED**  
 LORAIN COUNTY TAX MAP DEPARTMENT  
 226 MIDDLE AVE. ELYRIA, OH

SURVEYED BY: MATTHEW A. HILDEBRANDT

CLOSURE: 1: 31292

MAP PAGE(S): 06-25-173

APPROVED BY: AC DATE: 9/22/2021

SCALE: 1" = 50 PRIOR INSTRUMENT: 2016- 0600936