
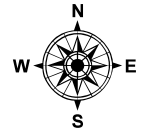


PARENT PARCEL: 07-00-041-000-012

CHILD PARCEL: 07-00-041-000-080 THRU -083 **ACREAGE CORRECTION PER SURVEYOR AMY KELLY**

23-04669

STARTING POINT: INTERSECTION OF C/L OF OTTEN RD & WESTERLY LINE OF O.L. 41

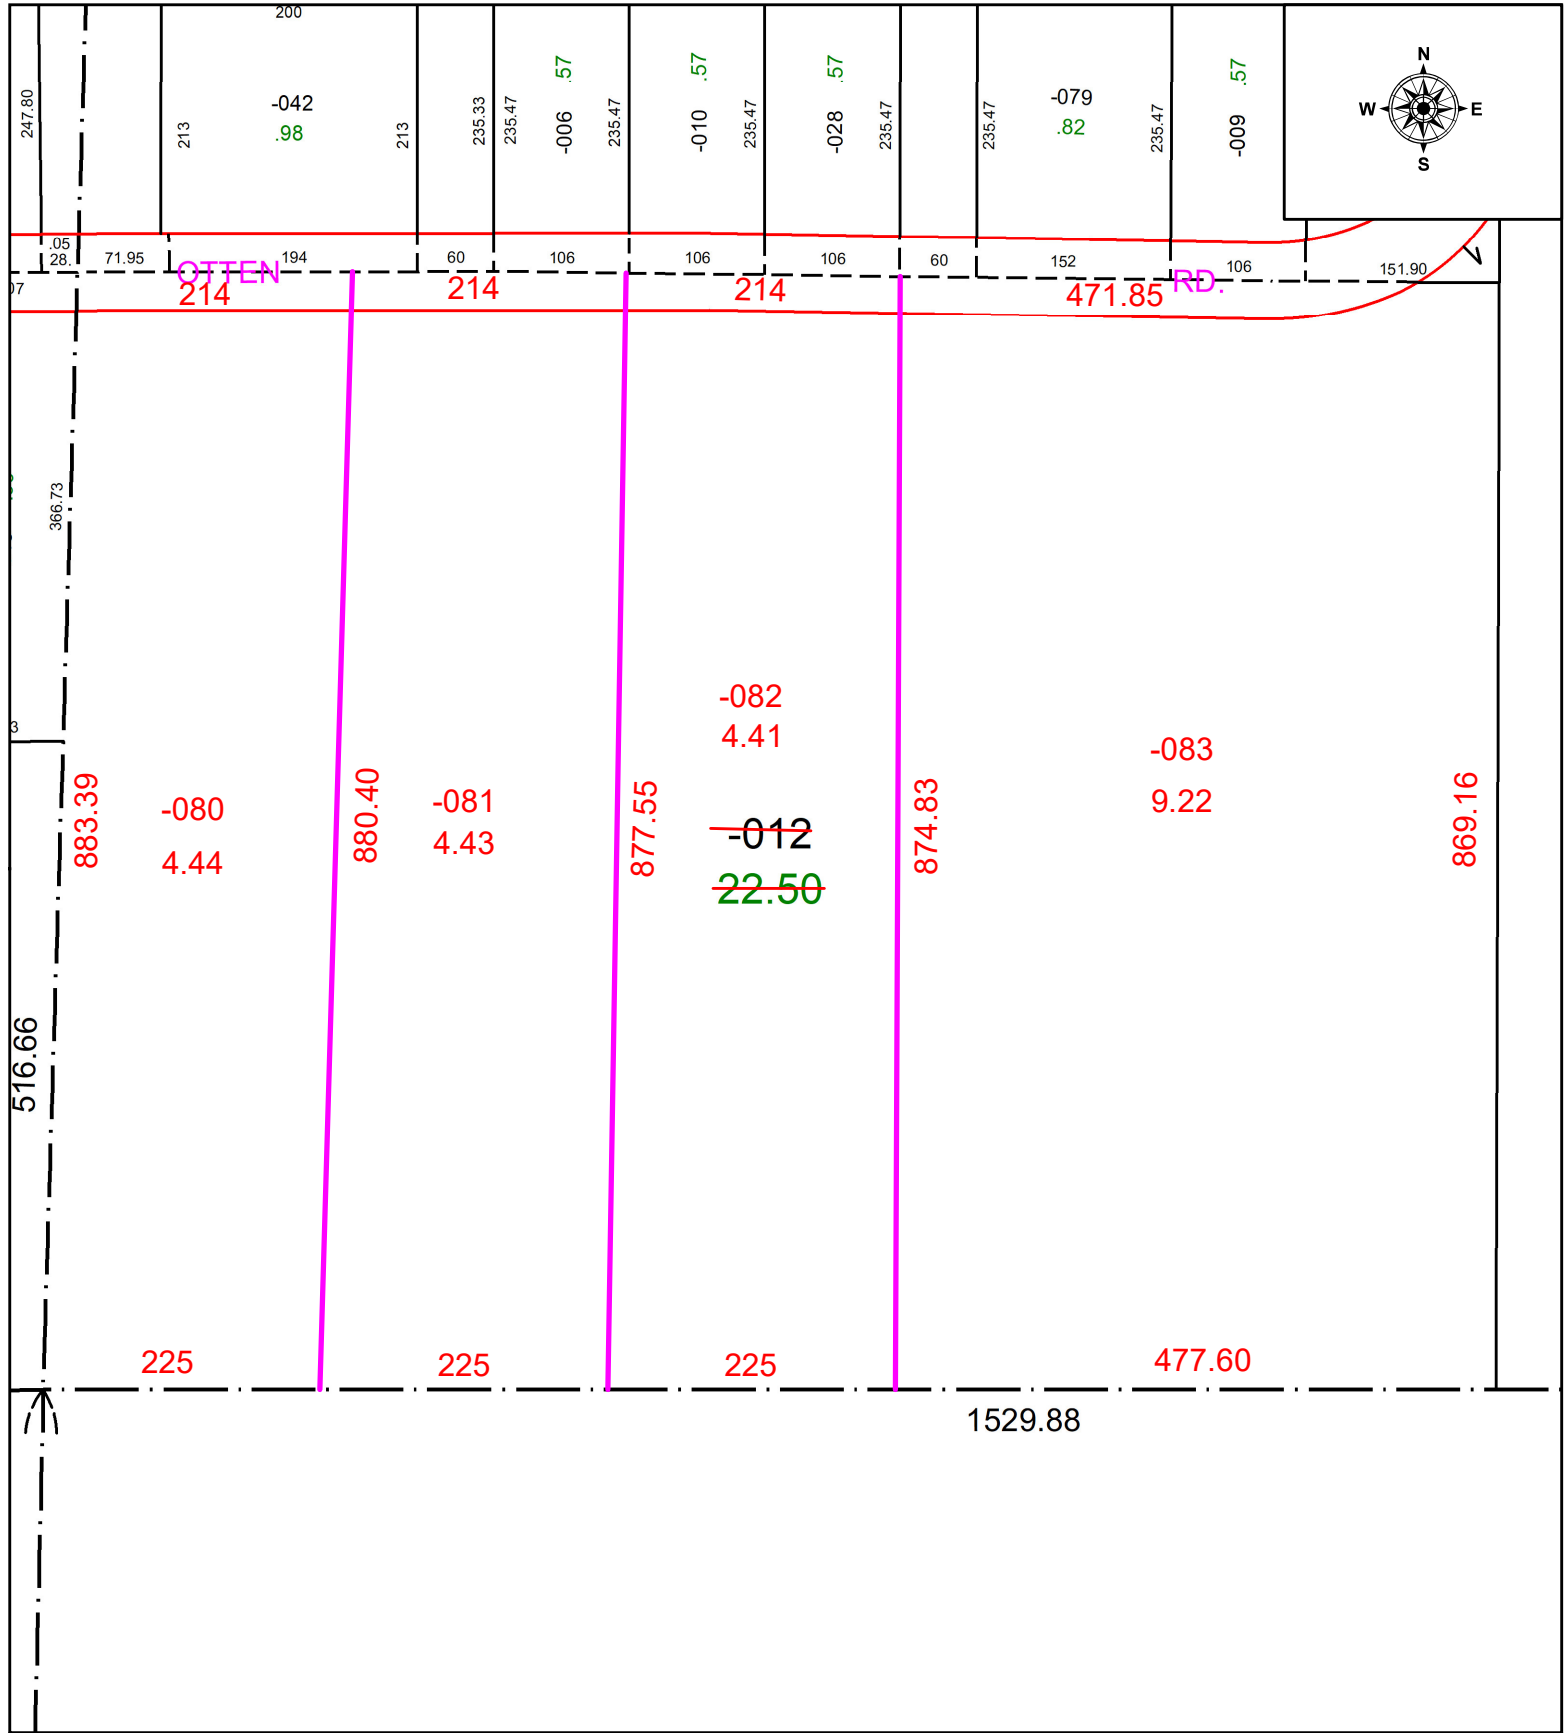

**SPLITS/DEEDS PROCESSED**  
 LORAIN COUNTY TAX MAP DEPARTMENT  
 226 MIDDLE AVE. ELYRIA, OH

SURVEYED BY: AMY KELLY SURVEY # 50862  
 CLOSURE: 1: 2075971  
 MAP PAGE(S): 07-00-041  
 APPROVED BY: WRZ DATE: 4/7/2023  
 SCALE: 1" = 150 PRIOR INSTRUMENT: #2023-0906997