



PARENT PARCEL: 15-00-098-108-210, -211, -270, -300

CHILD PARCEL: 15-00-098-108-304, -305, & -306

N/A

23-04670

STARTING POINT: SOUTHEASTERLY CORNER OF S/L 509 IN PHEASANT RUN VILLAGE PHASE NO. 1

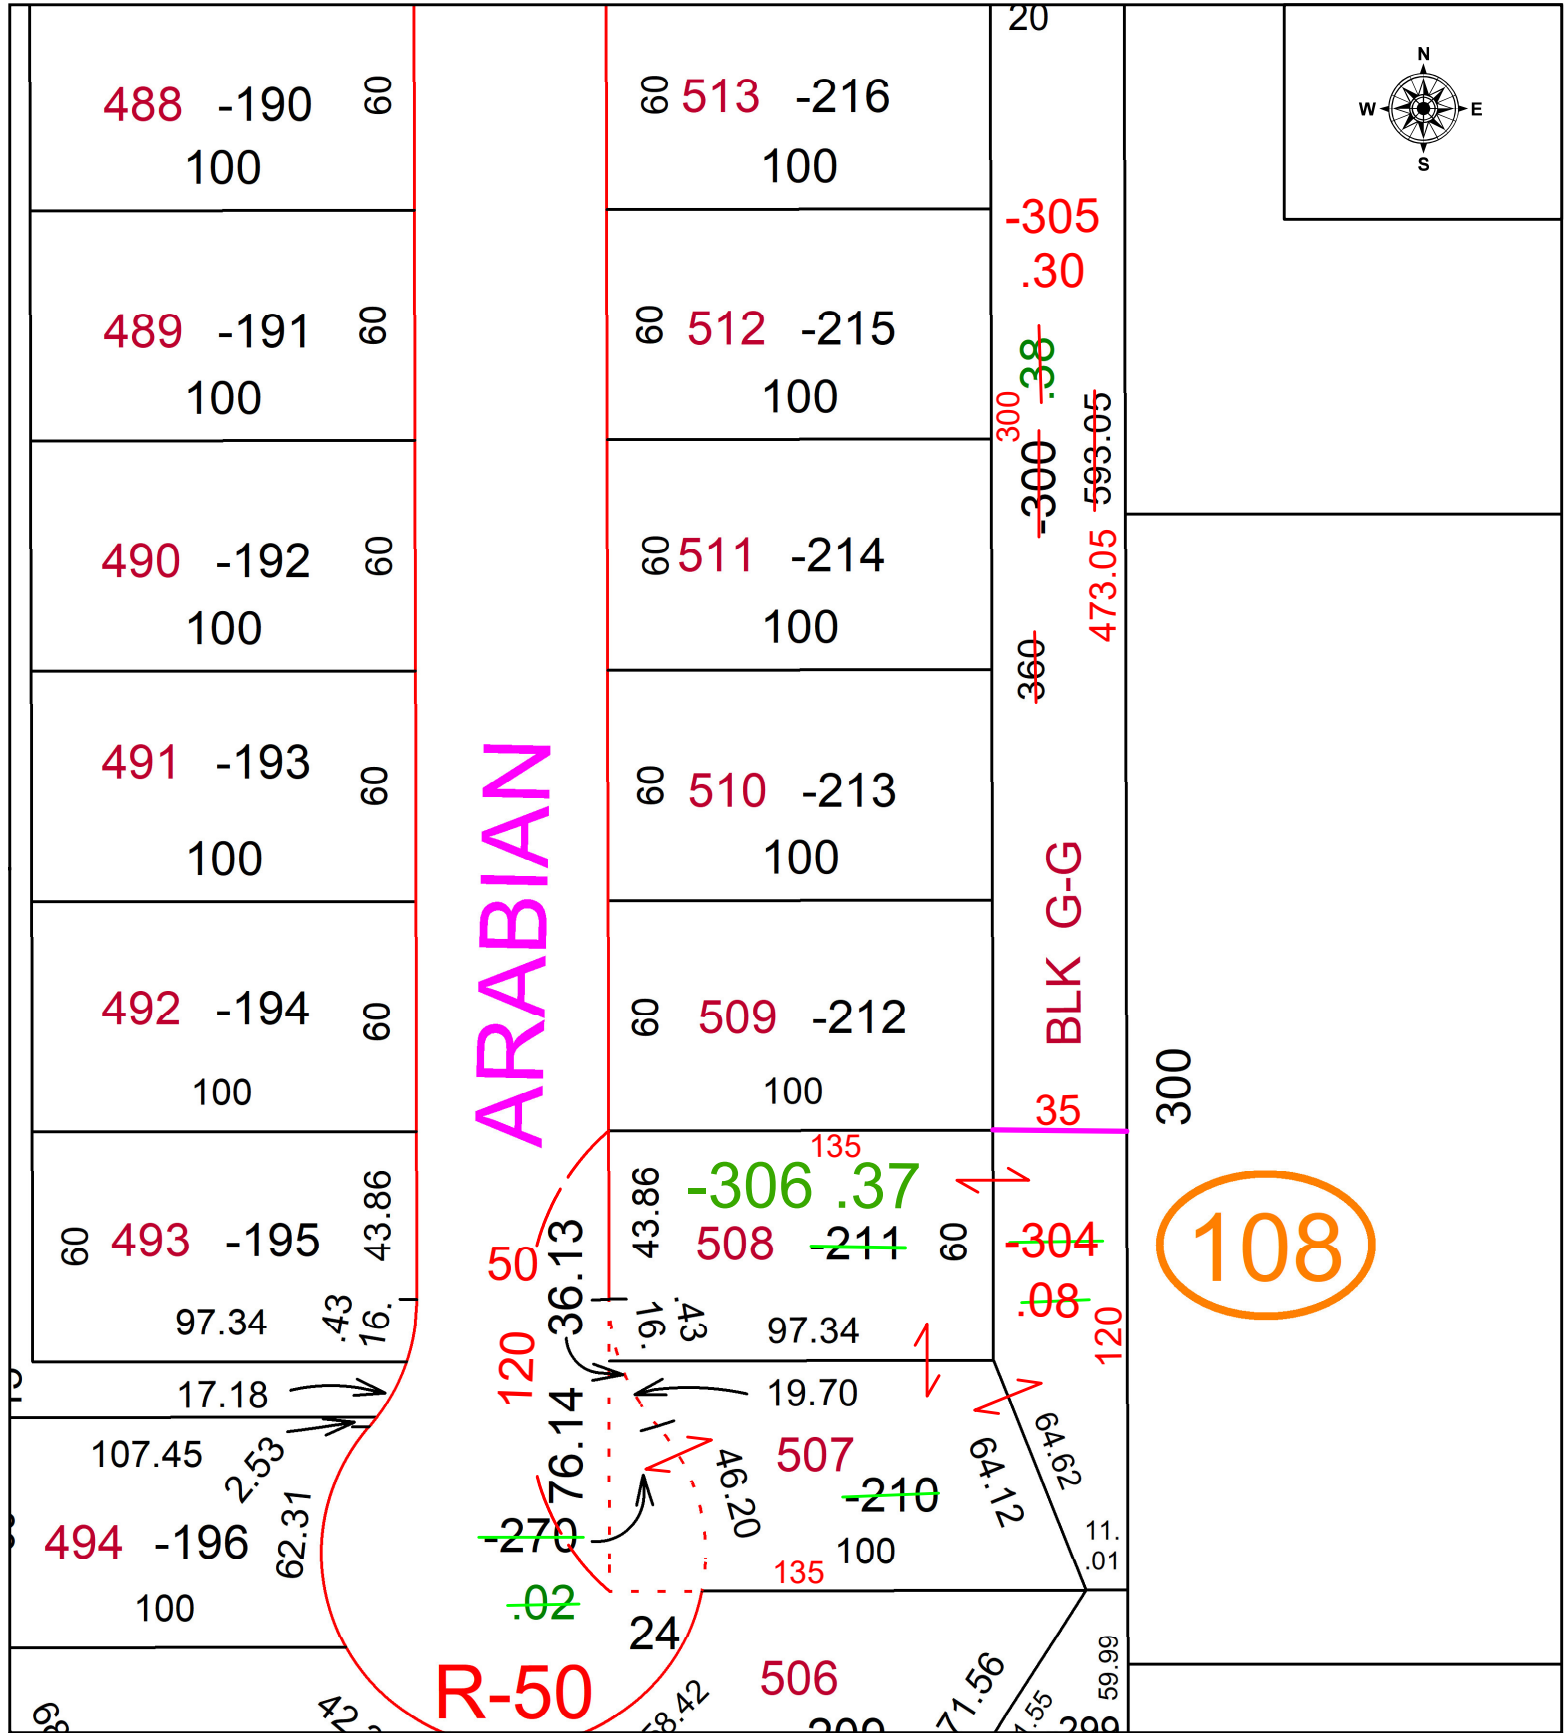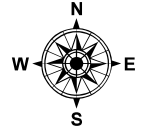


ARABIAN

R-50

BLK G-G

108

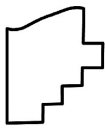

SPLITS/DEEDS PROCESSED
LORAIN COUNTY TAX MAP DEPARTMENT
226 MIDDLE AVE. ELYRIA, OH

SURVEYED BY: THOMAS SIMON SURVEY # 50866
CLOSURE: 1: 162094
MAP PAGE(S): 15-00-098
APPROVED BY: WRZ DATE: 4/17/2023
SCALE: 1" = 50 PRIOR INSTRUMENT: #2019-0735650