
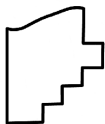


PARENT PARCEL: 05-00-023-109-007

CHILD PARCEL: **FRONTAGE & DEPTH TO ACERAGE CORR PER SURV BY T. SIMON**

21-04673-C

STARTING POINT: NE CORNER OF S/L 459 RECORDED IN PLAT VOL 2 PG 12

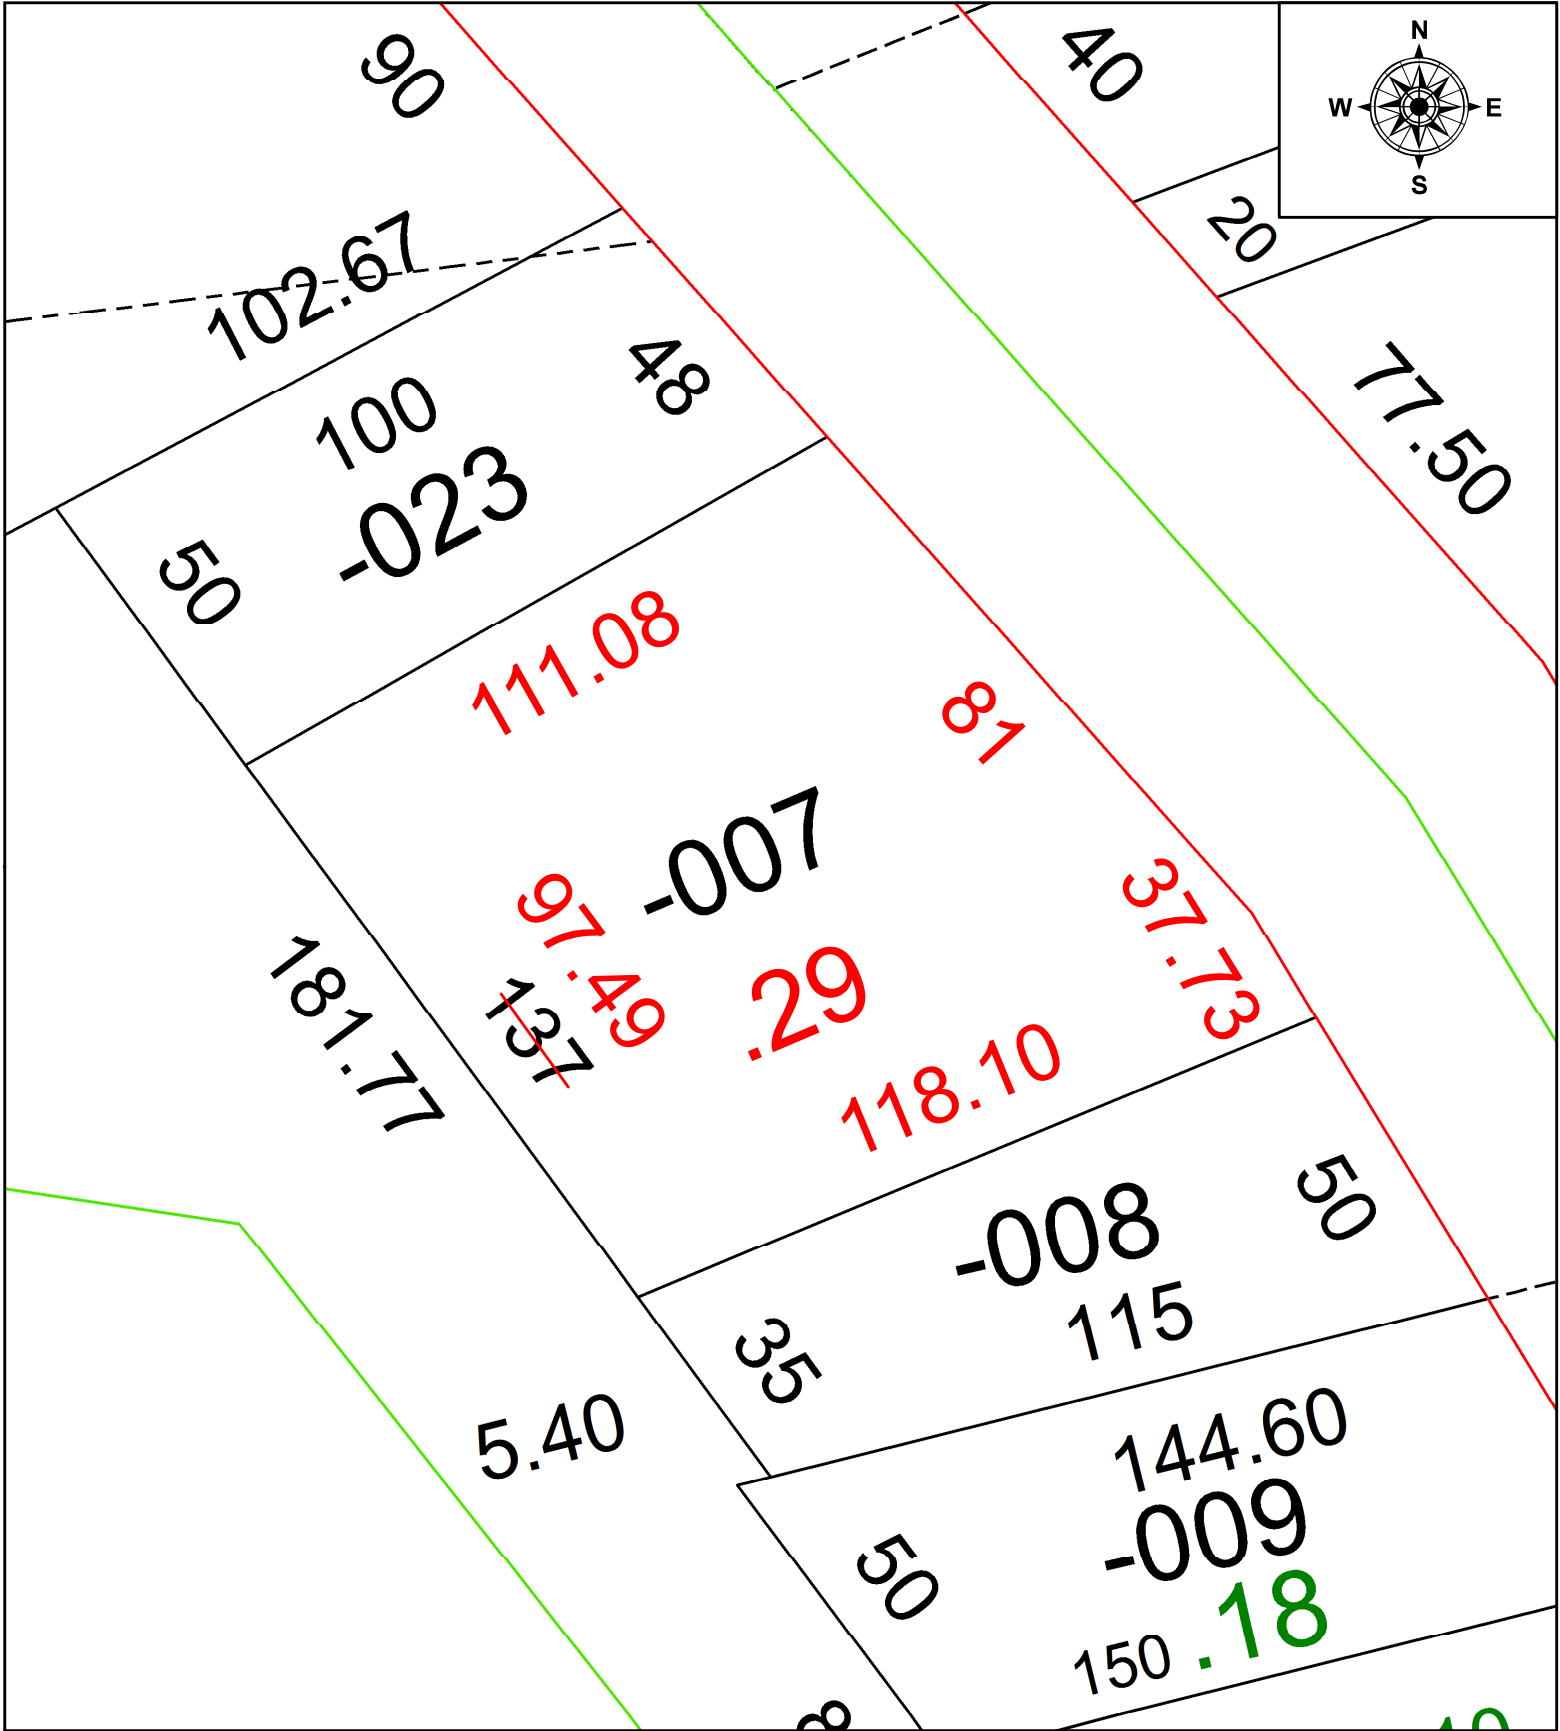

SPLITS/DEEDS PROCESSED
 LORAIN COUNTY TAX MAP DEPARTMENT
 226 MIDDLE AVE. ELYRIA, OH

SURVEYED BY: THOMAS A. SIMON
 CLOSURE: 1: 52361
 MAP PAGE(S): 05-00-023
 APPROVED BY: AC DATE: 9/24/2021
 SCALE: 1" = 30' PRIOR INSTRUMENT: 2021- 0805207