


PARENT PARCEL: 06-22-013-102-019

CHILD PARCEL: MAP CORR. ONLY

STARTING POINT: CL OF WEST RIVER RD. & SOUTH LINE OF ESCHTRUTH ALLOT.

21-04676-C

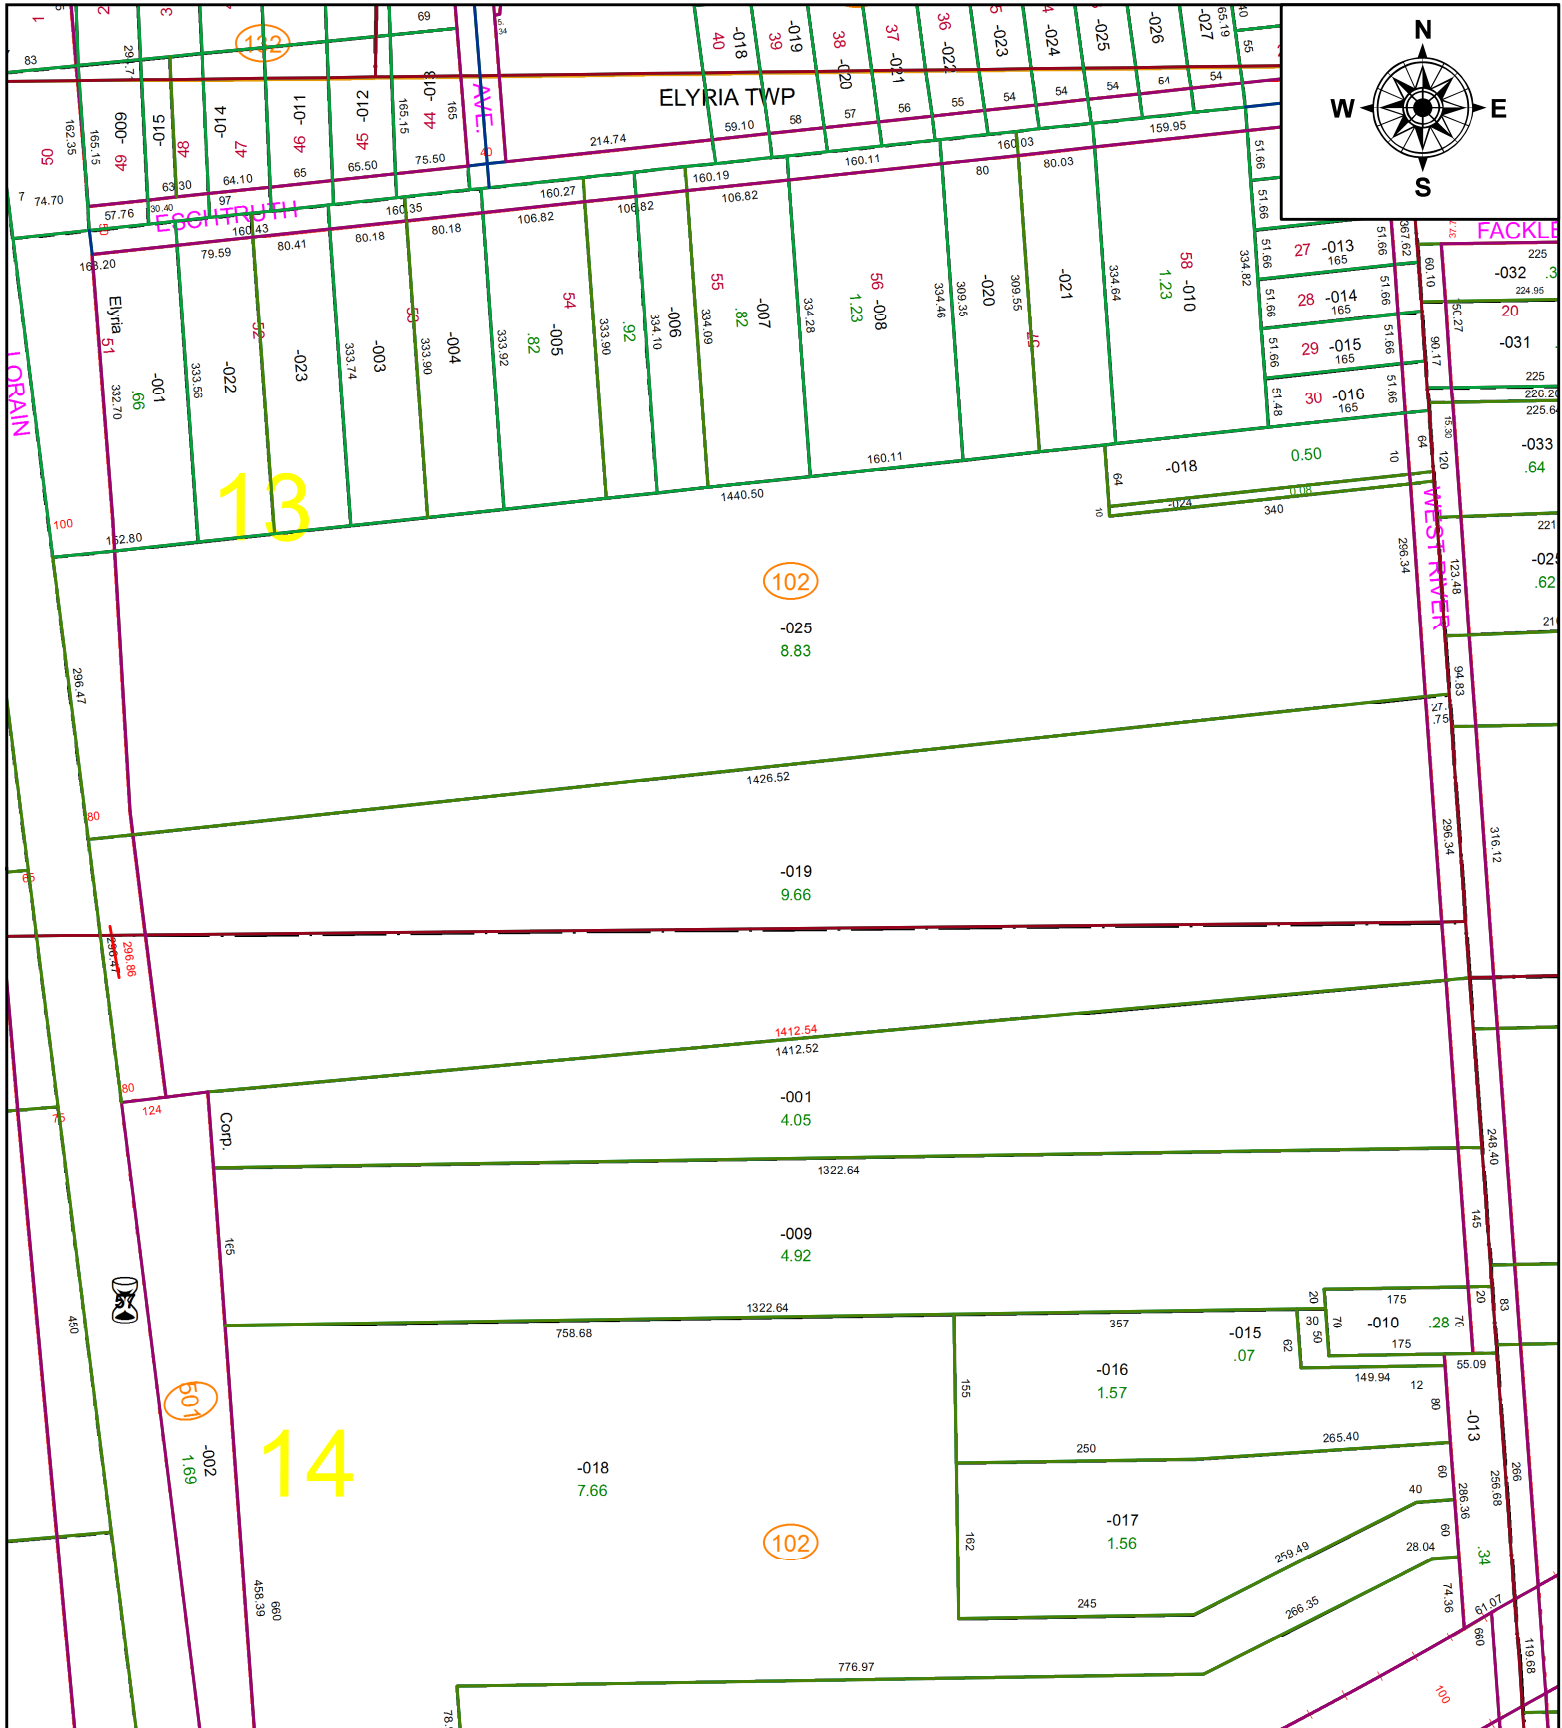

SPLITS/DEEDS PROCESSED
 LORAIN COUNTY TAX MAP DEPARTMENT
 226 MIDDLE AVE. ELYRIA, OH

SURVEYED BY: DAVID BRUCKNER
CLOSURE: 1:1019331
MAP PAGE(S): 06-22-013
APPROVED BY: TJS **DATE:** 10/13/2021
SCALE: 1" = 200' **PRIOR INSTRUMENT:** 2019-0709085