


PARENT PARCEL: 06-23-008-104-007 & -052

CHILD PARCEL: 06-23-008-104-069, -070, -071


23-04677

STARTING POINT: AC CORR PER SURV BY WILFREDO BARBOSA

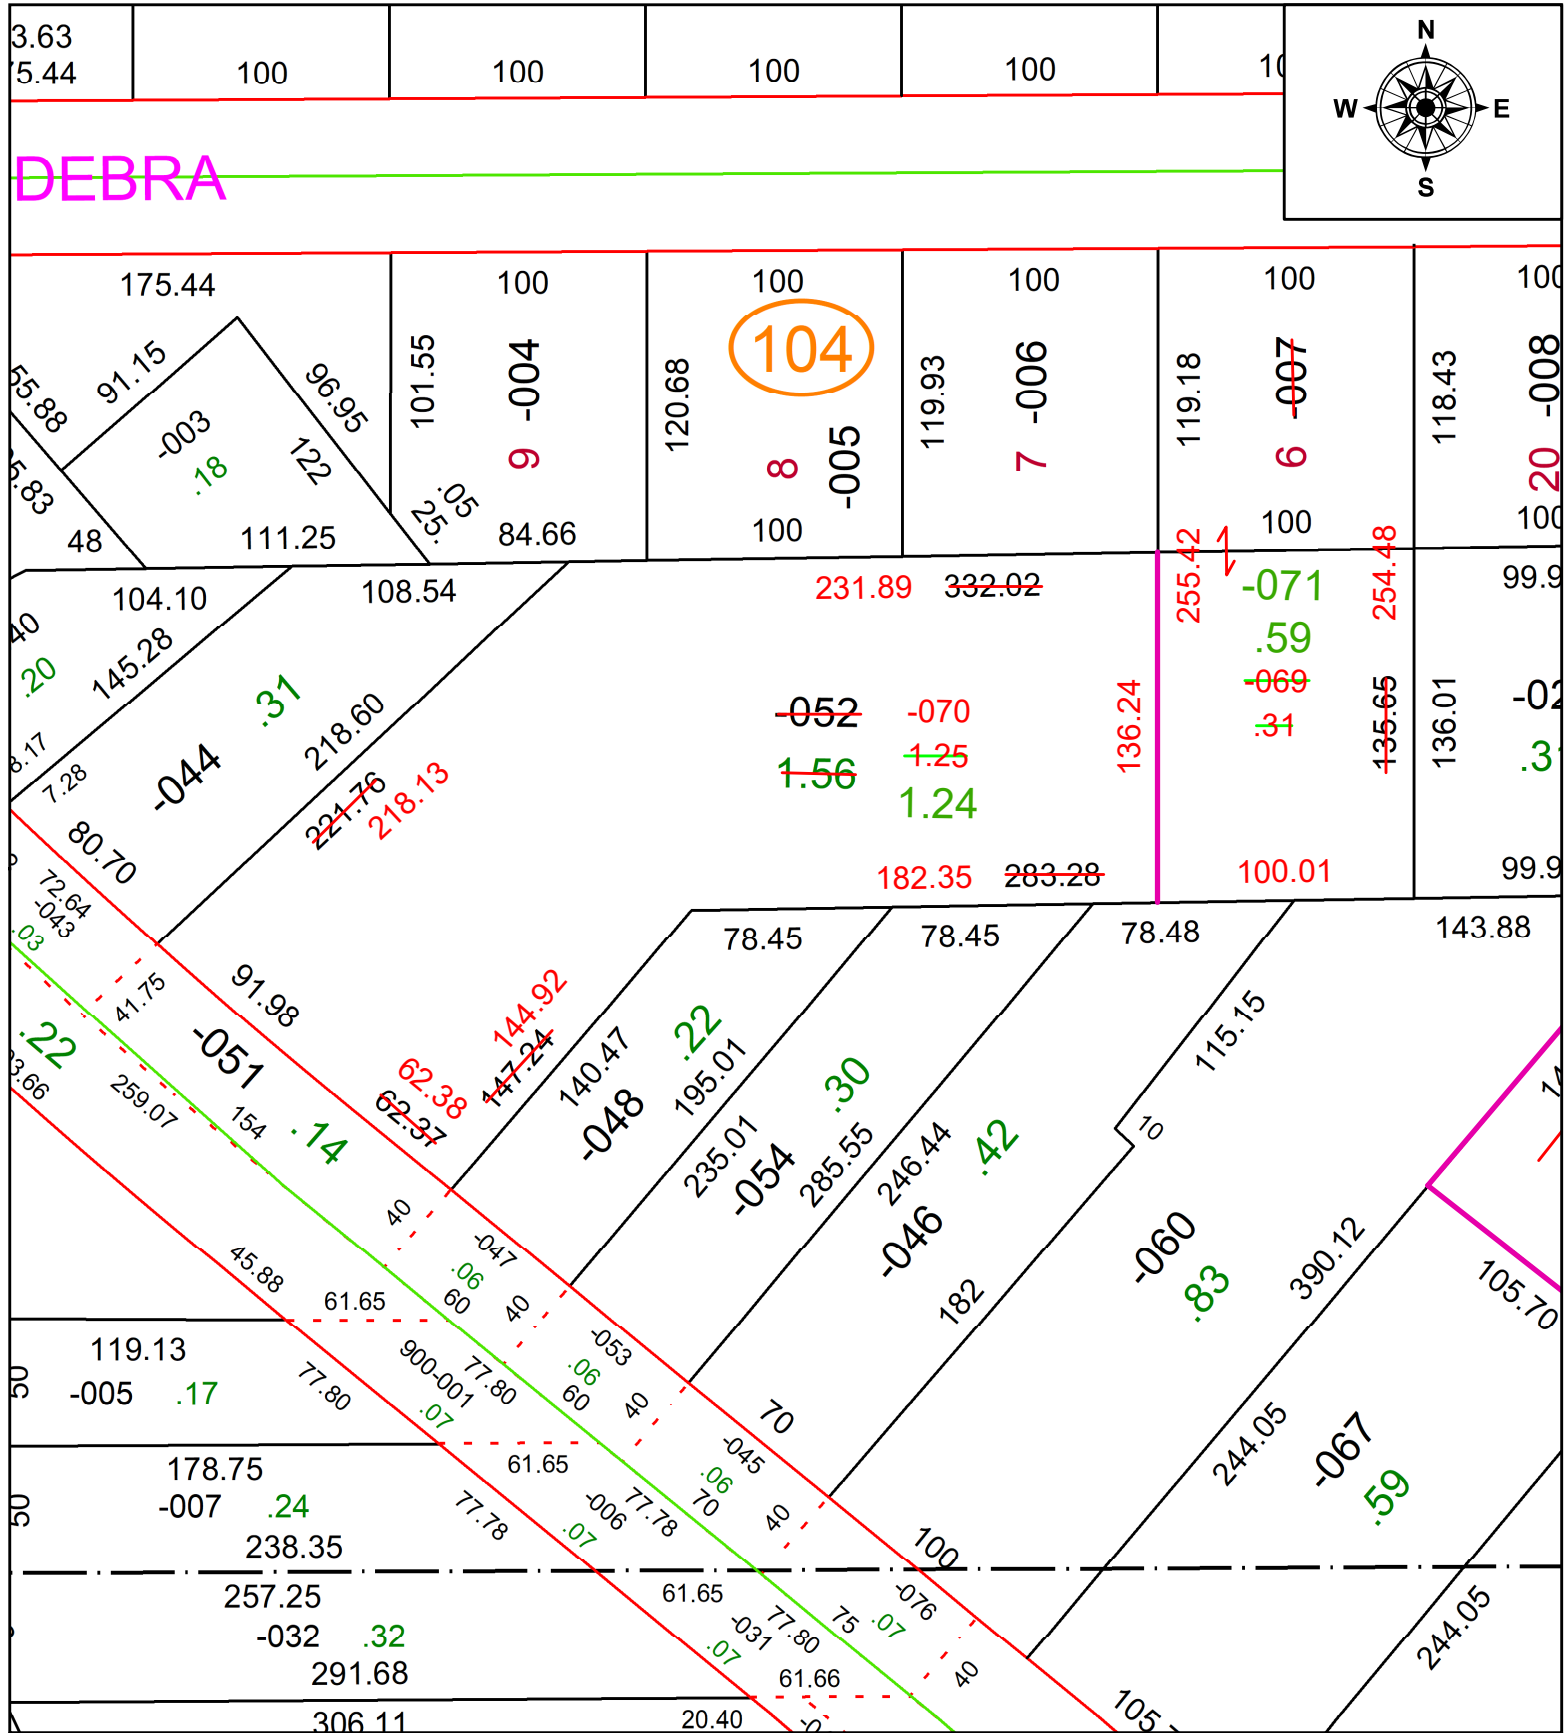

DEBRA

104

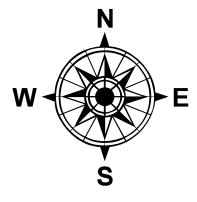

SPLITS/DEEDS PROCESSED

LORAIN COUNTY TAX MAP DEPARTMENT
226 MIDDLE AVE. ELYRIA, OH

SURVEYED BY: WILFREDO BARBOSA SURV # 50864
 CLOSURE: 1: 43617
 MAP PAGE(S): 06-24
 APPROVED BY: AC DATE: April 19, 2023
 SCALE: 1 in = 75 ft PRIOR INSTRUMENT: 2022- 0862964