
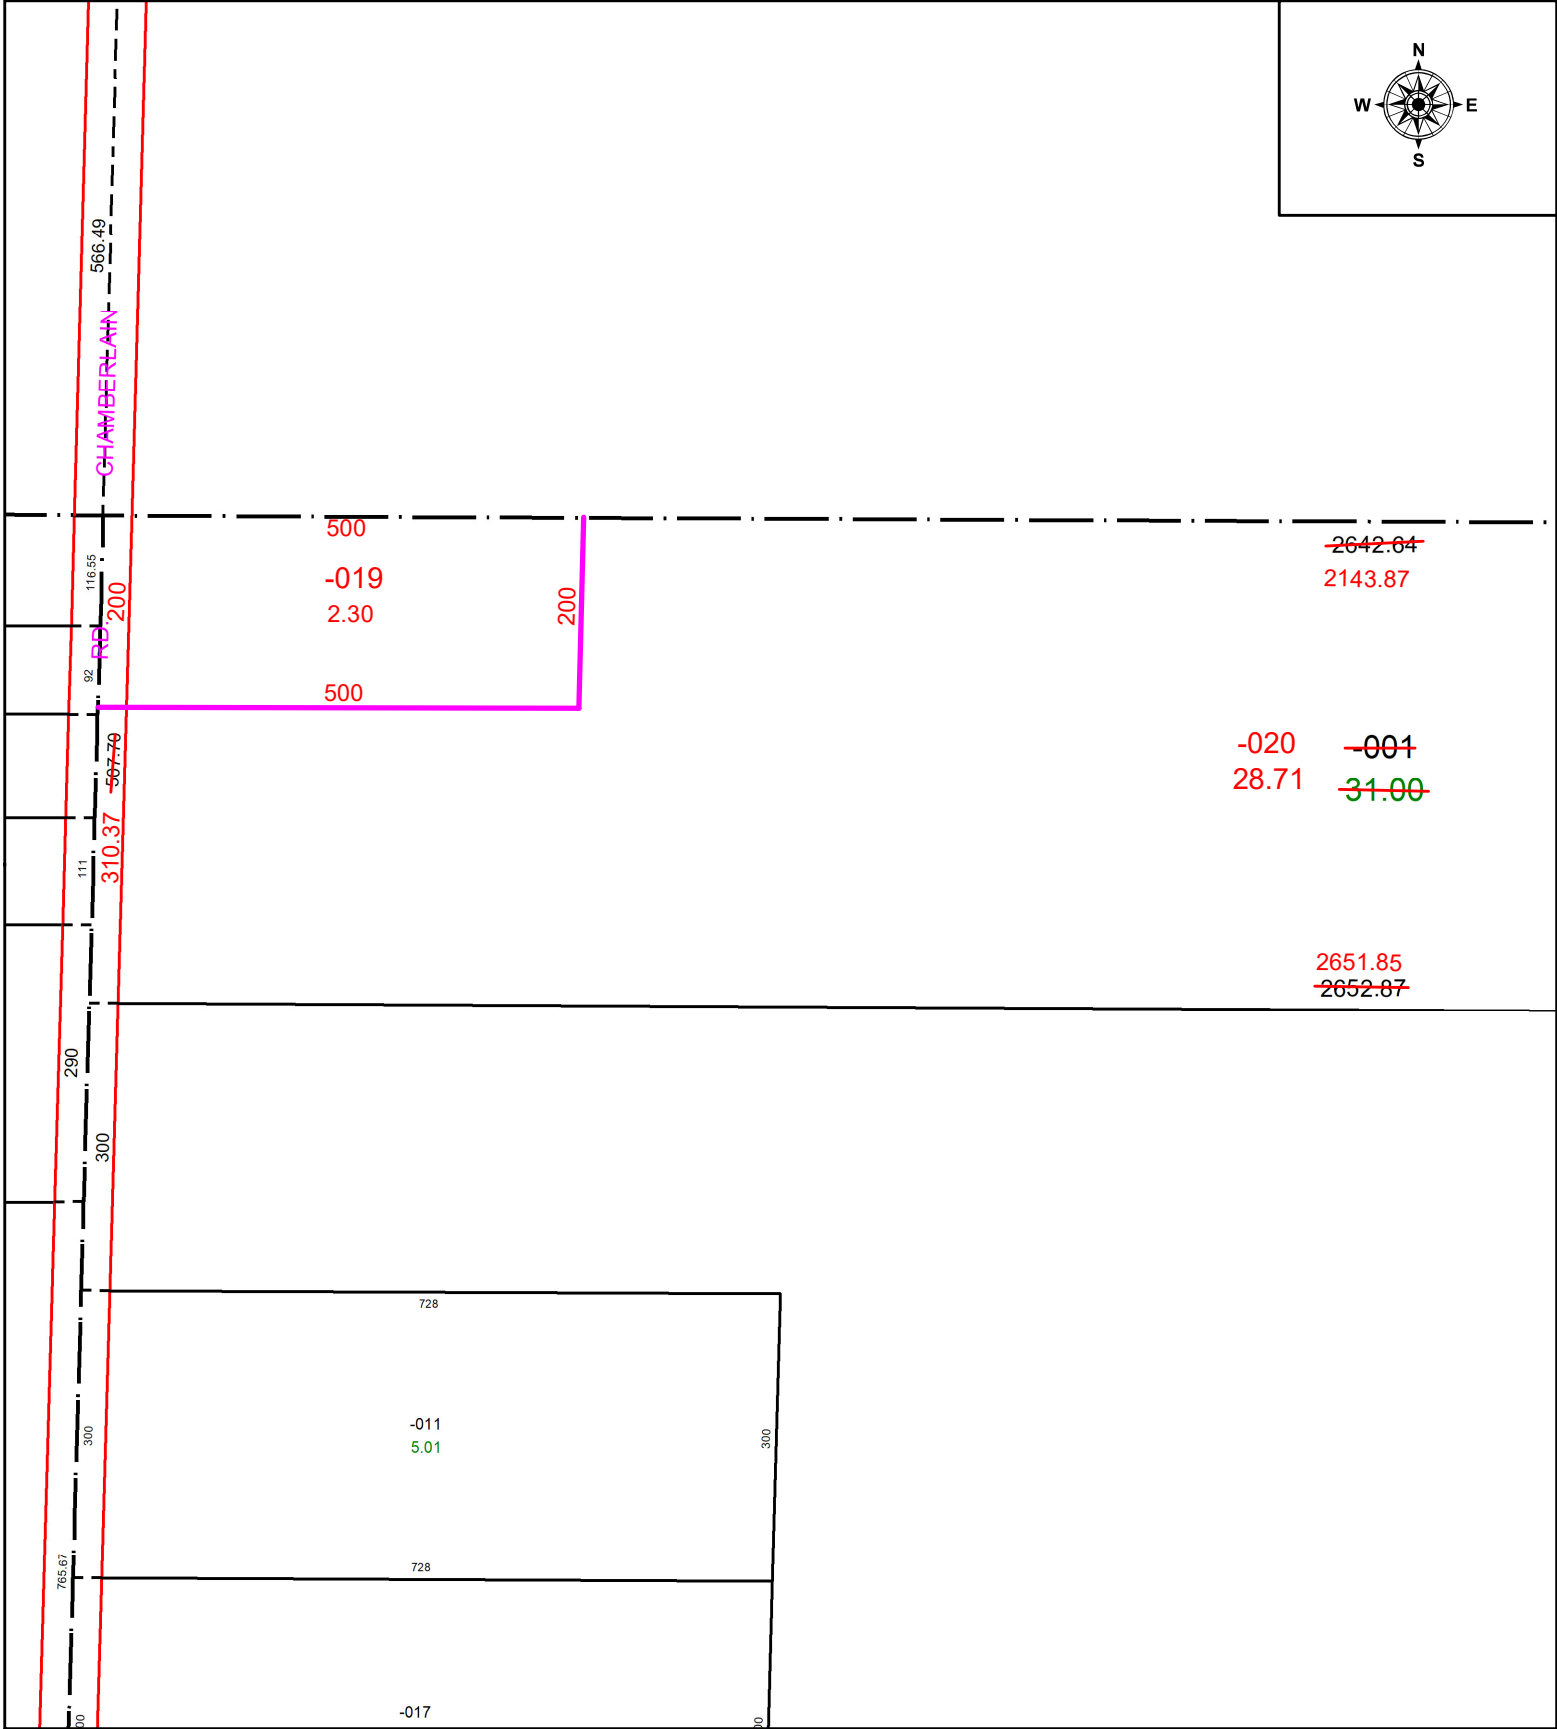


PARENT PARCEL: 16-00-039-000-001
 CHILD PARCEL: 16-00-039-000-019 & -020
 STARTING POINT: NORTHEASTERLY CORNER OF O.L. 40 & C/L OF CHAMBERLAIN RD

23-04679

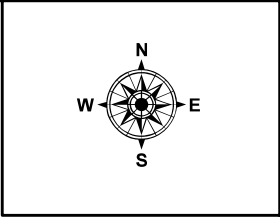

SPLITS/DEEDS PROCESSED
 LORAIN COUNTY TAX MAP DEPARTMENT
 226 MIDDLE AVE. ELYRIA, OH

SURVEYED BY: JOHN DECHANT JR. SURVEY # 50871
 CLOSURE: 1: INF
 MAP PAGE(S): 16-00-039
 APPROVED BY: WRZ DATE: 4/20/2023
 SCALE: 1" = 200 PRIOR INSTRUMENT: #2017-0635337