
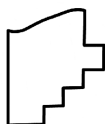
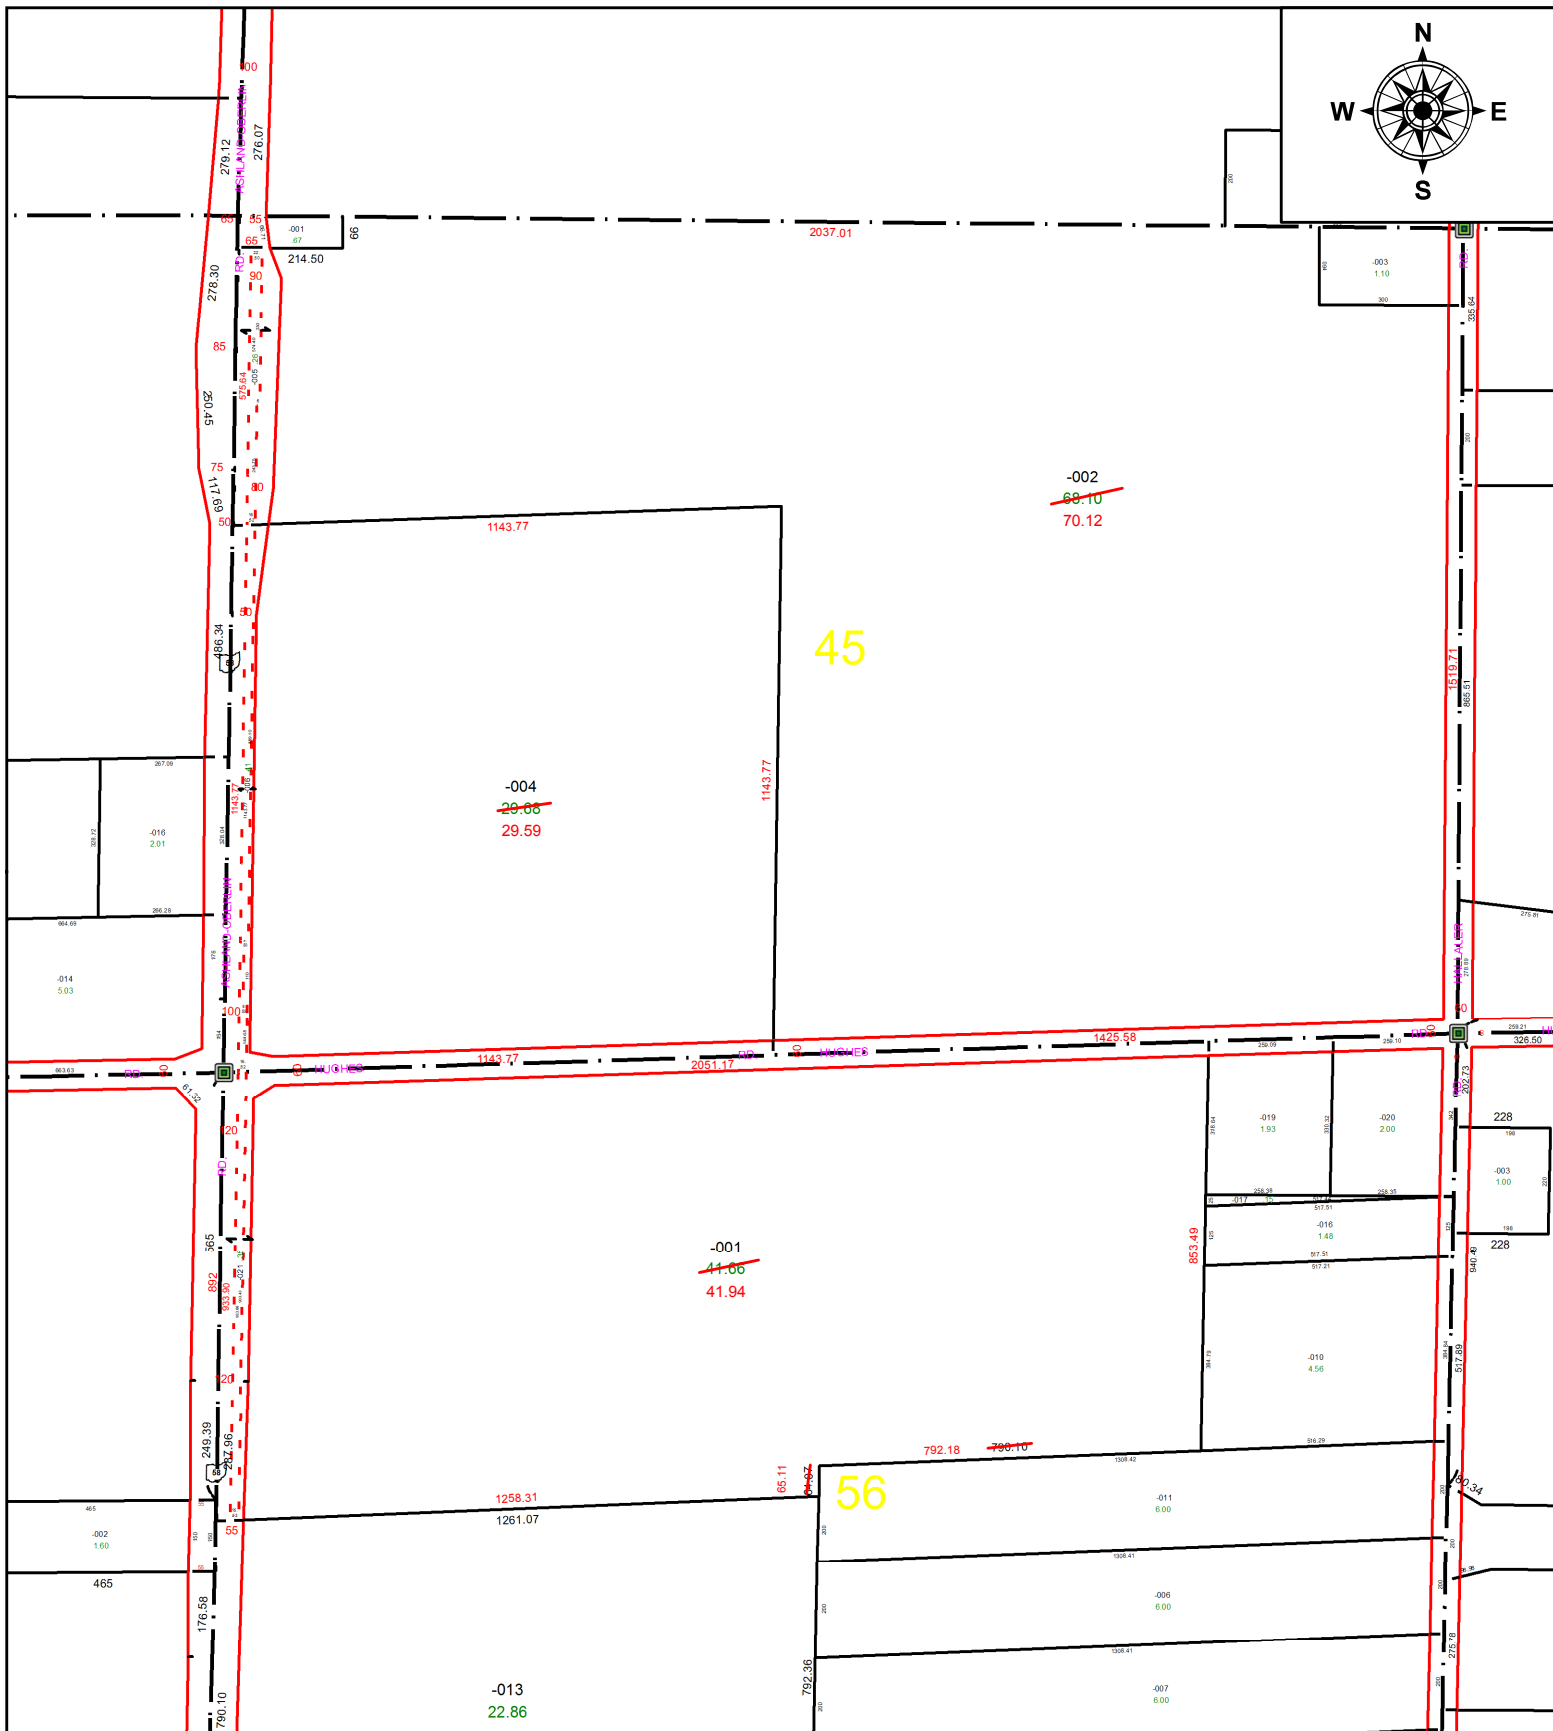


PARENT PARCEL: 14-00-045-000-002, -004 & 14-00-056-000-001

CHILD PARCEL: **AC. CORR. PER SURVEY**

STARTING POINT: CL OF HUGHES RD & HALLAUER RD.

21-04680-C

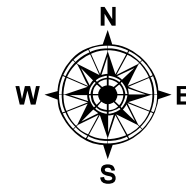

SPLITS/DEEDS PROCESSED
LORAIN COUNTY TAX MAP DEPARTMENT
226 MIDDLE AVE. ELYRIA, OH

SURVEYED BY: TIMOTHY HOZALSKI

CLOSURE: 1: 1437160

MAP PAGE(S): 14-00-045 & 14-00-056

APPROVED BY: DMA DATE: 10/12/2021

SCALE: 1" = 400' PRIOR INSTRUMENT: 20010744979