
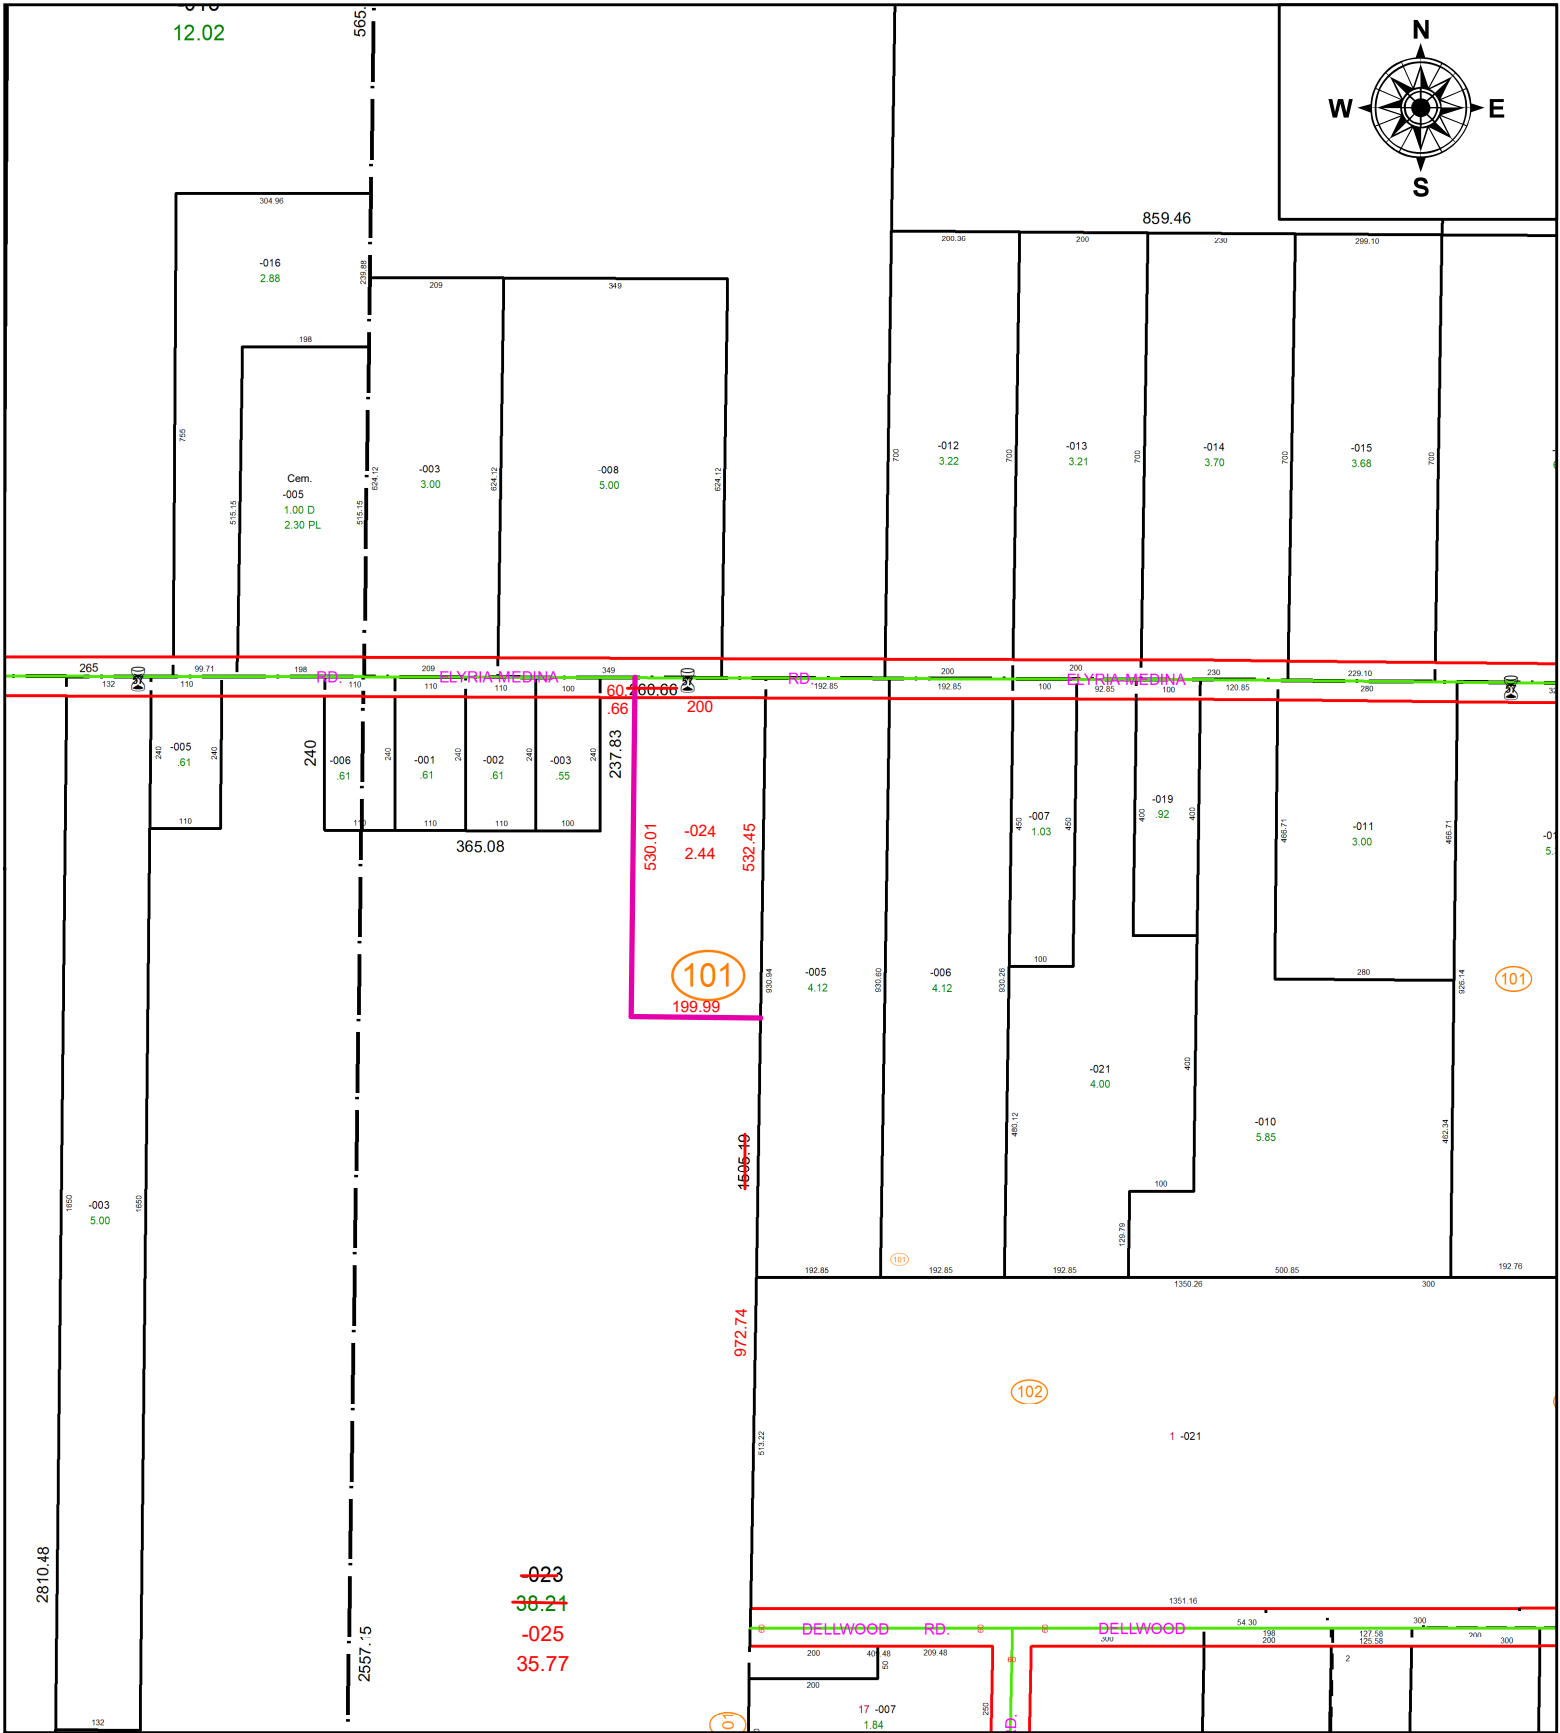


PARENT PARCEL: 16-00-025-101-023

CHILD PARCEL: 16-00-025-101-024 & -025

STARTING POINT: C/L OF GRAFTON RD AND W LINE OF O/L 25

23-04683

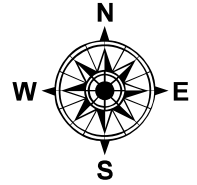


101  
199.99

101

102

-023  
38.21  
-025  
35.77

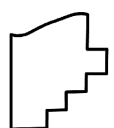

**SPLITS/DEEDS PROCESSED**  
LORAIN COUNTY TAX MAP DEPARTMENT  
226 MIDDLE AVE. ELYRIA, OH

SURVEYED BY: THOMAS A. SIMON SURV # 50879  
CLOSURE: 1: 718269  
MAP PAGE(S): 16-00-025  
APPROVED BY: AC DATE: May 01, 2023  
SCALE: 1 in = 300 ft PRIOR INSTRUMENT: 2023- 0902885