


PARENT PARCEL: 03-00-047-102-019



CHILD PARCEL: **MAP CORRECTION ONLY**

STARTING POINT: SW CORNER OF S/L 7

21-04689-C

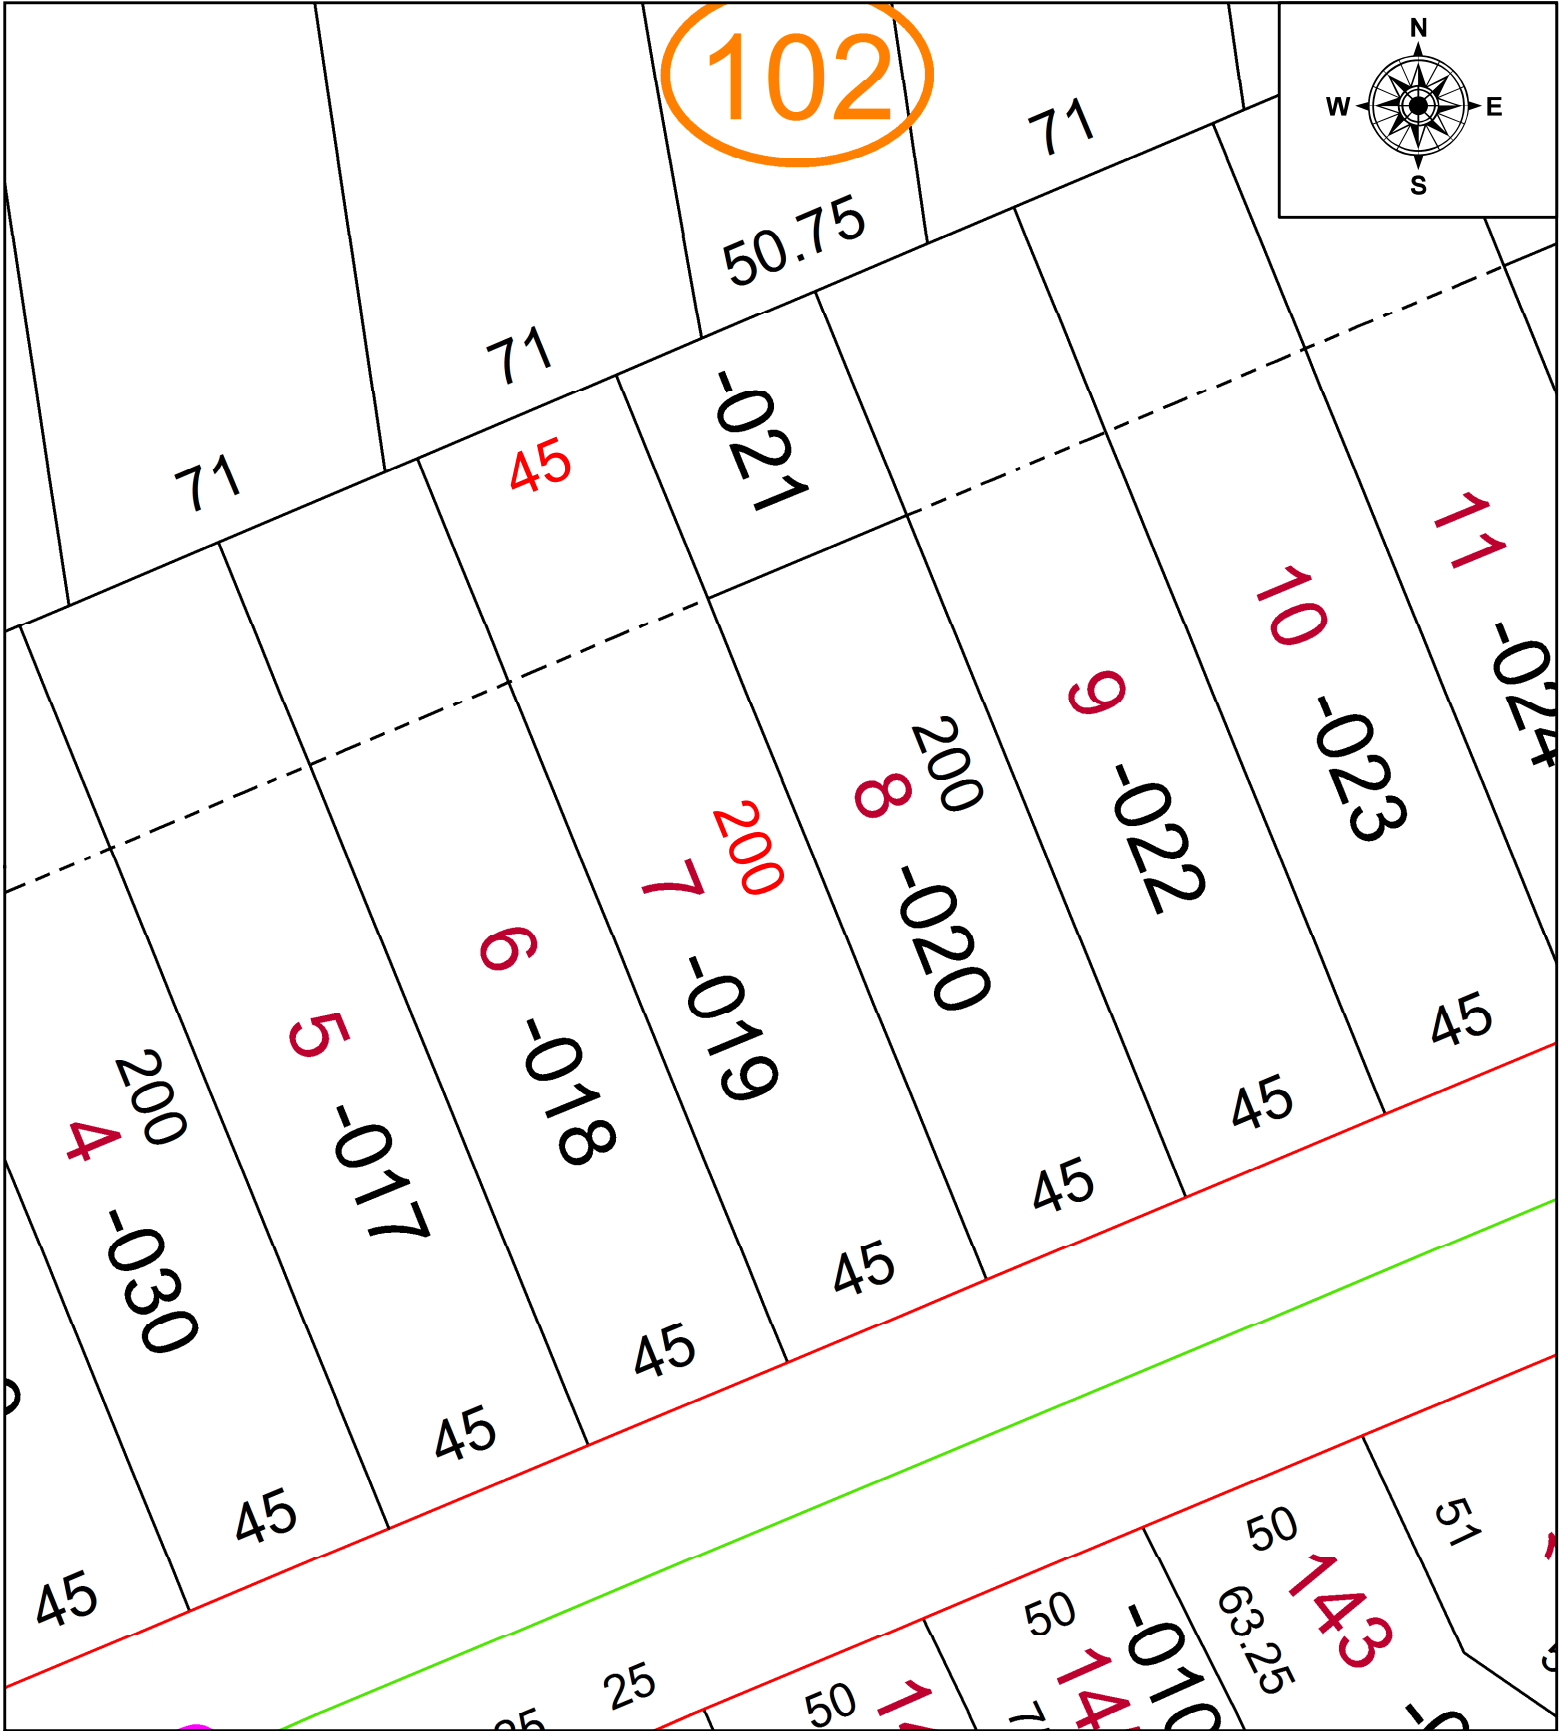

102

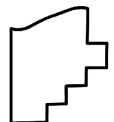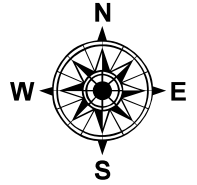

SPLITS/DEEDS PROCESSED
 LORAIN COUNTY TAX MAP DEPARTMENT
 226 MIDDLE AVE. ELYRIA, OH

SURVEYED BY: PATRICK A. MCGANNON
 CLOSURE: 1: 2147483648
 MAP PAGE(S): 03-00-047-A
 APPROVED BY: AC DATE: 10/18/2021
 SCALE: 1" = 40 PRIOR INSTRUMENT: 2021- 0802668