


PARENT PARCEL: 06-24-086-102-006 & -016

CHILD PARCEL: 06-24-086-102-037

STARTING POINT: NORTHERLY R.O.W LINE OF HURON ST & SOUTHERLY R.O.W LINE OF LOWELL ST

23-04691

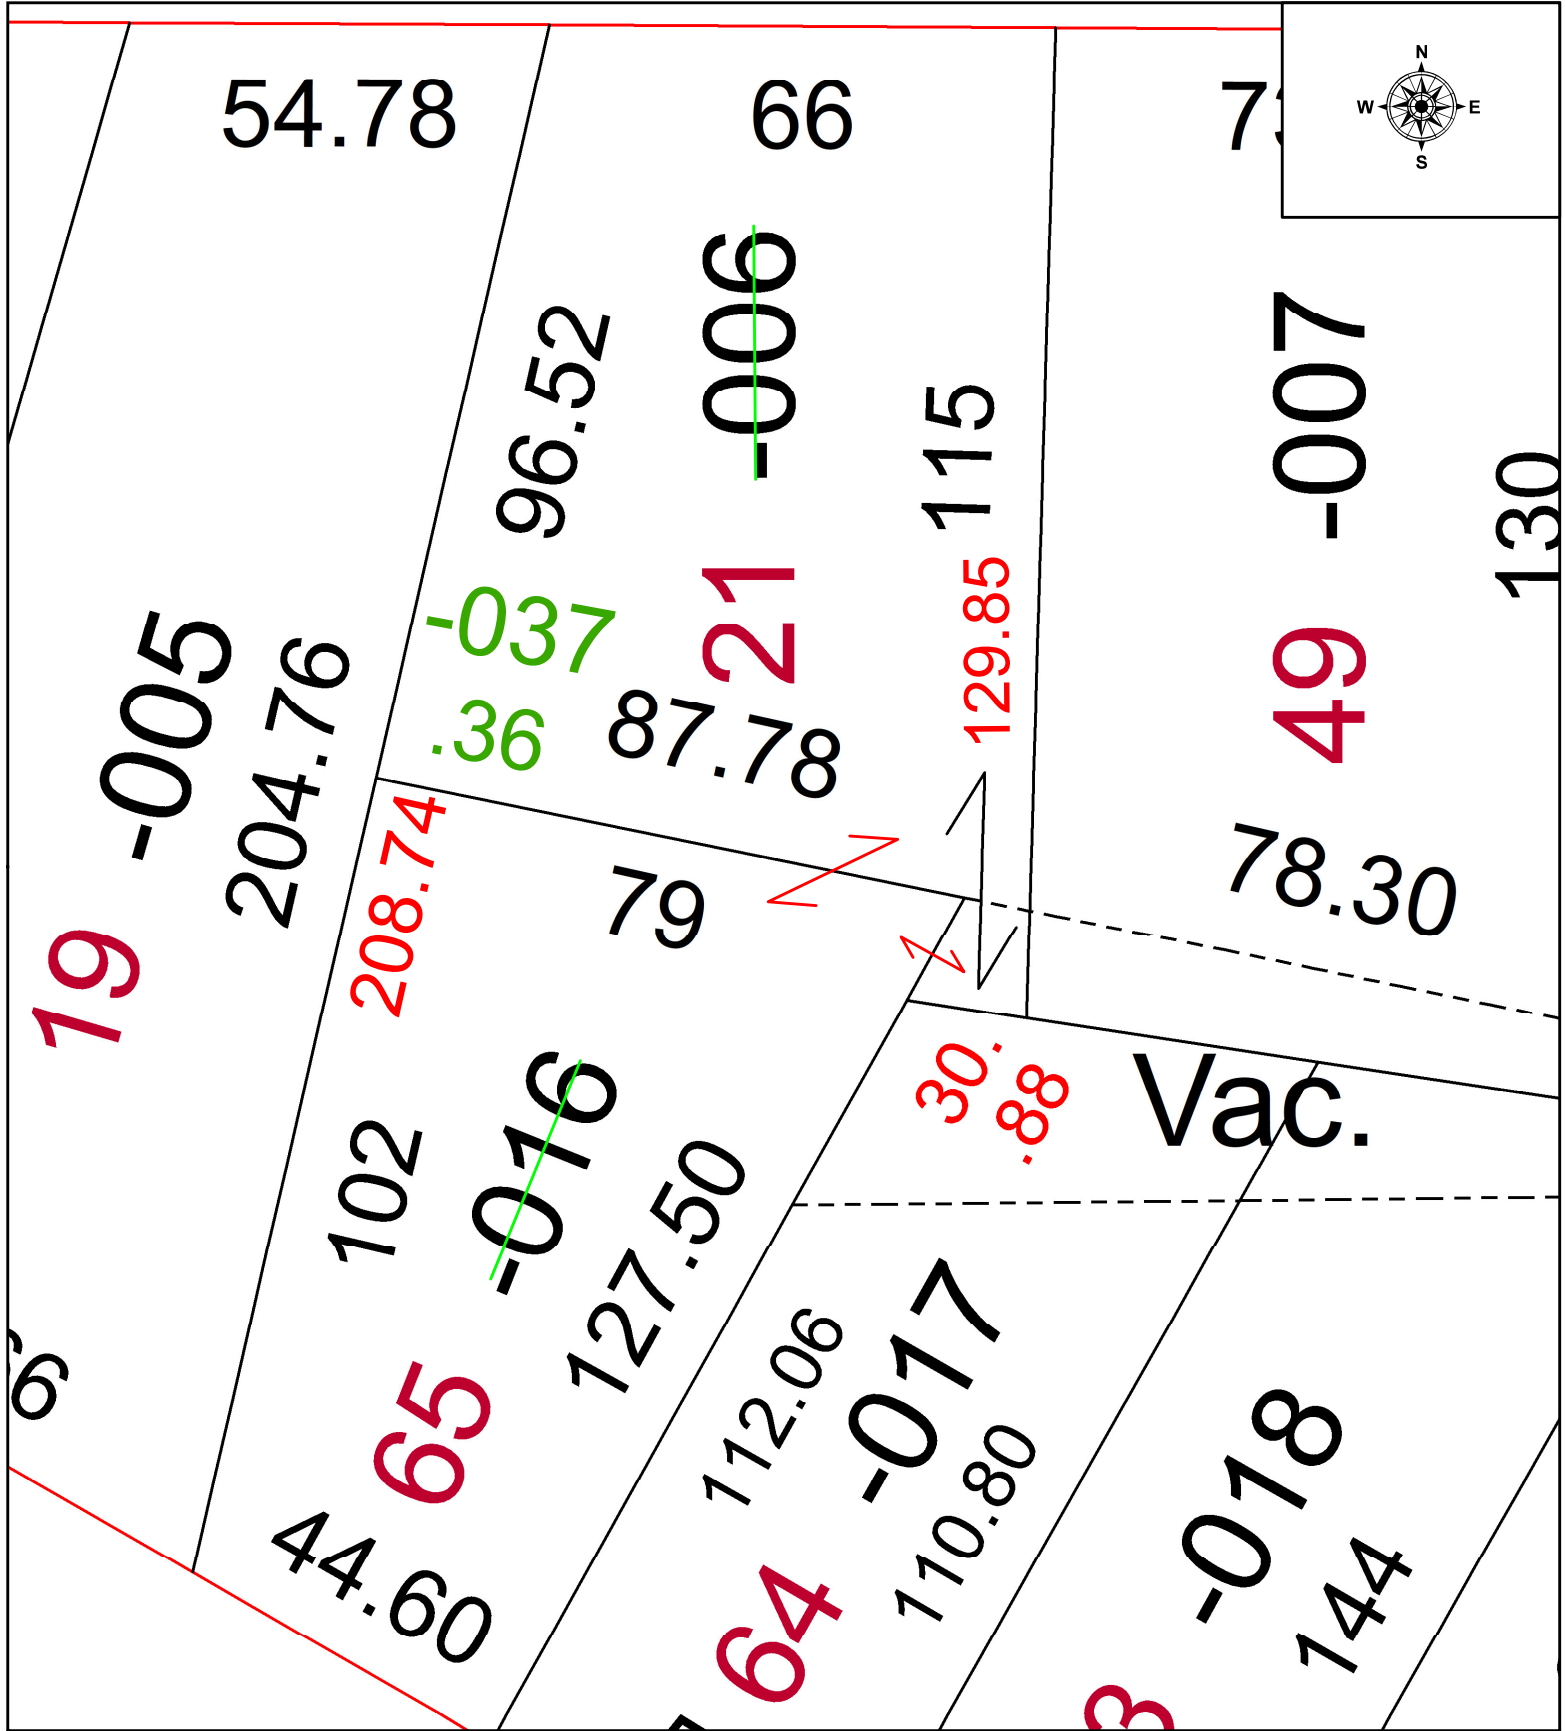

**SPLITS/DEEDS PROCESSED**  
 LORAIN COUNTY TAX MAP DEPARTMENT  
 226 MIDDLE AVE. ELYRIA, OH

SURVEYED BY: SEAN BOLAND SURVEY # 50891  
 CLOSURE: 1: 107909  
 MAP PAGE(S): 06-24-086  
 APPROVED BY: WRZ DATE: 5/16/2023  
 SCALE: 1" = 25 PRIOR INSTRUMENT: #2003-0974843