
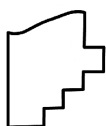


PARENT PARCEL: 04-00-014-105-069

CHILD PARCEL: 04-00-014-105-072 & -073

STARTING POINT: **AC CORR PER SURV BY AMY M. KELLY**

23-04694

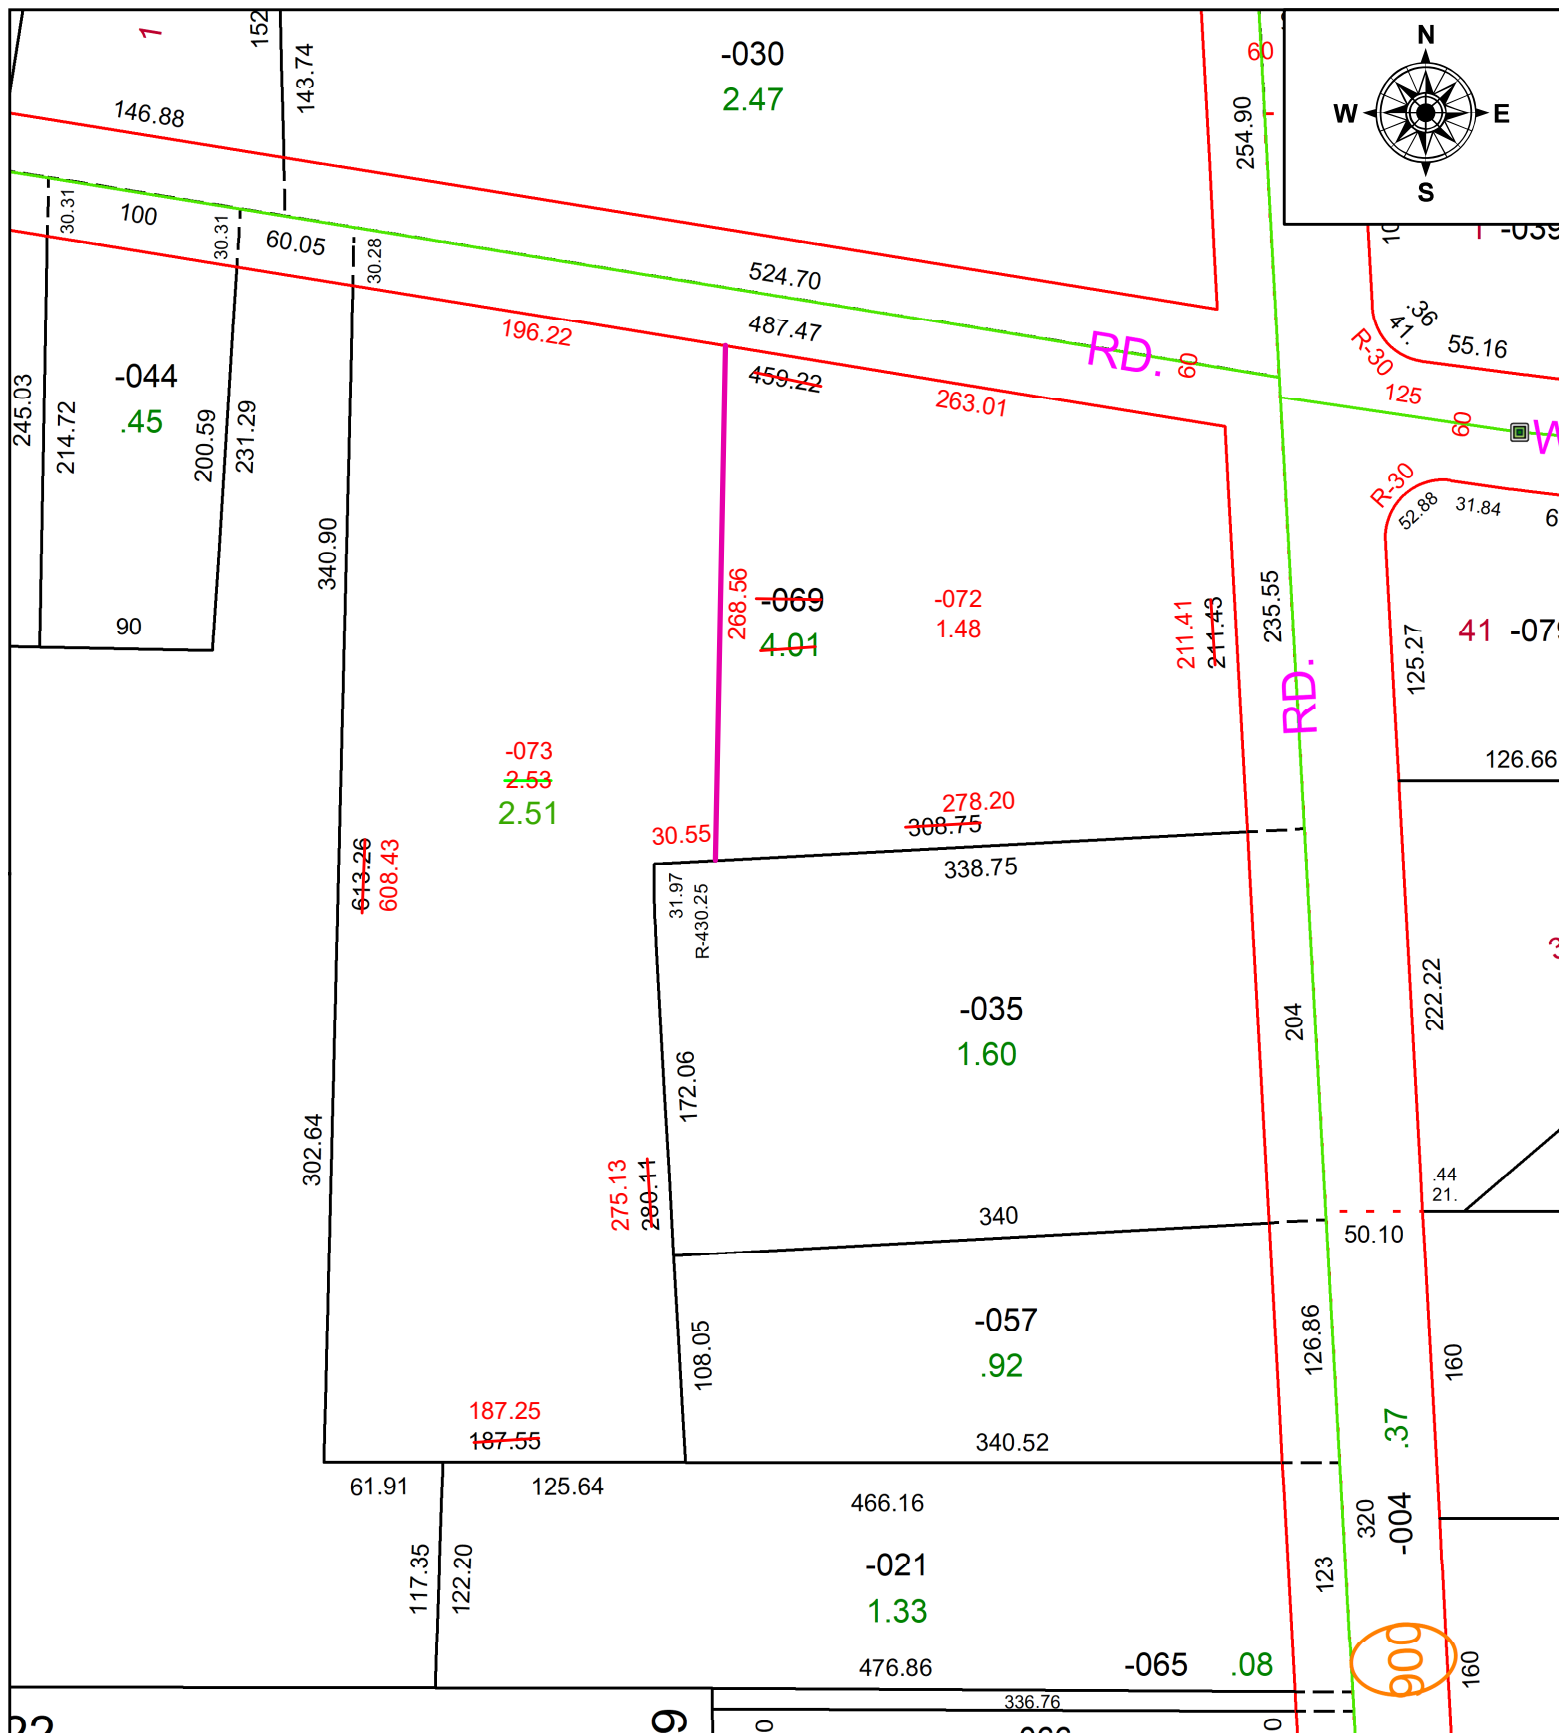

SPLITS/DEEDS PROCESSED
 LORAIN COUNTY TAX MAP DEPARTMENT
 226 MIDDLE AVE. ELYRIA, OH

SURVEYED BY: AMY M. KELLY SURV # 50896

CLOSURE: 1: 611263

MAP PAGE(S): 04-00-014-F

APPROVED BY: AC DATE: May 18, 2023

SCALE: 1 in = 100 ft PRIOR INSTRUMENT: 2015- 0542131