
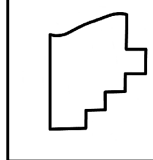


PARENT PARCEL: 03-00-038-105-001, -010, -011, -012, -013, -014, -015, -016

CHILD PARCEL: 03-00-038-105-017

STARTING POINT: N/A

23-04699

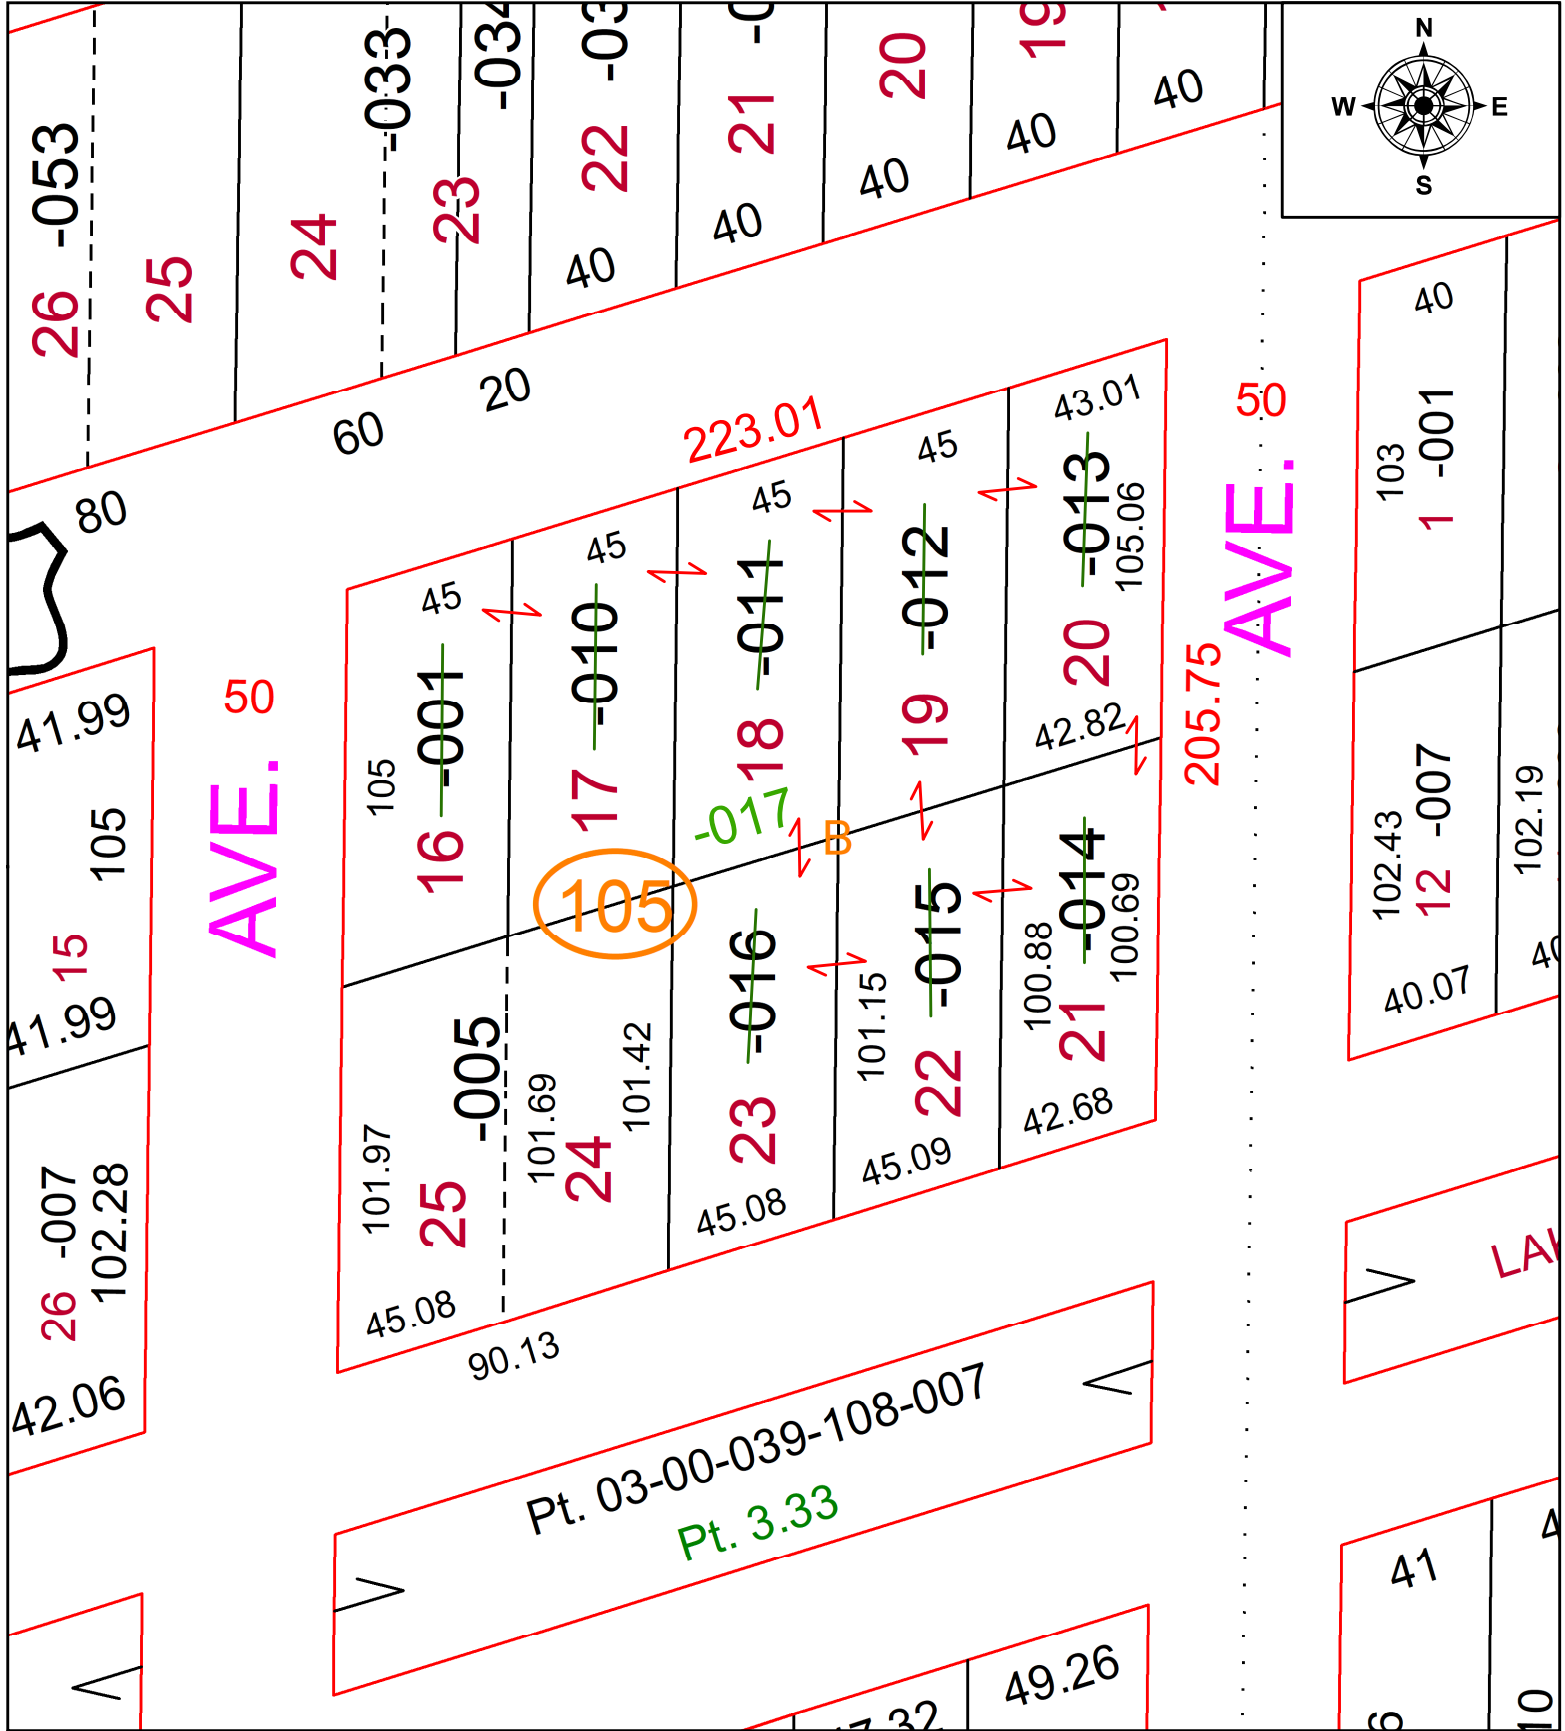

SPLITS/DEEDS PROCESSED
 LORAIN COUNTY TAX MAP DEPARTMENT
 226 MIDDLE AVE. ELYRIA, OH

SURVEYED BY: N/A SURVEY #: N/A
 CLOSURE: 1: N/A
 MAP PAGE(S): 03-00-038
 APPROVED BY: SP DATE: 5/23/2023
 SCALE: 1" = 50' PRIOR INSTRUMENT: 2022-0890972