


PARENT PARCEL: 06-23-020-000-012

CHILD PARCEL: **AC CORR PER SURV BY THOMAS A. SIMON**

STARTING POINT: SW CORNER OF O/L 20 BRACE TRACT AND C/L OF W RIVER RD

21-04700-A

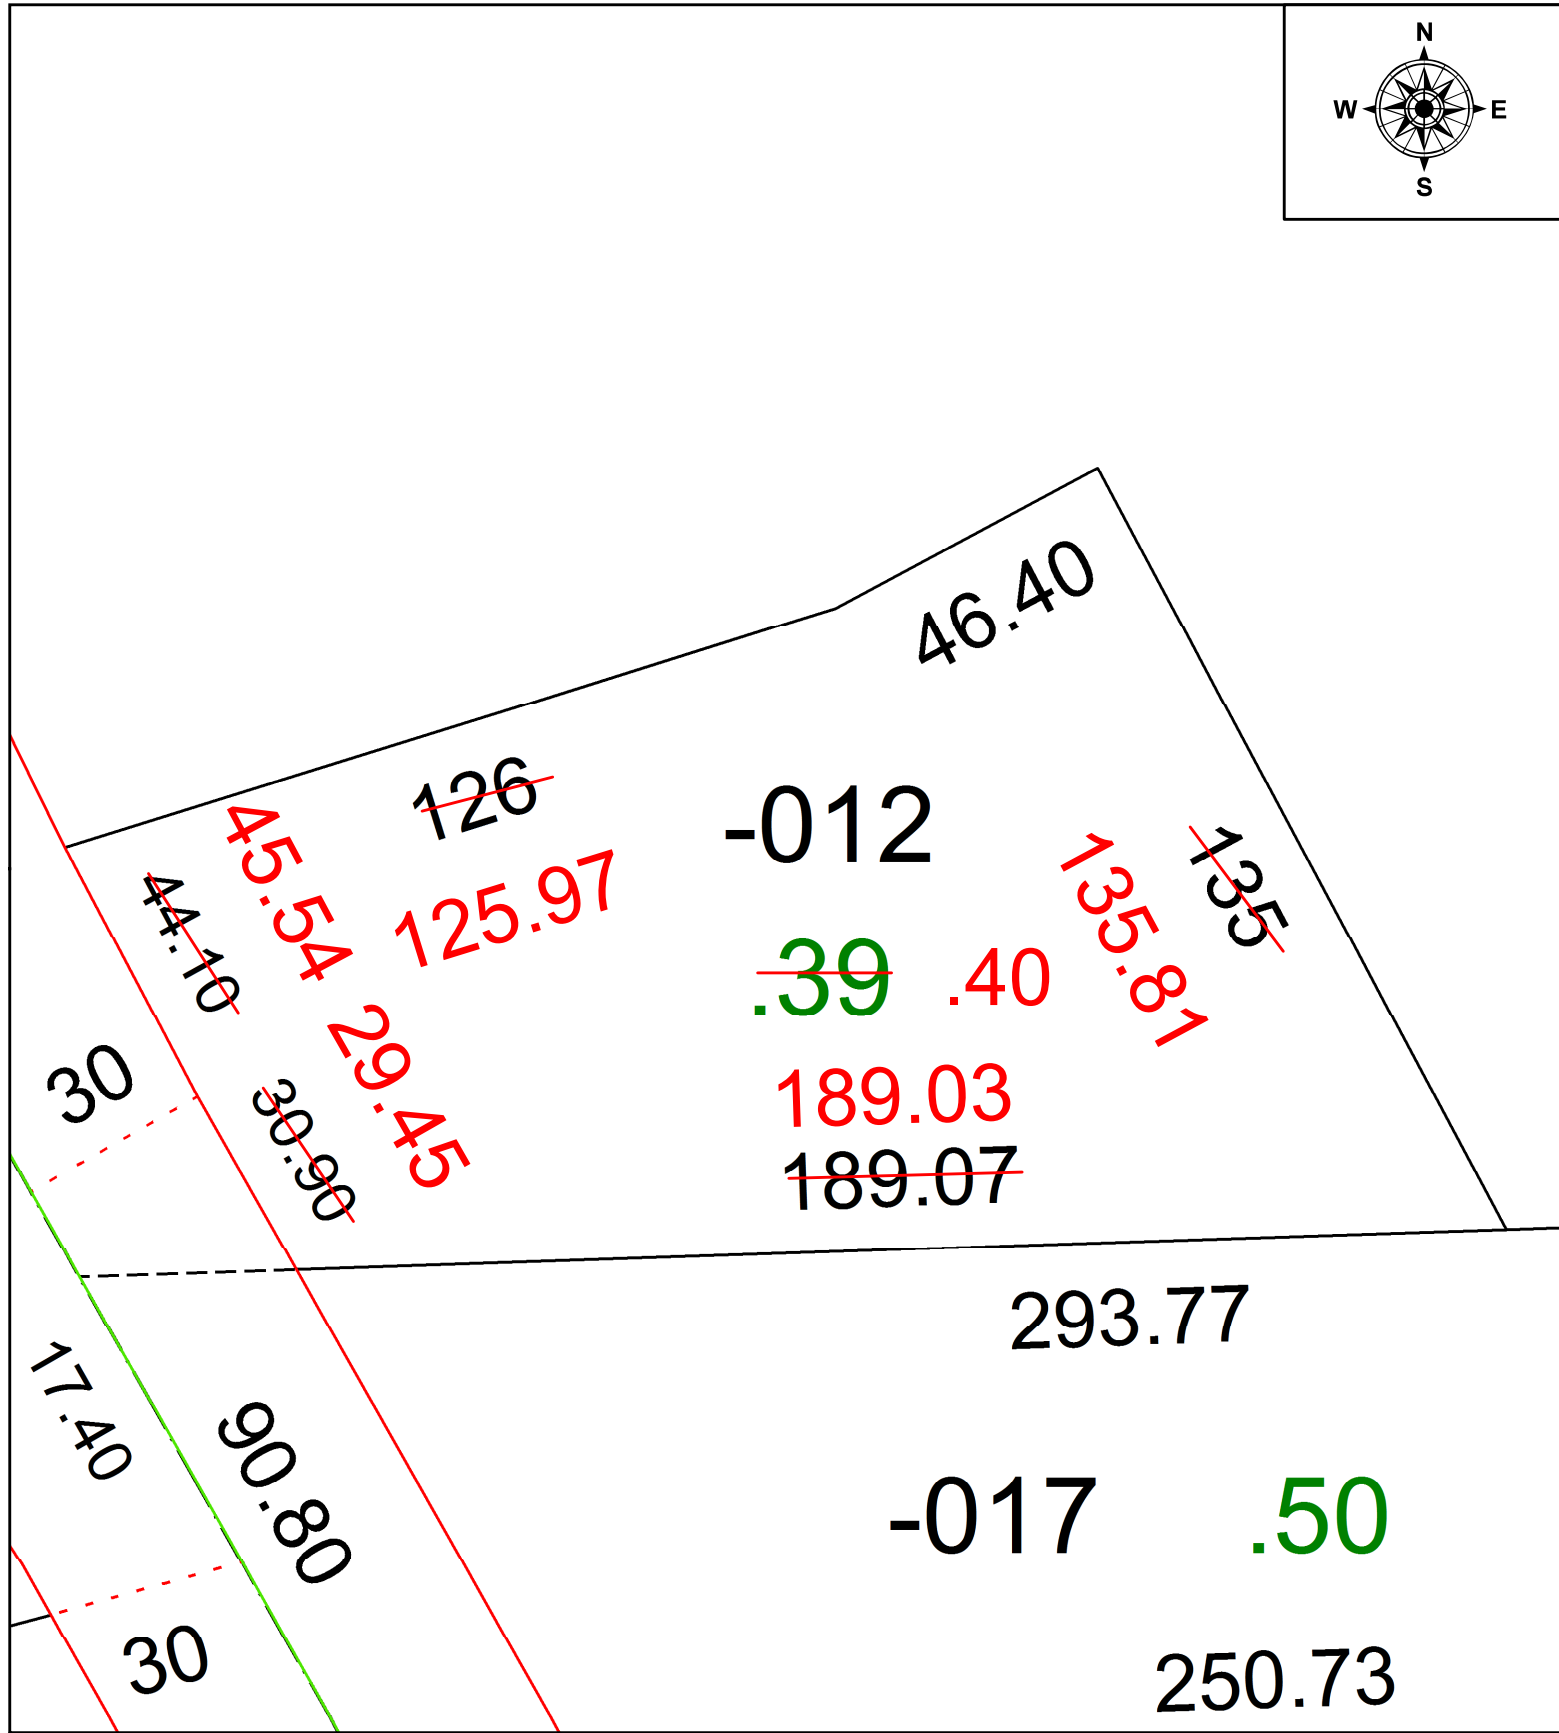

SPLITS/DEEDS PROCESSED
 LORAIN COUNTY TAX MAP DEPARTMENT
 226 MIDDLE AVE. ELYRIA, OH

SURVEYED BY: THOMAS A. SIMON

CLOSURE: 1: 106464

MAP PAGE(S): 06-23-020

APPROVED BY: AC DATE: 10/21/2021

SCALE: 1" = 30 PRIOR INSTRUMENT: 2017- 0646572