


PARENT PARCEL: 02-02-014-101-006, -008, & 02-02-015-101-001 (S.T.)


CHILD PARCEL: 02-02-014-101-021 THRU -025 ACREAGE CORRECTION PER SURVEYOR JAMES RESAR

STARTING POINT: IRON MONUMENT IN C/L OF MEISTER RD & NORTHEAST CORNER OF O.L. 14

23-04700

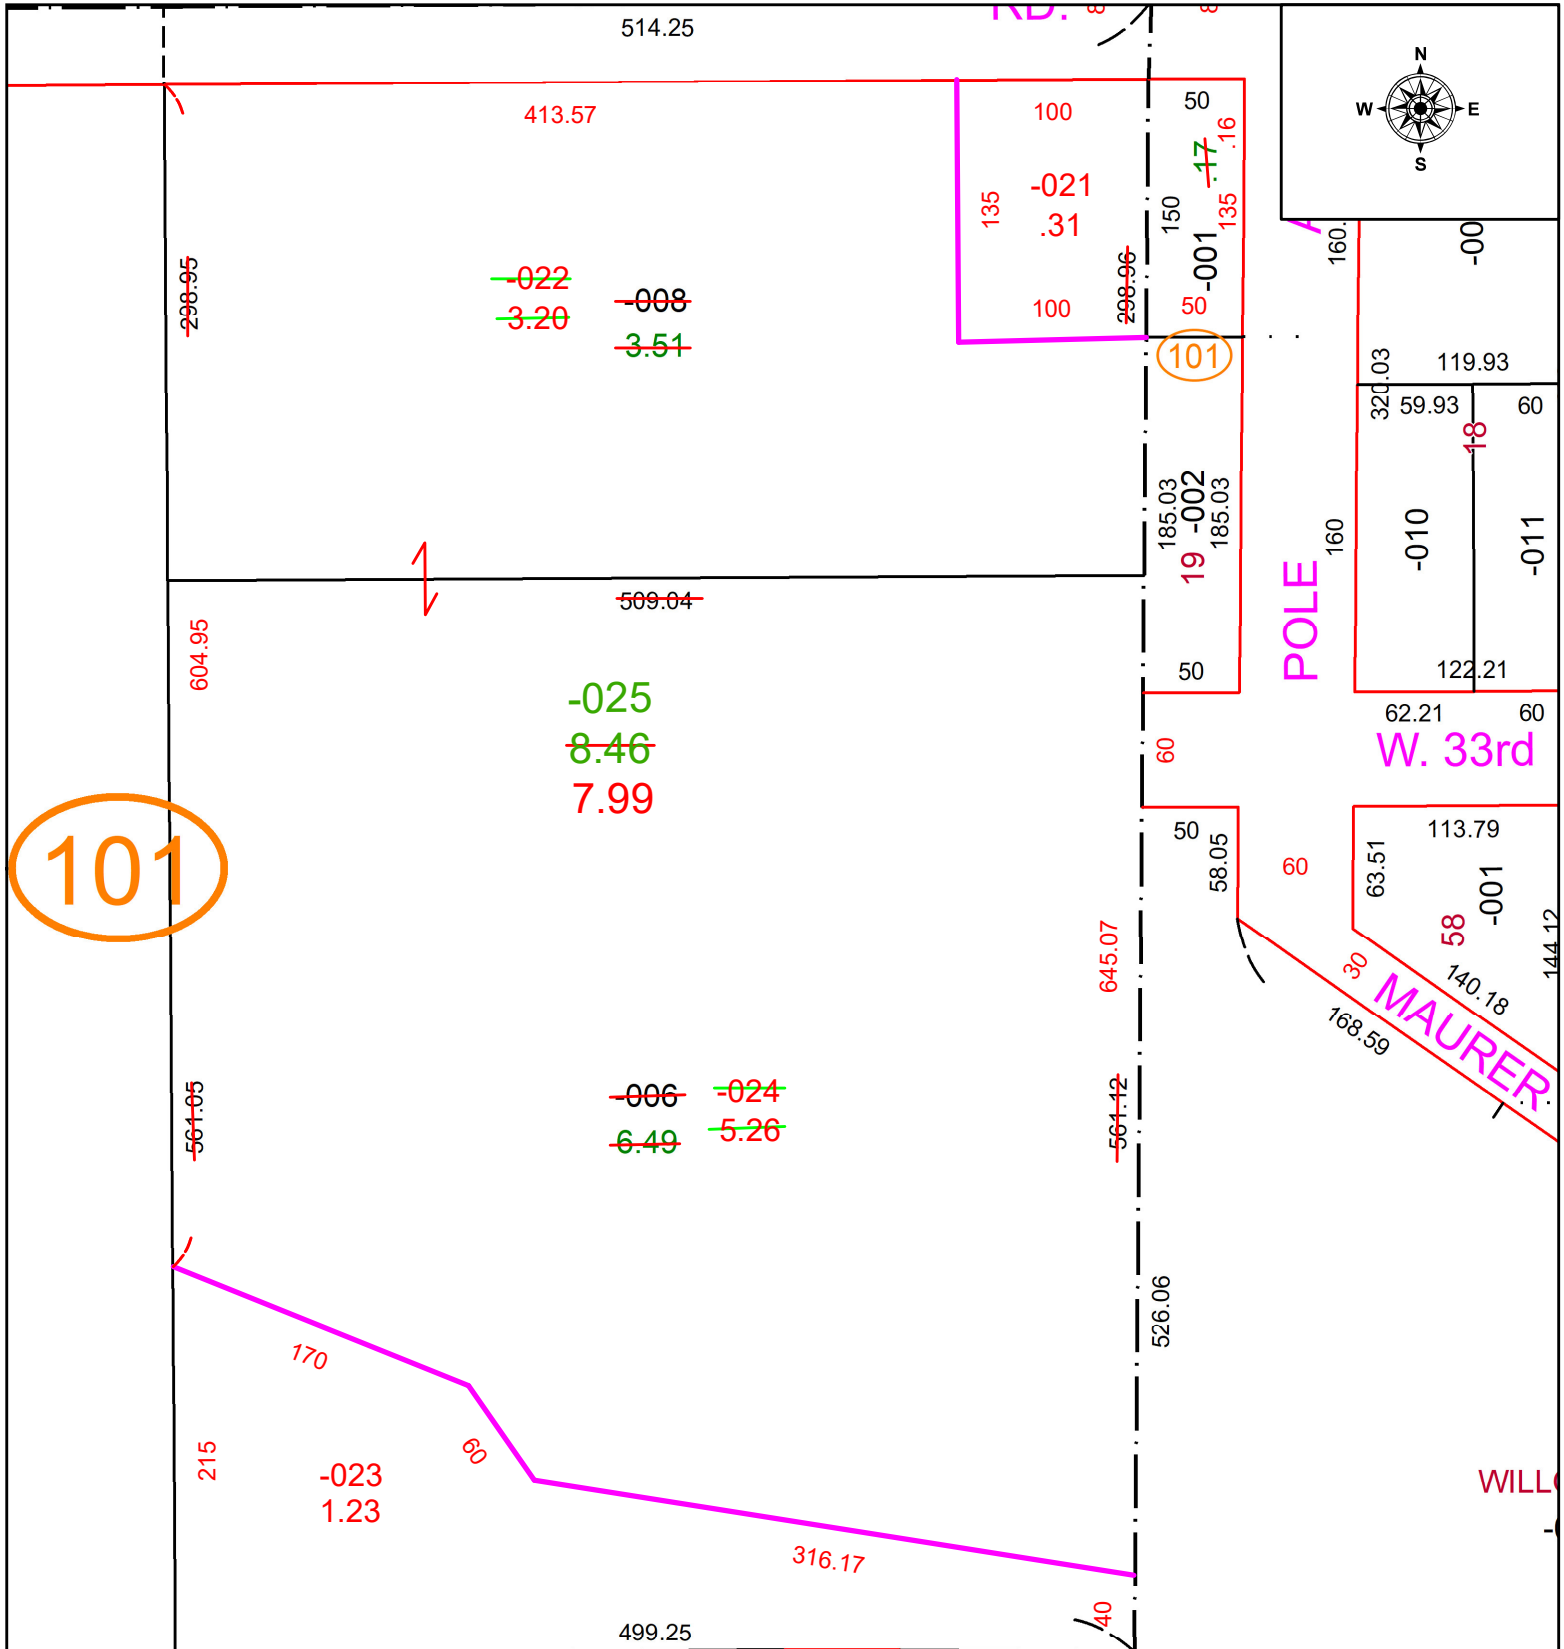

70.40	70.40	70.40	70.40	70.40	75	60	122.60
7	8	9	0	1	2	R	-001

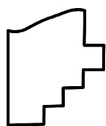

SPLITS/DEEDS PROCESSED
 LORAIN COUNTY TAX MAP DEPARTMENT
 226 MIDDLE AVE. ELYRIA, OH

SURVEYED BY: JAMES RESAR SURVEY # 50900
 CLOSURE: 1: 263566
 MAP PAGE(S): 02-02-014 & 02-02-015
 APPROVED BY: WRZ DATE: 5/24/2023
 SCALE: 1" = 100 PRIOR INSTRUMENT: DV 942 PG 128