
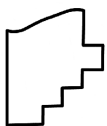
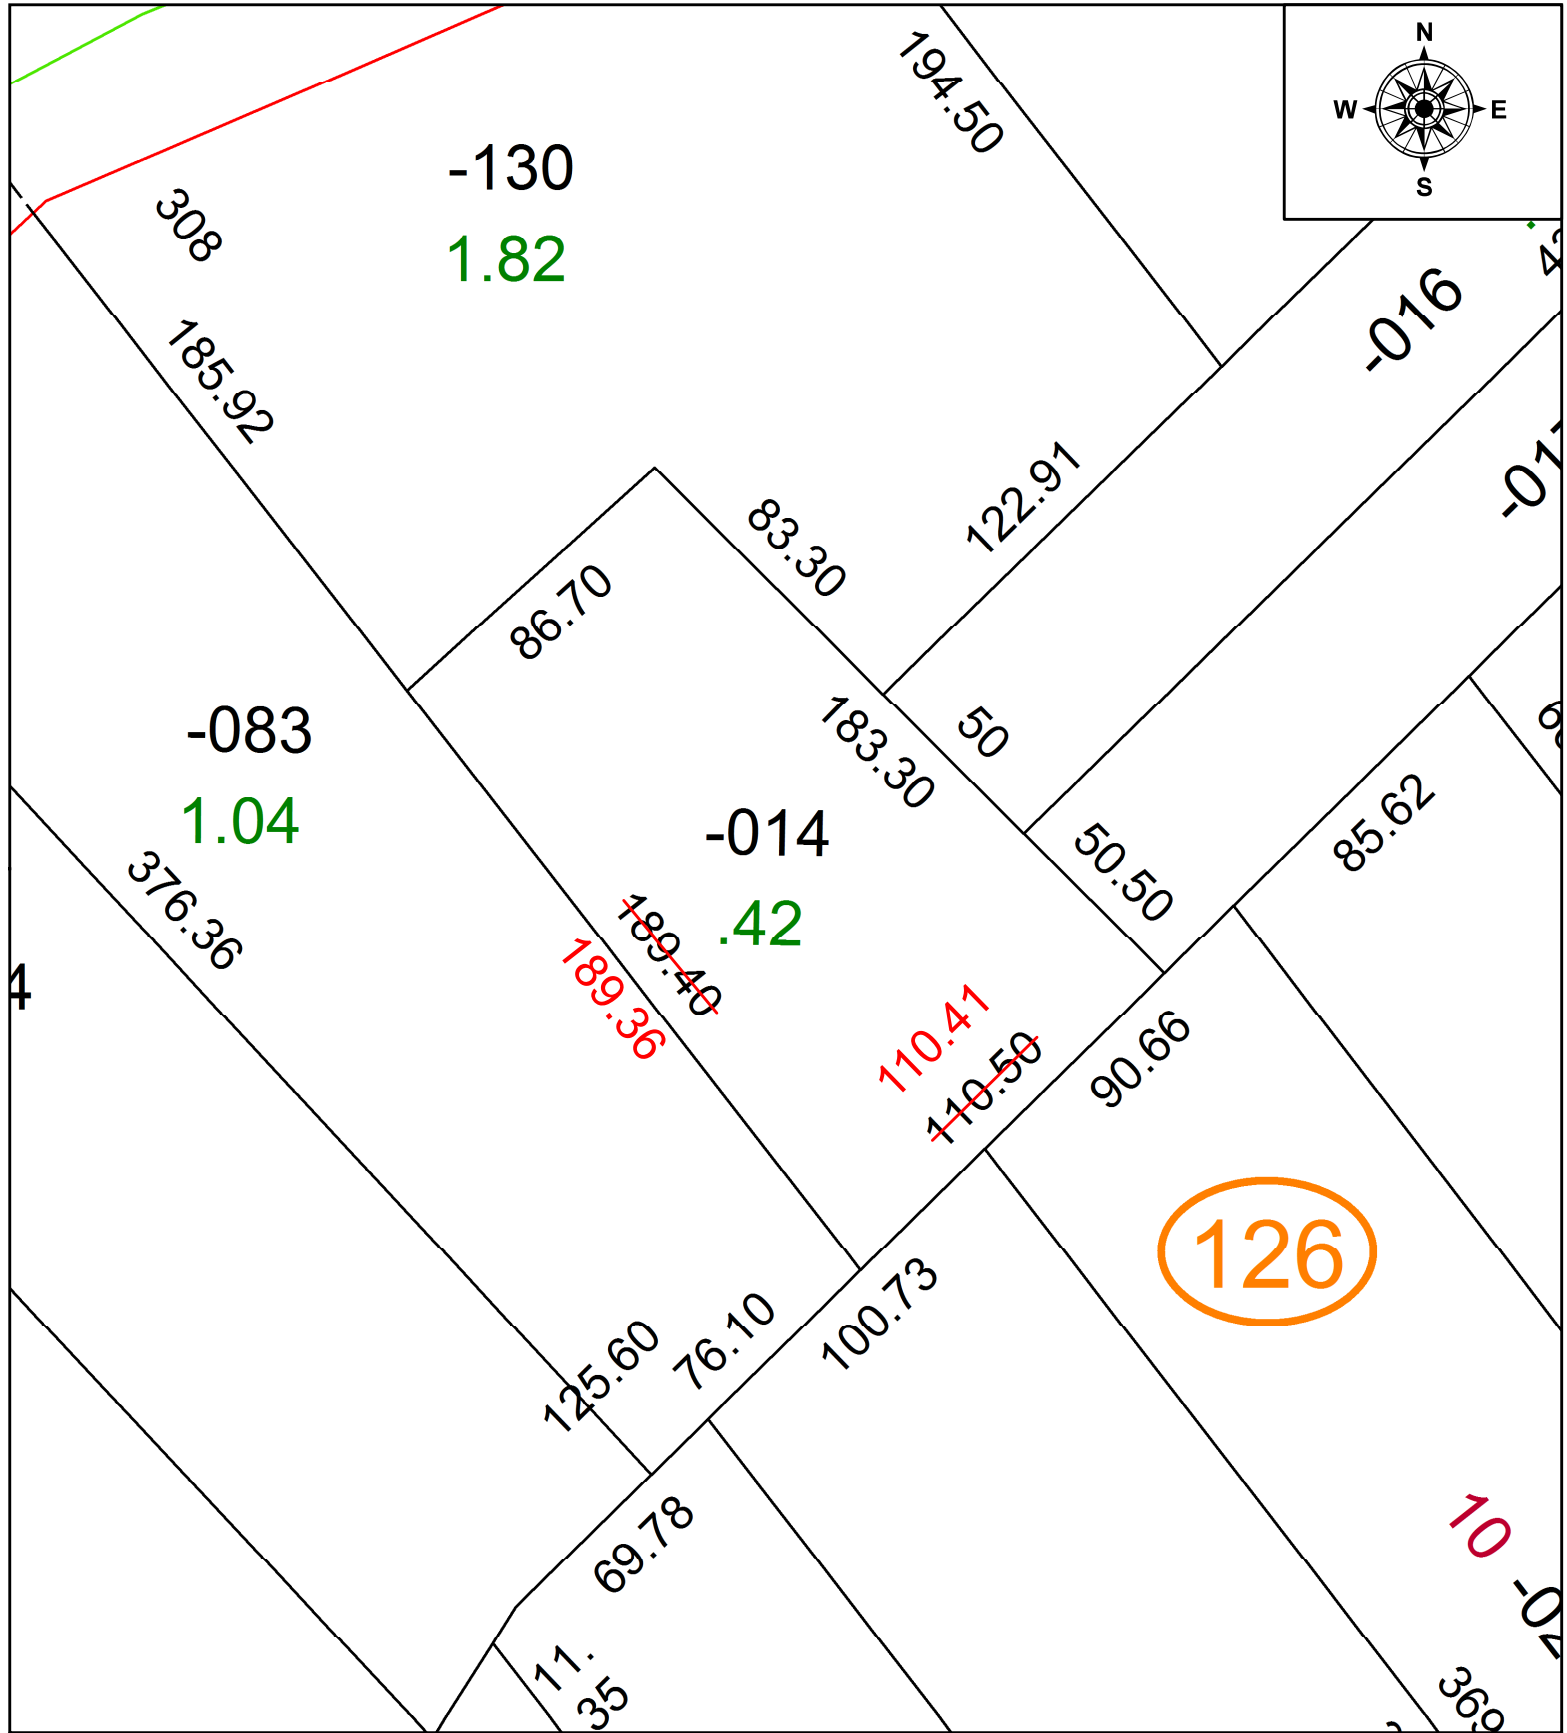


PARENT PARCEL: 10-00-006-126-014

CHILD PARCEL: **MAP CORRECTION ONLY**

STARTING POINT: C/L OF GRATON AND ROBSON RD

21-04701-A

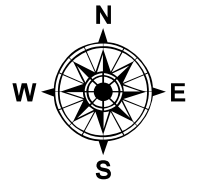

**SPLITS/DEEDS PROCESSED**  
LORAIN COUNTY TAX MAP DEPARTMENT  
226 MIDDLE AVE. ELYRIA, OH

SURVEYED BY: SEAN A. BOLAND  
CLOSURE: 1: 99812  
MAP PAGE(S): 10-00-006  
APPROVED BY: AC DATE: 10/22/2021  
SCALE: 1" = 50 PRIOR INSTRUMENT: 2018- 0697254