




PARENT PARCEL: 11-00-051-000-114, 11-00-052-000-001 & 11-00-070-000-046, -074, -127

CHILD PARCEL: 11-00-070-000-168 THRU -171 & STR. TRNS 11-00-051-000-114 & -052-000-001

STARTING POINT: CL OF ARCHER RD. & BUTTERNUT RIDGE RD.

23-04701

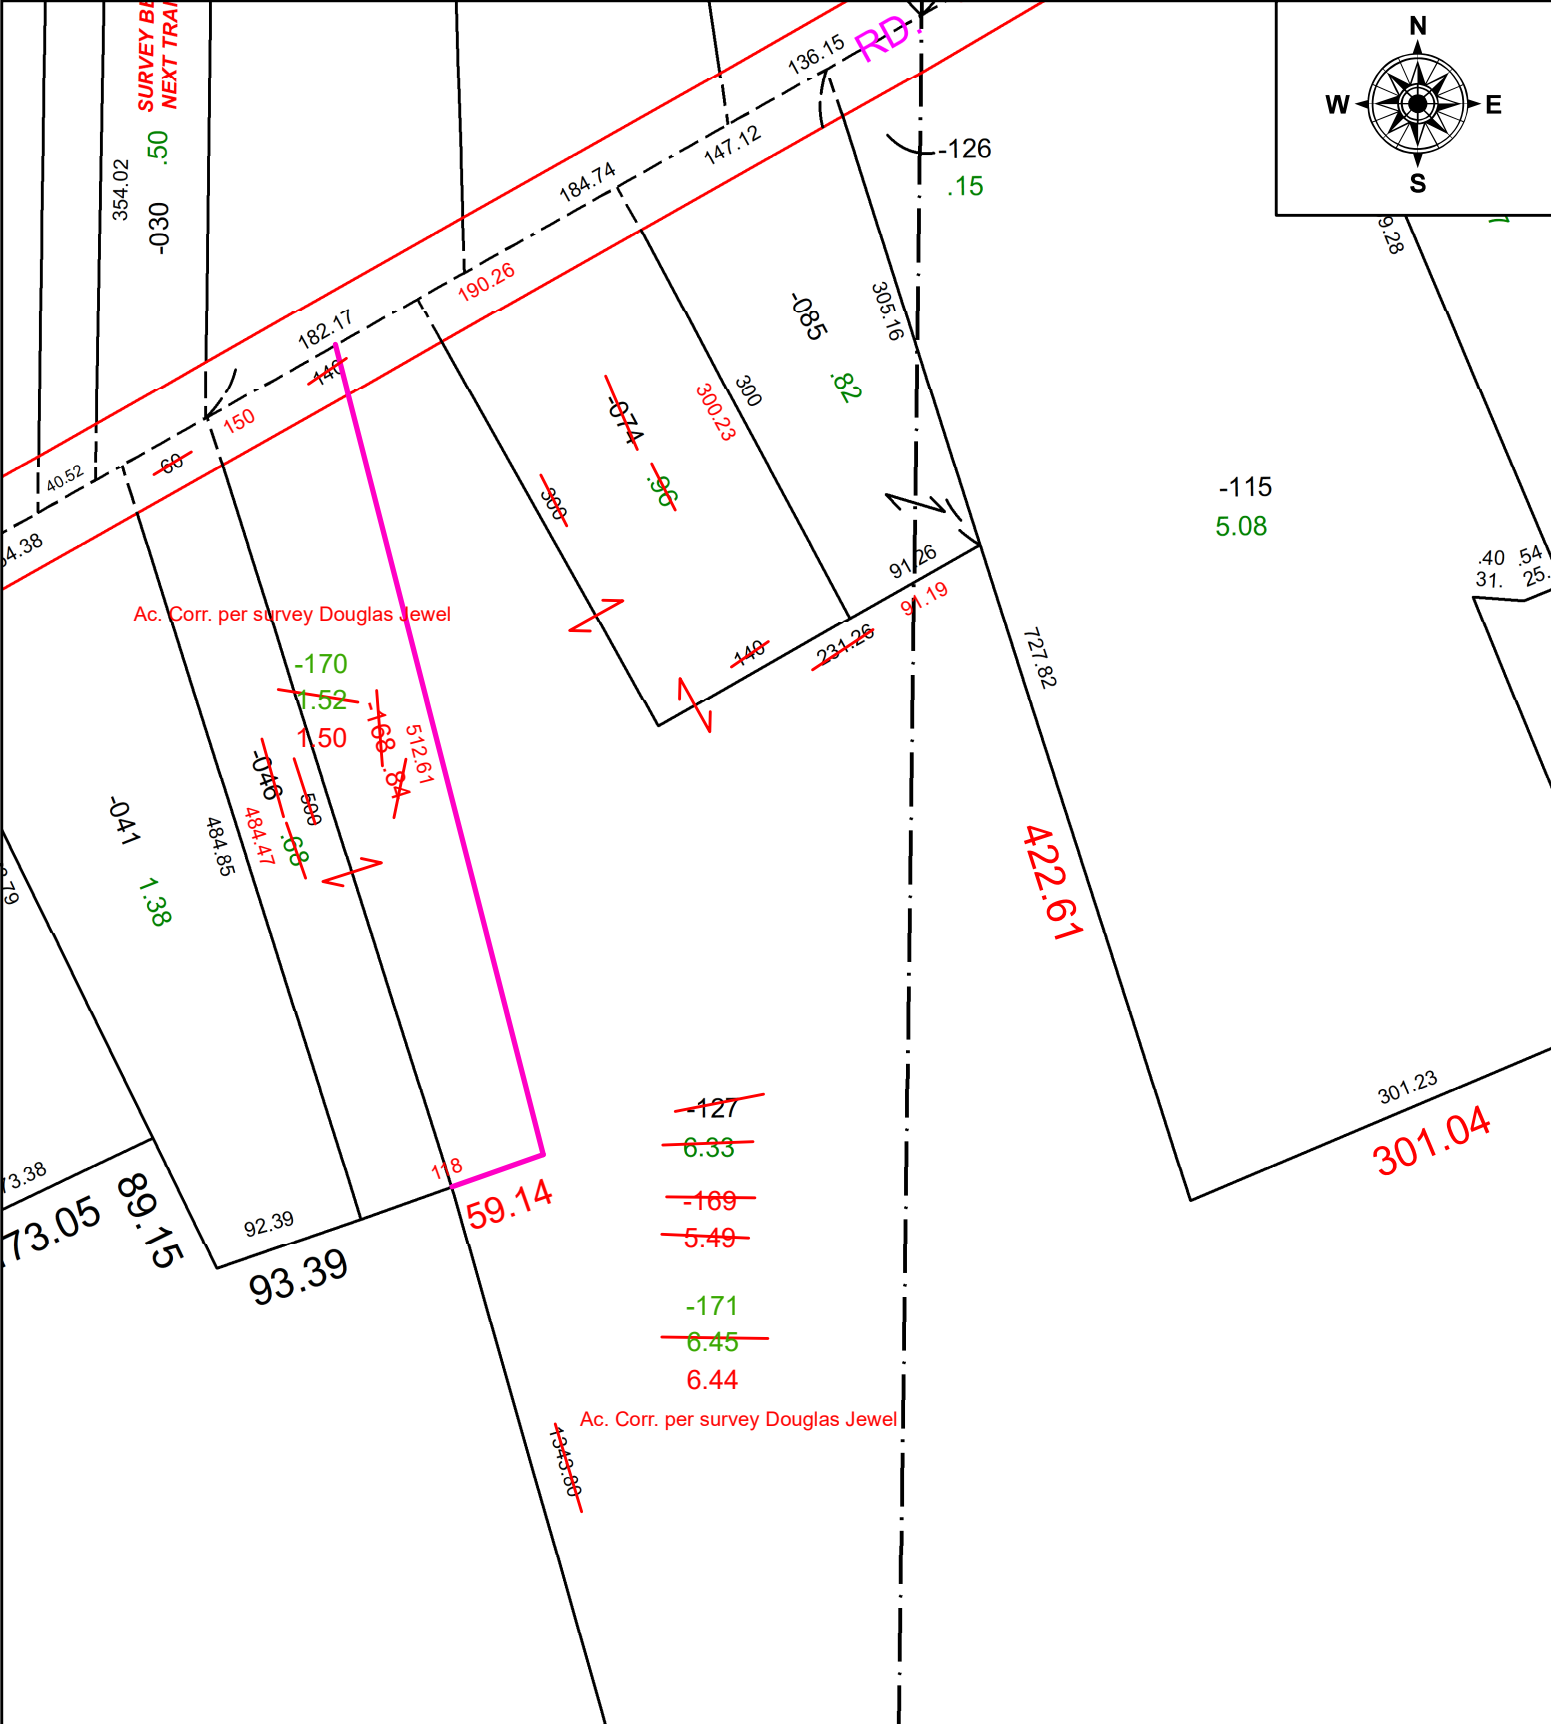

**SPLITS/DEEDS PROCESSED**  
 LORAIN COUNTY TAX MAP DEPARTMENT  
 226 MIDDLE AVE. ELYRIA, OH

**SURVEYED BY:** DOUGLAS JEWEL      **SURVEY #:** 50905  
**CLOSURE:** 1:396076  
**MAP PAGE(S):** 11-00-051, -052 & -070  
**APPROVED BY:** DMA      **DATE:** 5/30/2023  
**SCALE:** 1" = 400'      **PRIOR INSTRUMENT:** 2016-0604297