


PARENT PARCEL: 07-00-021-117-086 & -088

CHILD PARCEL: 07-00-021-117-099

STARTING POINT: AC CORR PER SURV BY MATTHEW A. HILDEBRANDT

23-04702

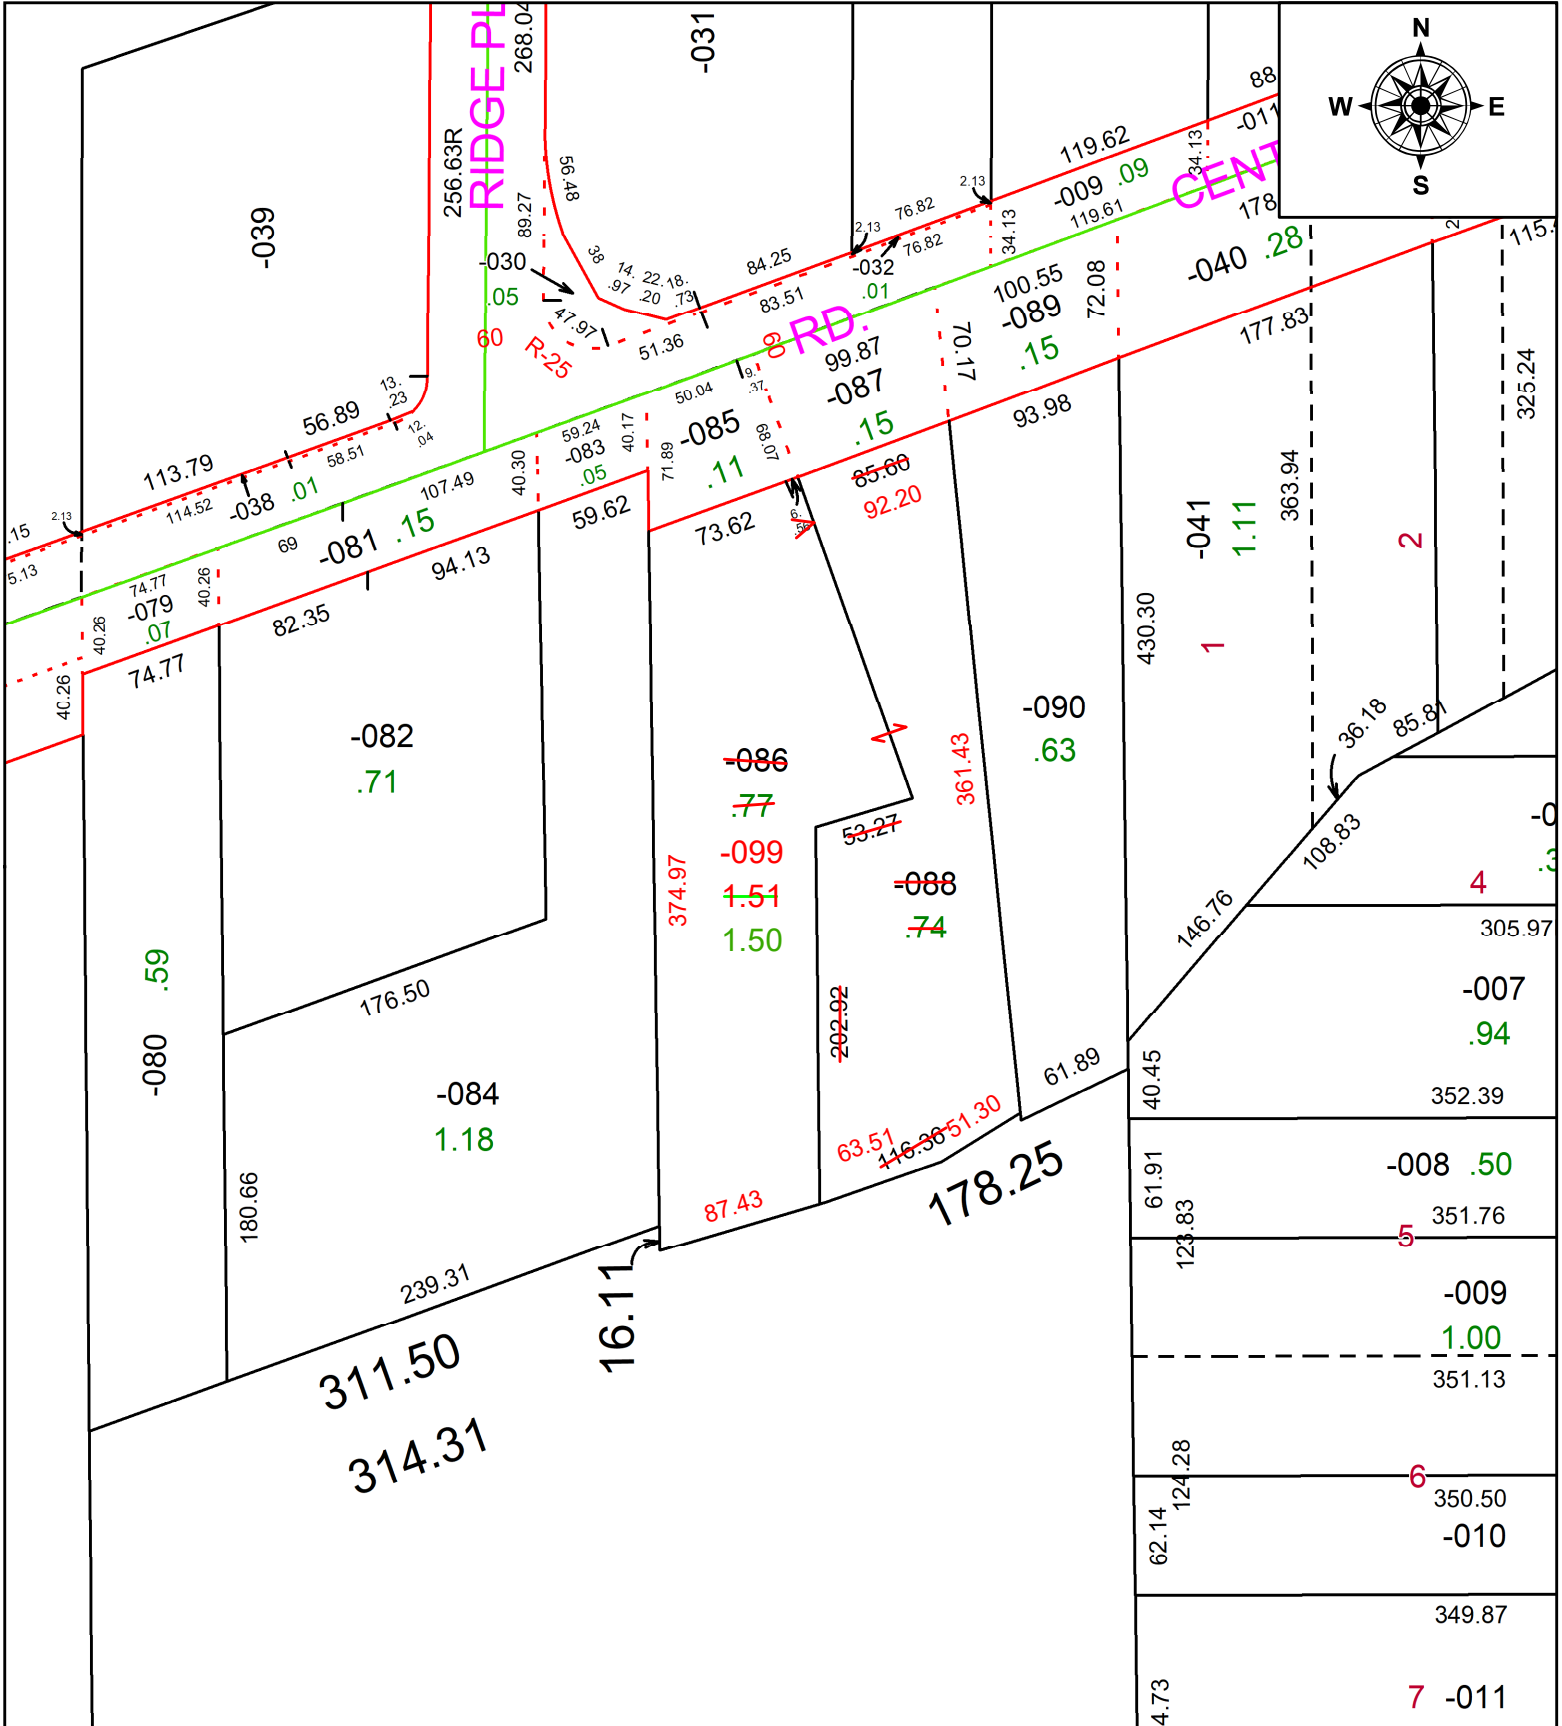

SPLITS/DEEDS PROCESSED
 LORAIN COUNTY TAX MAP DEPARTMENT
 226 MIDDLE AVE. ELYRIA, OH

SURVEYED BY: MATTHEW A. HILDEBRANDT **SURV #** 50901
CLOSURE: 1: 260573
MAP PAGE(S): 07-00-021
APPROVED BY: AC **DATE:** May 24, 2023
SCALE: 1 in = 100 ft **PRIOR INSTRUMENT:** 2021- 0854243