
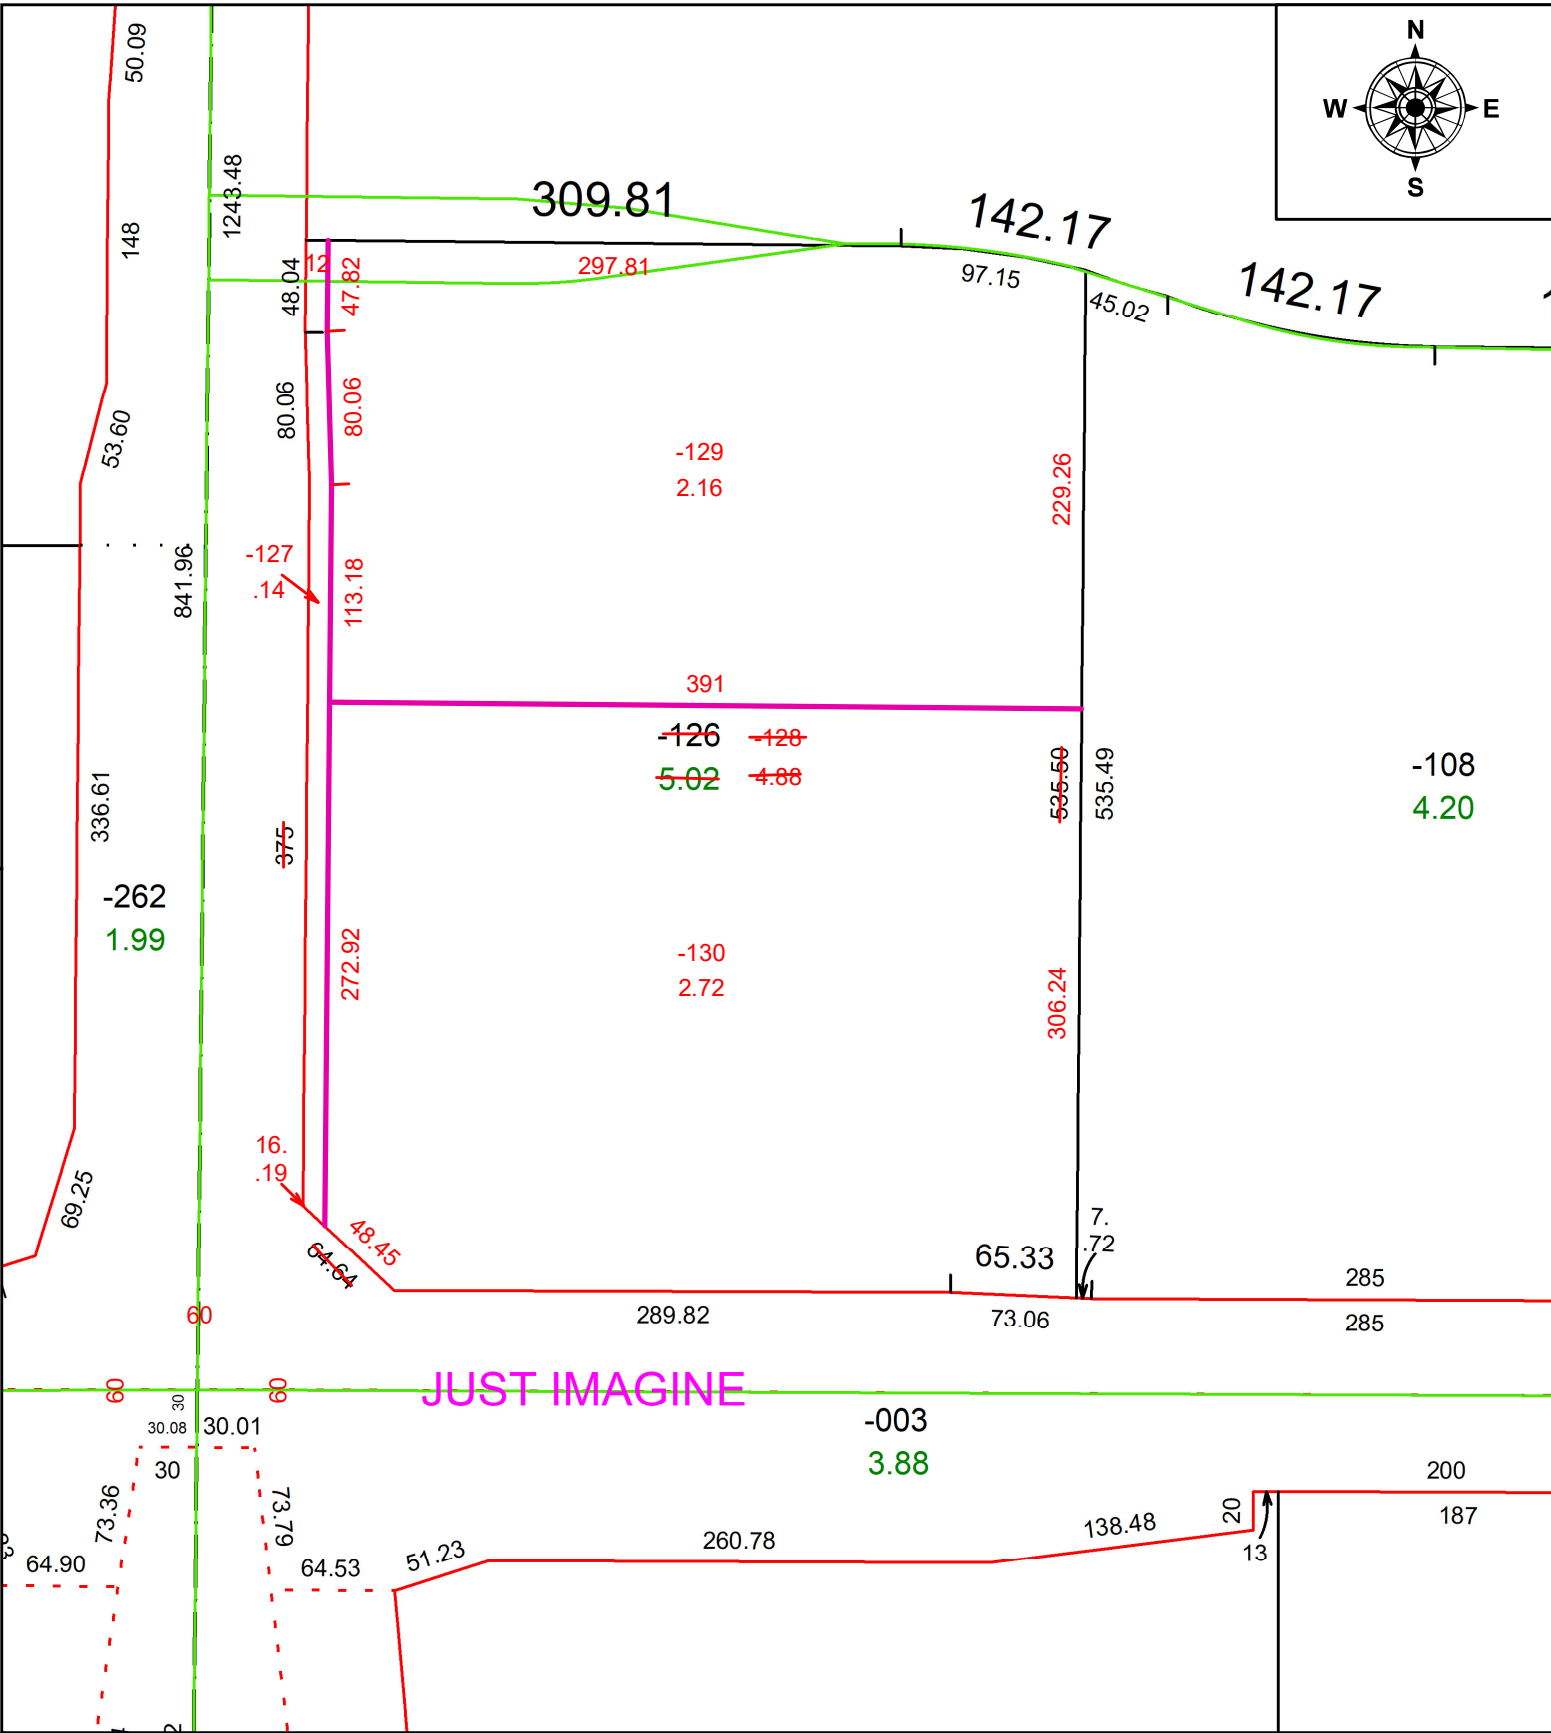


PARENT PARCEL: 04-00-028-101-126
 CHILD PARCEL: 04-00-028-101-127, -128, -129, & -130
 STARTING POINT: **AC CORR PER SURV BY AMY M. KELLY**

23-04704

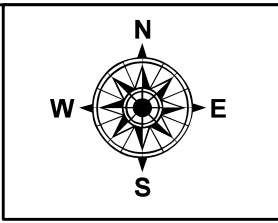

SPLITS/DEEDS PROCESSED
 LORAIN COUNTY TAX MAP DEPARTMENT
 226 MIDDLE AVE. ELYRIA, OH

SURVEYED BY: AMY M. KELLY SURV # 50906
 CLOSURE: 1: 127216
 MAP PAGE(S): 04-00-021-E
 APPROVED BY: AC DATE: June 14, 2023
 SCALE: 1 in = 100 ft PRIOR INSTRUMENT: 2020- 0756799