


PARENT PARCEL: 07-00-011-103-007, -008, & -036

CHILD PARCEL: 07-00-011-103-228, -229, & -230

STARTING POINT: MONUMENT BOX @ INTERSECTION OF C/LS BUTTERNUT RIDGE RD & ROOT RD

23-04706

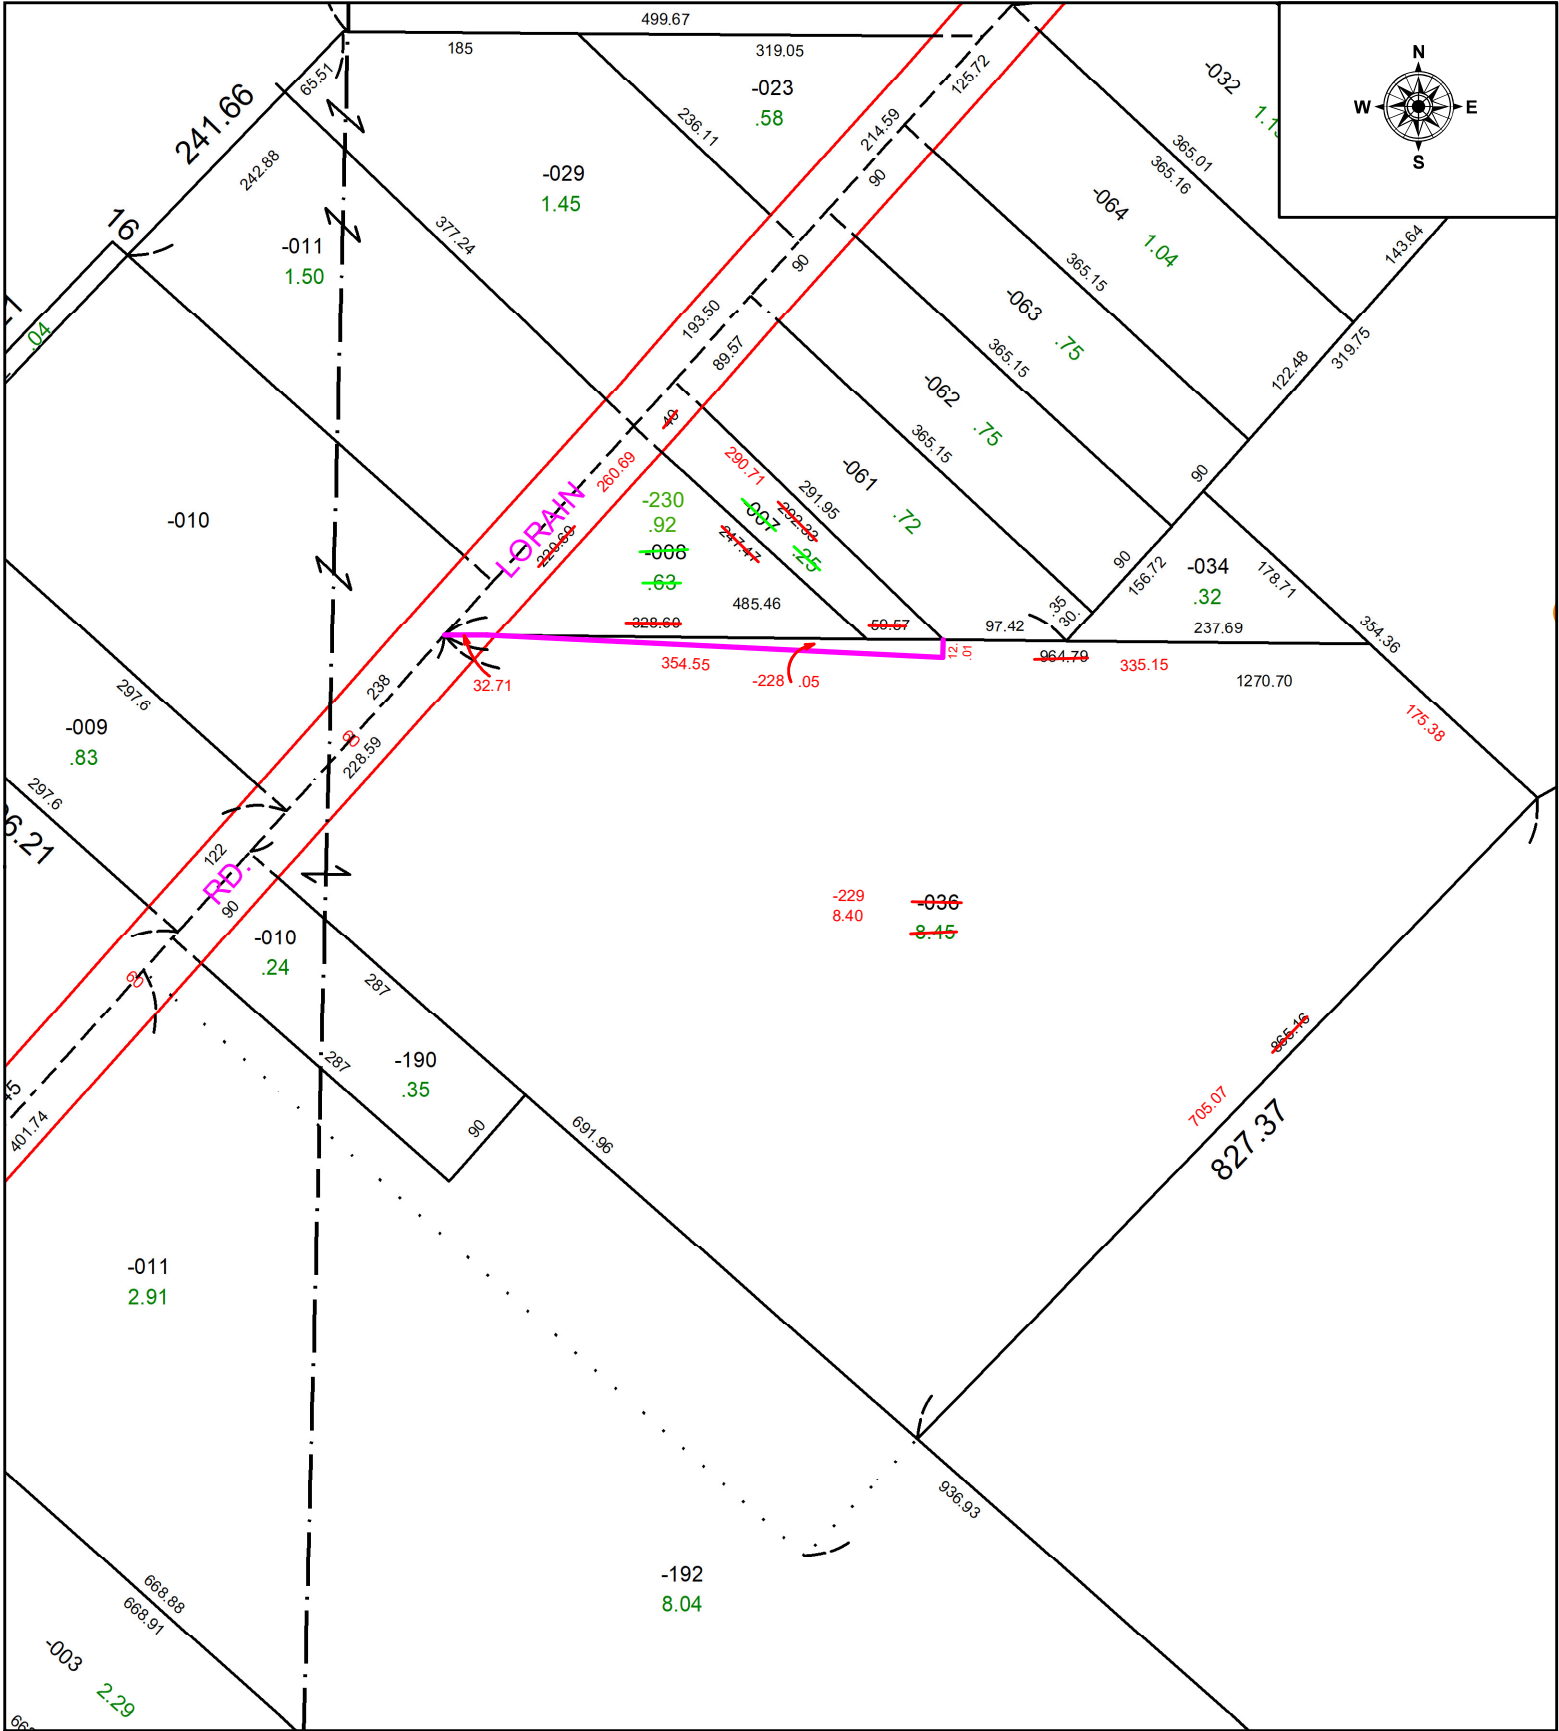

**SPLITS/DEEDS PROCESSED**  
 LORAIN COUNTY TAX MAP DEPARTMENT  
 226 MIDDLE AVE. ELYRIA, OH

SURVEYED BY: PATRICK MCGANNON	SURVEY # 50908
CLOSURE: 1: 131376	
MAP PAGE(S): 07-00-011	
APPROVED BY: WRZ	DATE: 6/6/2023
SCALE: 1" = 150	PRIOR INSTRUMENT: #2022-0868283