
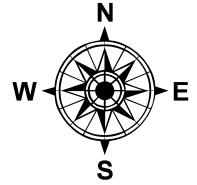


PARENT PARCEL: 04-00-027-101-176

CHILD PARCEL: 04-00-027-101-205 & -206

STARTING POINT: C/L OF PINE CT AND WALNUT DR

23-04707

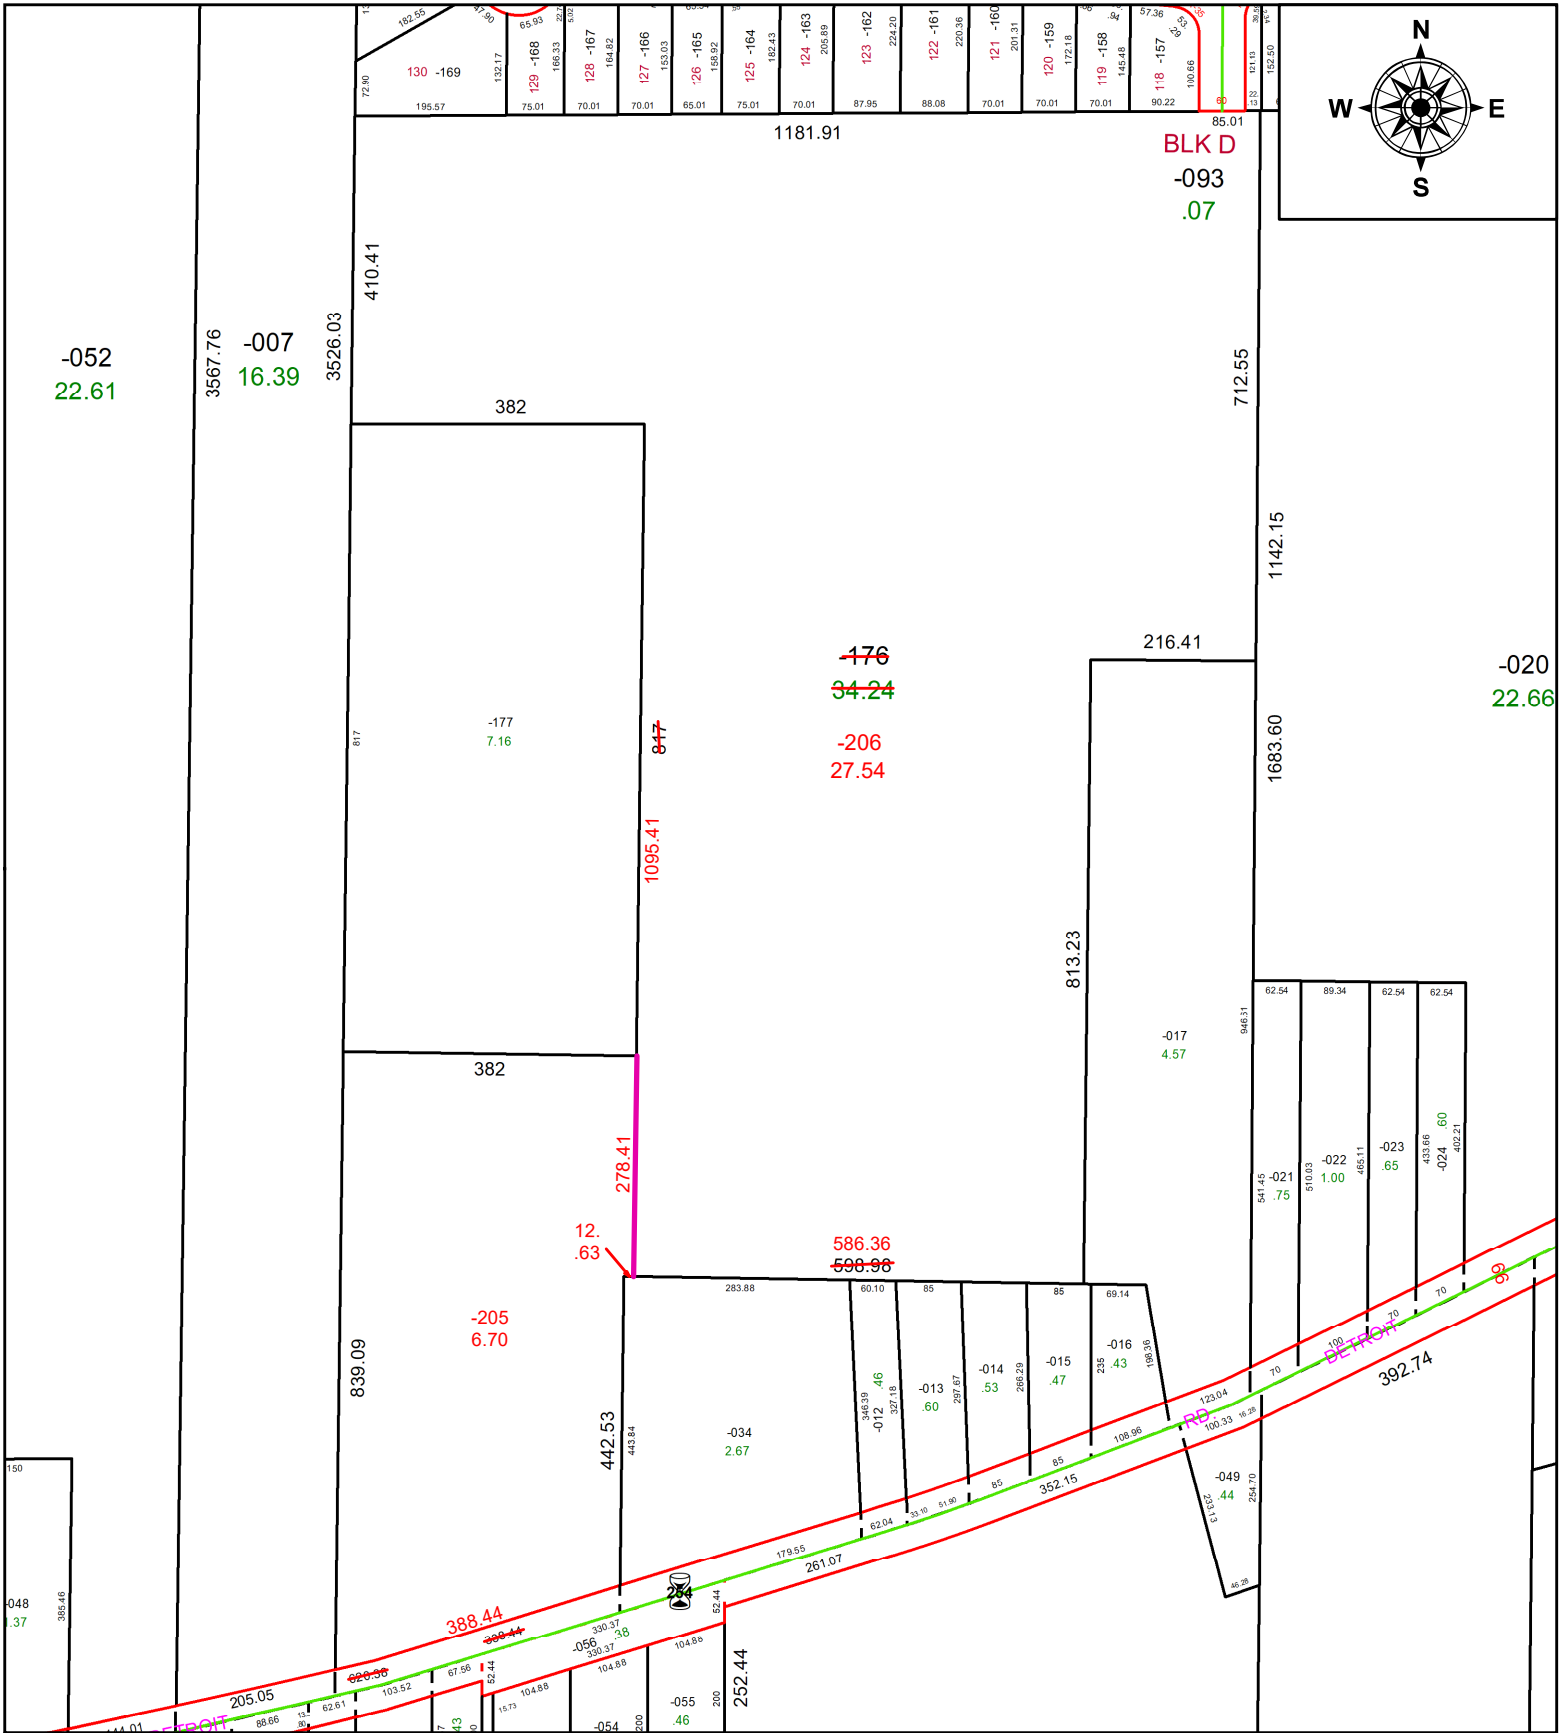

**SPLITS/DEEDS PROCESSED**  
 LORAIN COUNTY TAX MAP DEPARTMENT  
 226 MIDDLE AVE. ELYRIA, OH

**SURVEYED BY:** DONALD F. SHEEHY **SURV # 50910**  
**CLOSURE:** 1: 981054  
**MAP PAGE(S):** 04-00-027  
**APPROVED BY:** AC **DATE:** June 07, 2023  
**SCALE:** 1 in = 250 ft **PRIOR INSTRUMENT:** 2018- 0695447