
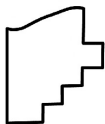


PARENT PARCEL: 07-00-017-112-028 & -029

CHILD PARCEL: 07-00-017-112-031 & -032

STARTING POINT: UNCOMBINATION & COMBINATION PER PRIOR DEEDS

21-04708-U

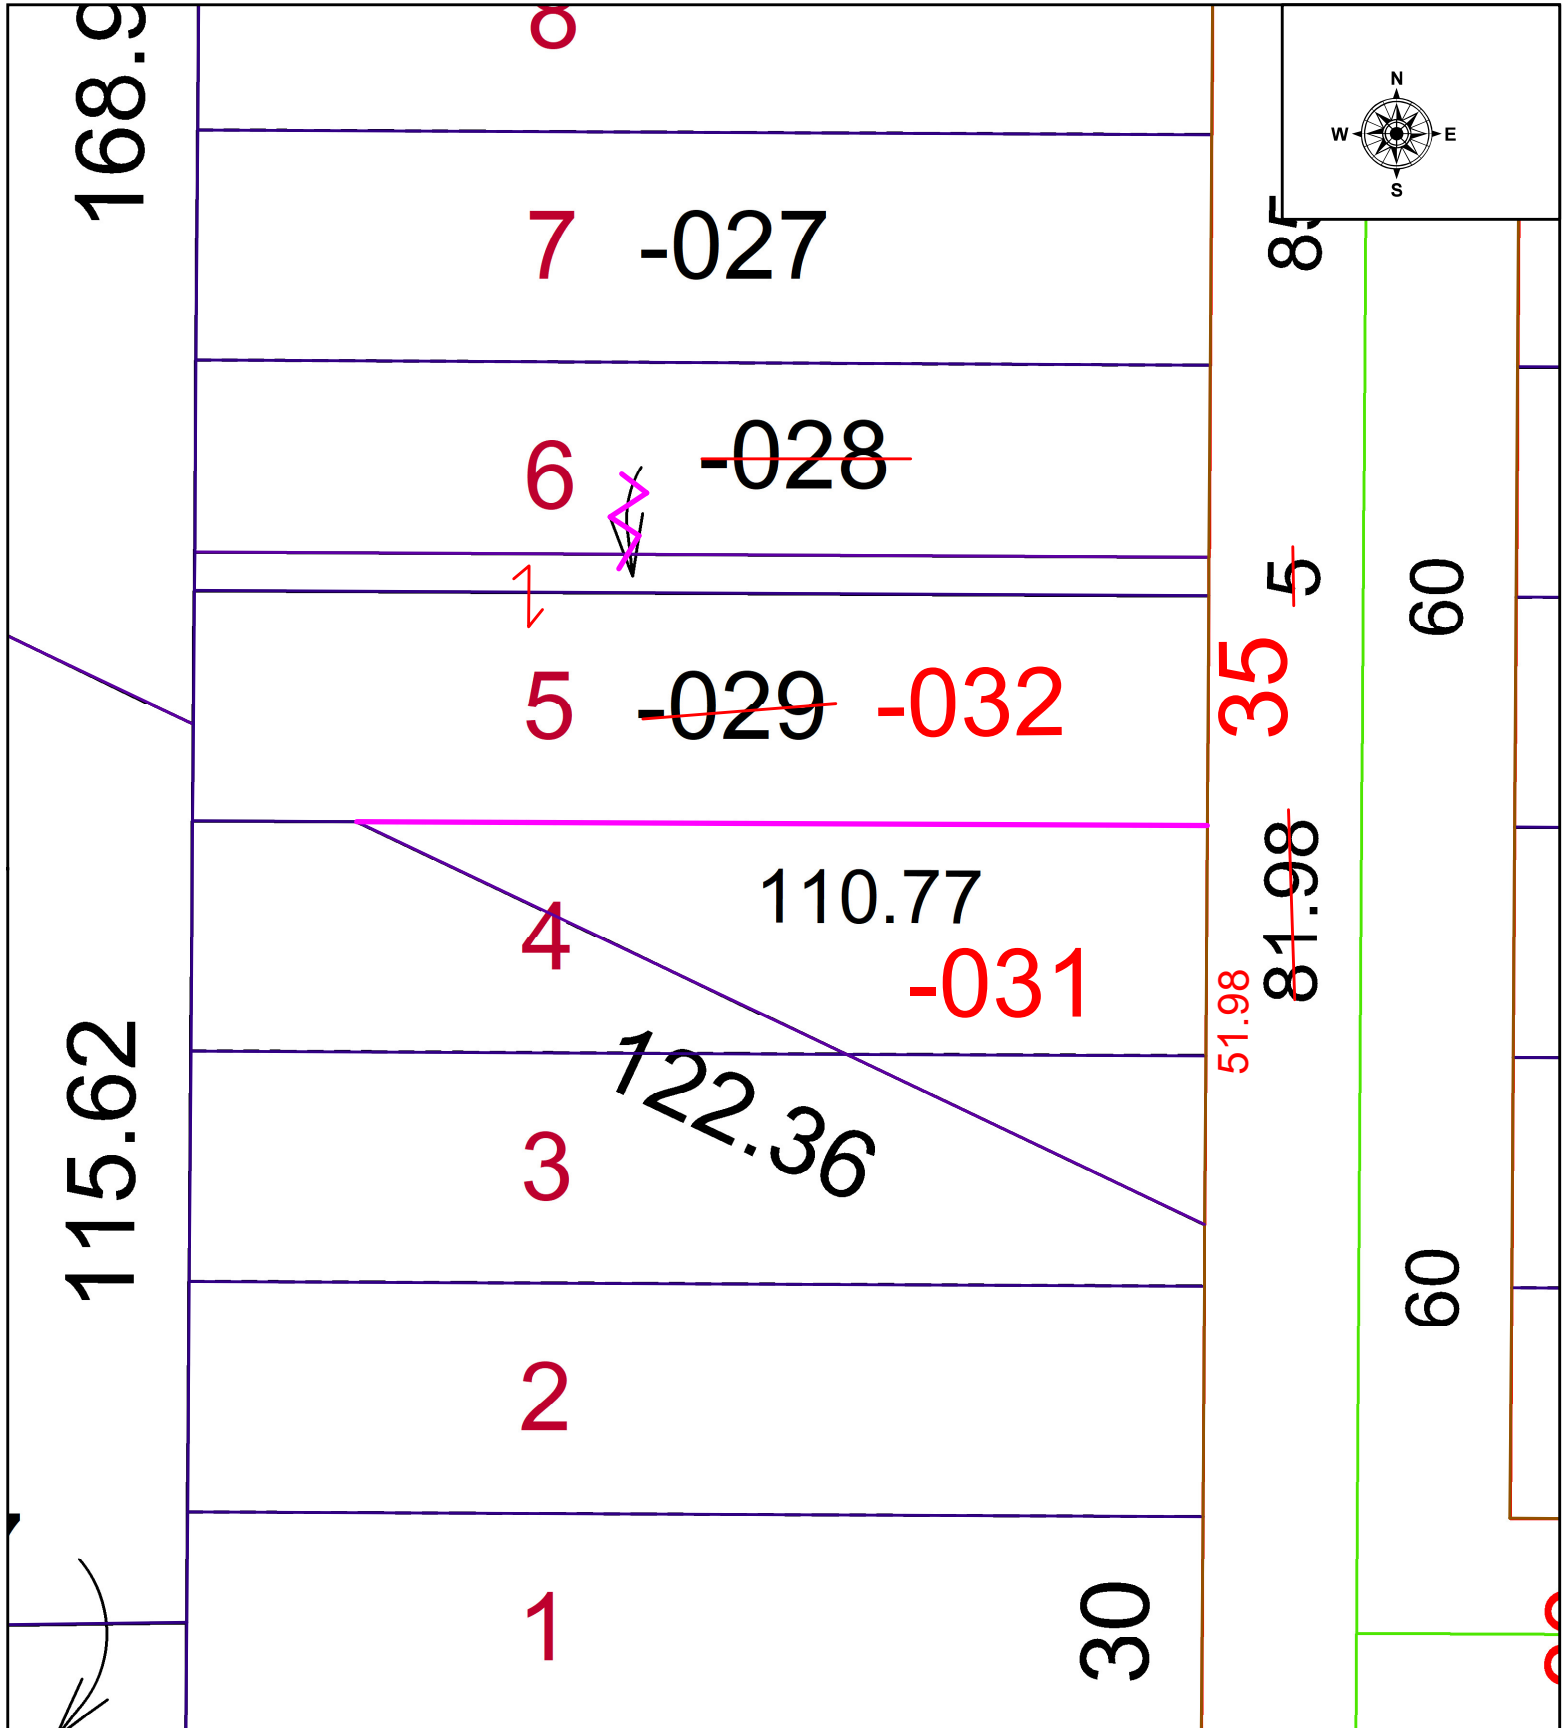

SPLITS/DEEDS PROCESSED
 LORAIN COUNTY TAX MAP DEPARTMENT
 226 MIDDLE AVE. ELYRIA, OH

SURVEYED BY: _____ N/A
 CLOSURE: _____ N/A
 MAP PAGE(S): 07-00-017
 APPROVED BY: WRZ DATE: 11/3/2021
 SCALE: 1" = 25' PRIOR INSTRUMENT: 2021-0831766