
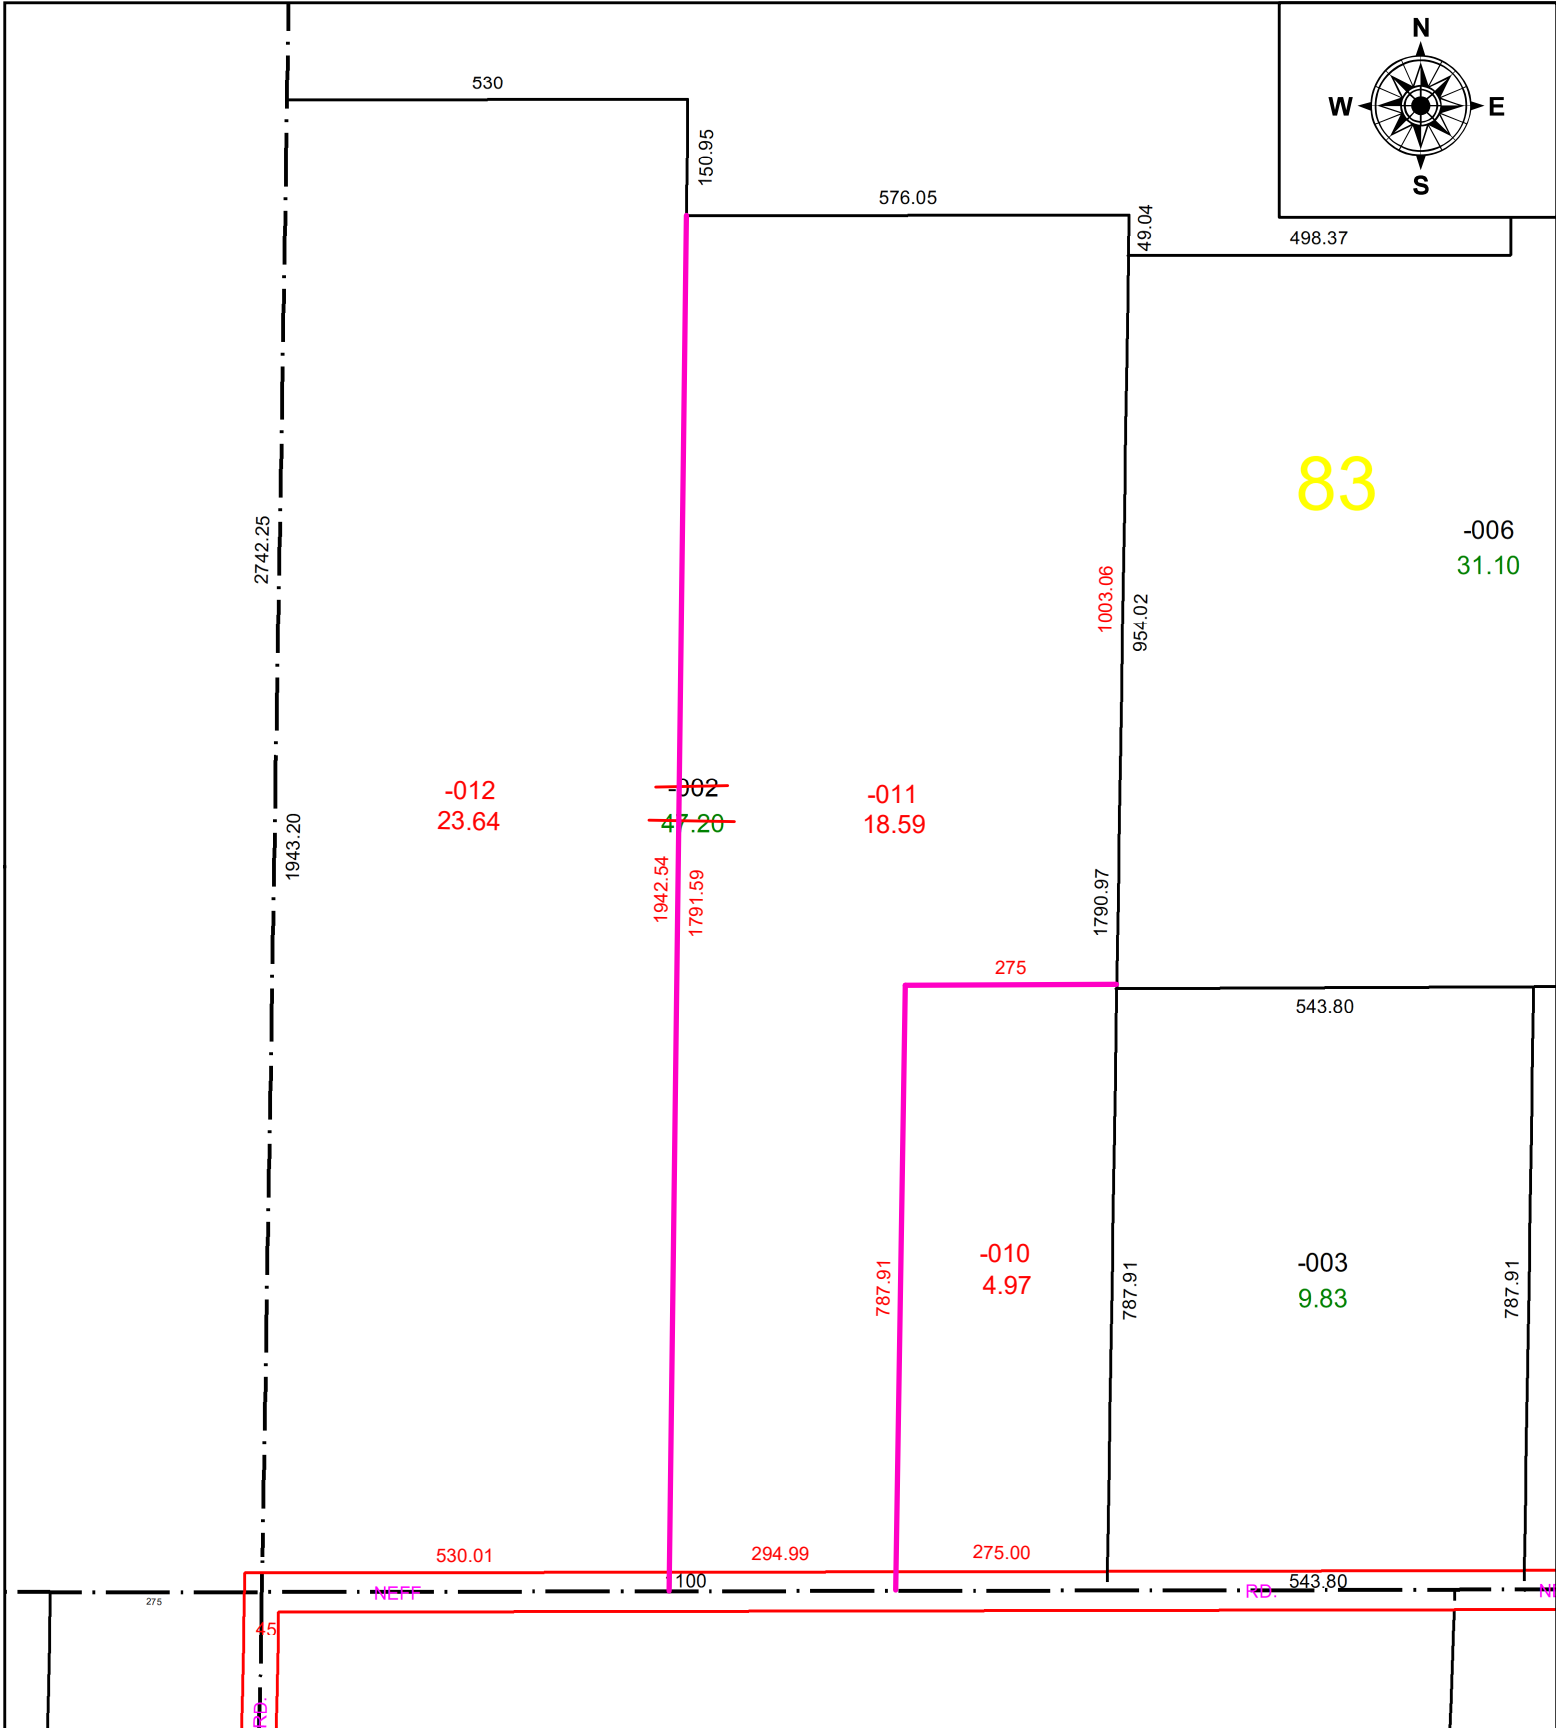


PARENT PARCEL: 16-00-083-000-002

CHILD PARCEL: 16-00-083-000-010, -011, -012

STARTING POINT: THE SOUTHWESTERLY CORNER OF ORIGINAL LOT 83

23-04708

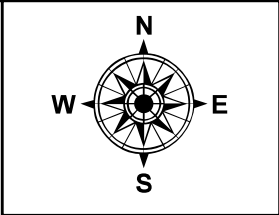

SPLITS/DEEDS PROCESSED
 LORAIN COUNTY TAX MAP DEPARTMENT
 226 MIDDLE AVE. ELYRIA, OH

SURVEYED BY: LOUIS J. GIFFELS **SURVEY #:** 50911
CLOSURE: 1: 605,581
MAP PAGE(S): 16-00-083
APPROVED BY: SP **DATE:** 6/7/2023
SCALE: 1" = 250' **PRIOR INSTRUMENT:** 2022-0859136