
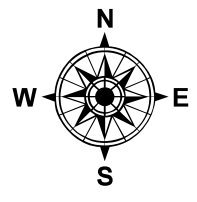


PARENT PARCEL: 07-00-021-117-086, -088

CHILD PARCEL: 07-00-021-117-099

23-04709

STARTING POINT: INTERSEC. OF CENTERLINES OF CENTER RIDGE RD & RIDGE PLAZA DR

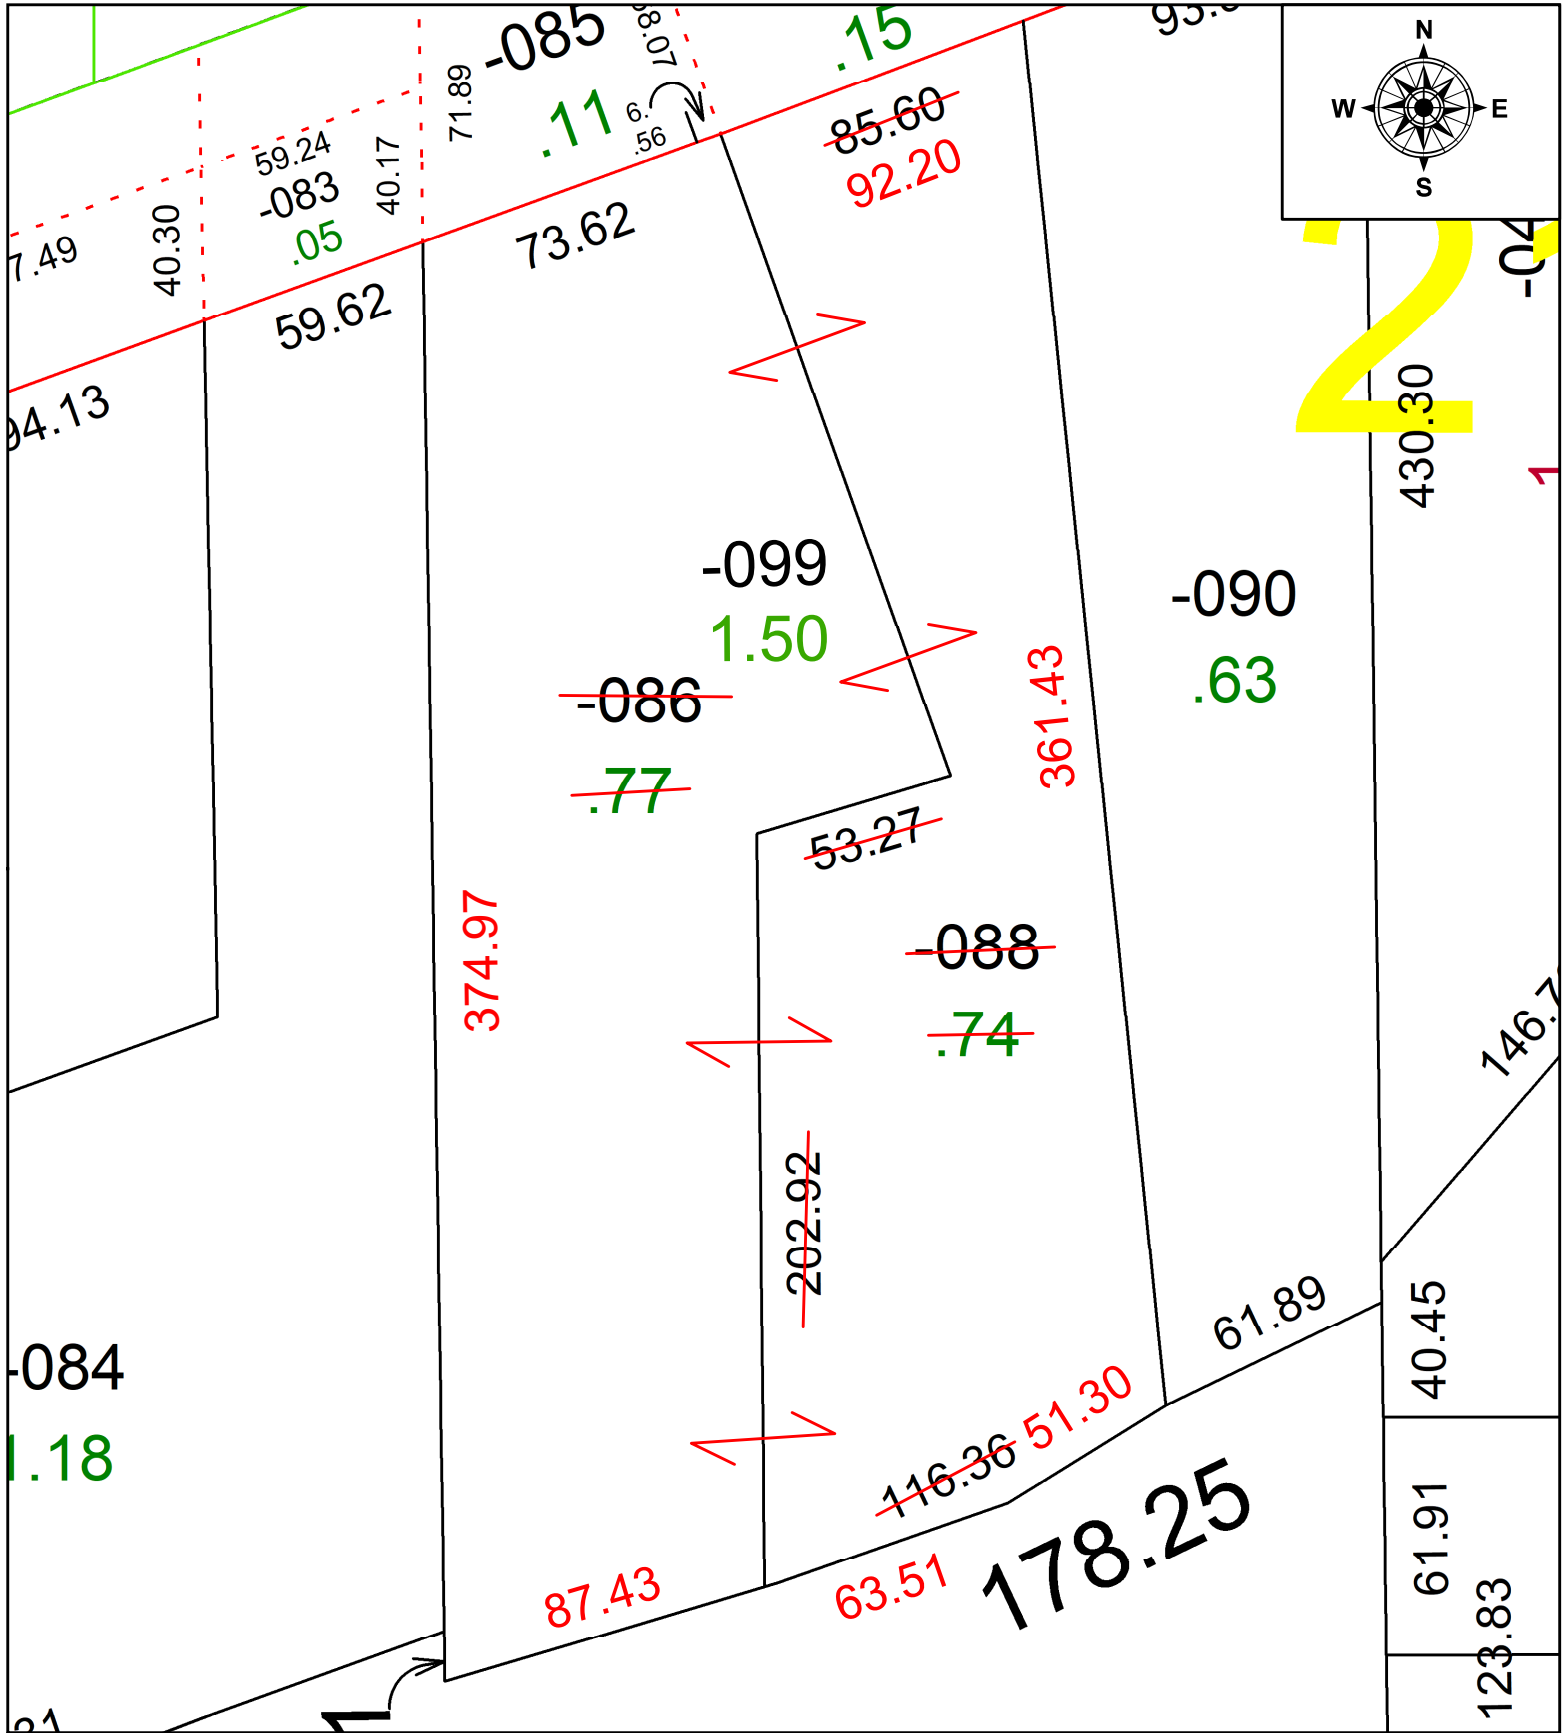


430.30

146.7

40.45

61.91

123.83

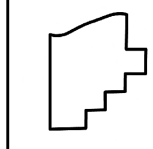

**SPLITS/DEEDS PROCESSED**  
 LORAIN COUNTY TAX MAP DEPARTMENT  
 226 MIDDLE AVE. ELYRIA, OH

SURVEYED BY: MATTHEW A. HILDEBRANDT      SURVEY #: 50913  
 CLOSURE: 1: 260,573  
 MAP PAGE(S): 07-00-021  
 APPROVED BY: SP      DATE: 6/7/2023  
 SCALE: 1" = 50'      PRIOR INSTRUMENT: 2021-0854243