
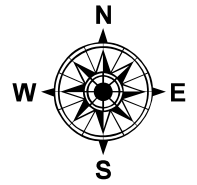


PARENT PARCEL: 04-00-023-108-056

CHILD PARCEL: **MAP CORRECTION ONLY**

STARTING POINT: C/L OF SCHWARTZ RD AND SPRUCE CT

21-04711-C

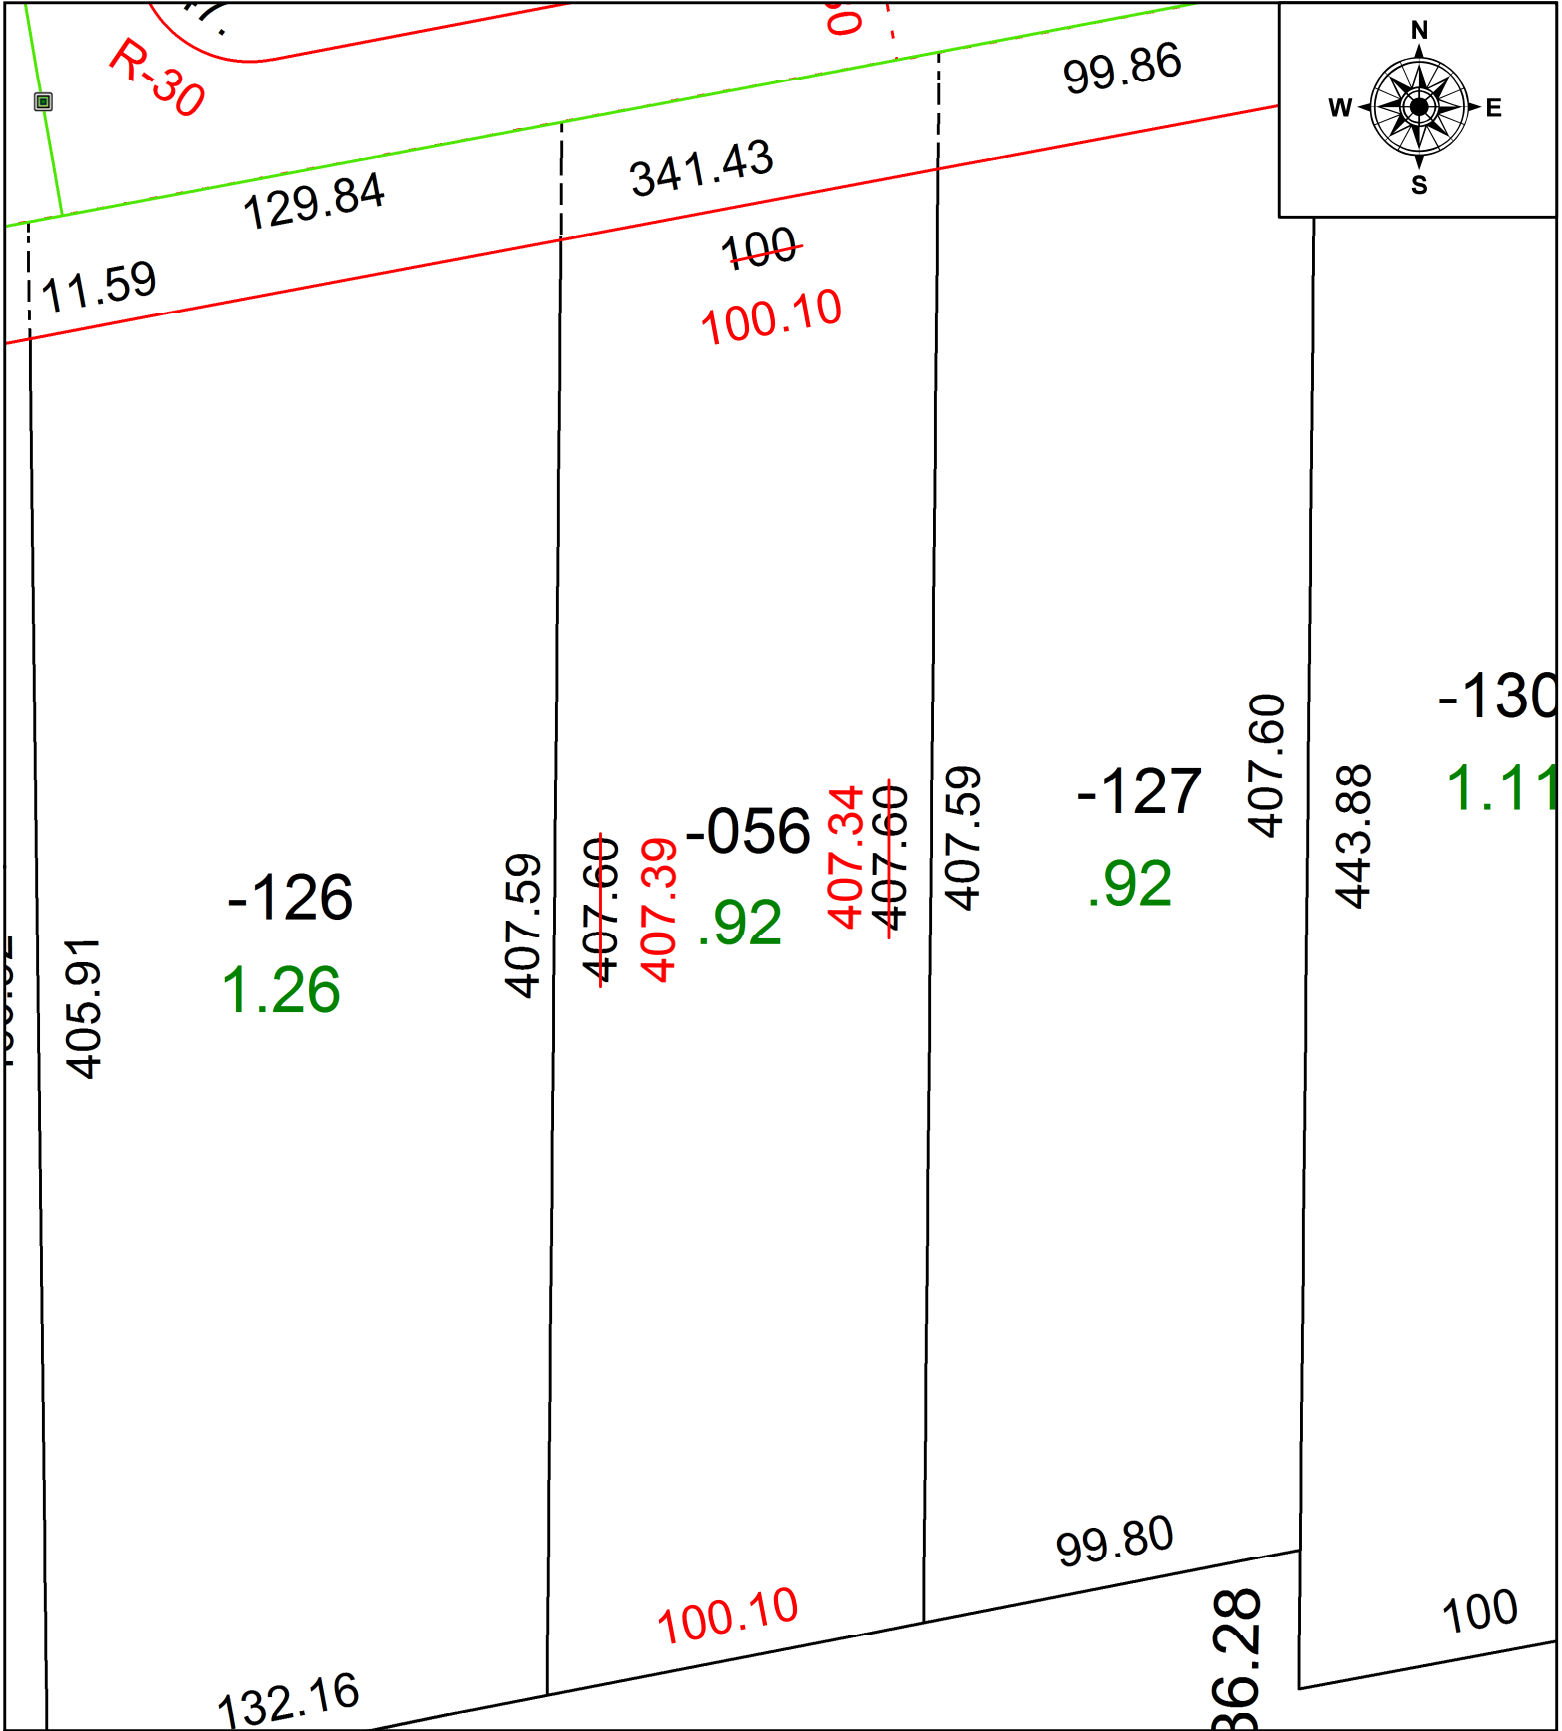

SPLITS/DEEDS PROCESSED
 LORAIN COUNTY TAX MAP DEPARTMENT
 226 MIDDLE AVE. ELYRIA, OH

SURVEYED BY: AMY M. KELLY
 CLOSURE: 1: 191638
 MAP PAGE(S): 04-00-023
 APPROVED BY: AC DATE: 11/4/2021
 SCALE: 1" = 50 PRIOR INSTRUMENT: 2010- 0325240