

PARENT PARCEL: 16-00-086-000-037 & -038



CHILD PARCEL: 16-00-086-000-045 THRU -047

STARTING POINT: N.W. CORNER OF O.L. 86

23-04711



-007
45.28

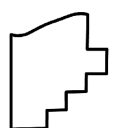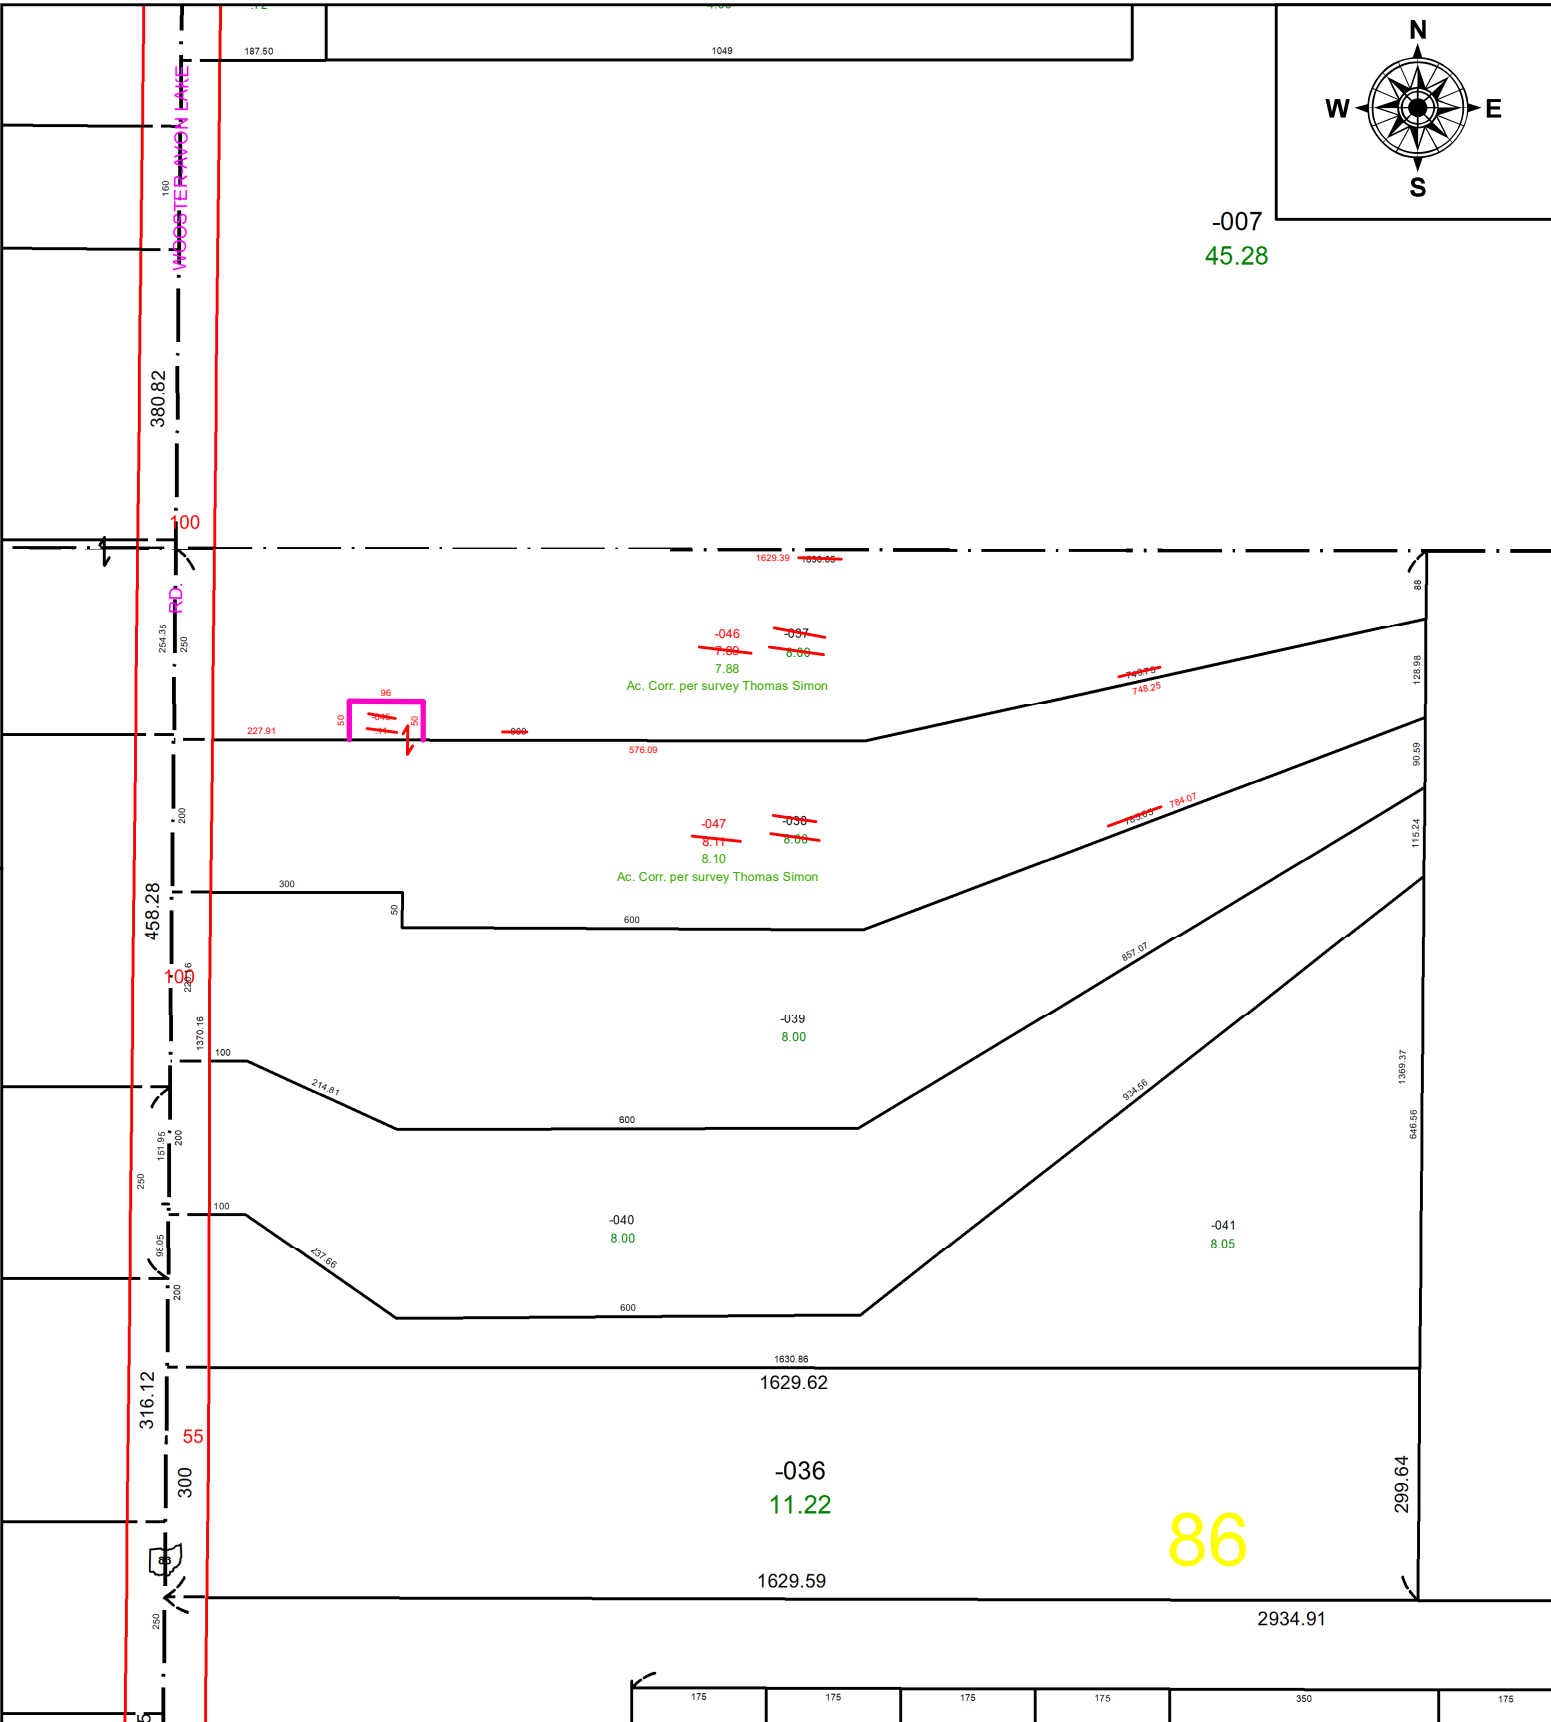

SPLITS/DEEDS PROCESSED
LORAIN COUNTY TAX MAP DEPARTMENT
226 MIDDLE AVE. ELYRIA, OH

SURVEYED BY: THOMAS SIMON **SURVEY #:** 50915
CLOSURE: 1:-2147483648
MAP PAGE(S): 16-00-086
APPROVED BY: DMA **DATE:** 6/12/2023
SCALE: 1" = 250' **PRIOR INSTRUMENT:** 2020-0744220

