


PARENT PARCEL: 03-00-033-107-007 THRU -010, -031 THRU -037, -071

CHILD PARCEL: 03-00-033-107-074

23-04712

STARTING POINT: 1" IRON PIN MONUMENT @ INTERSECTION OF C/LS OF ABBE RD & HAWTHORNE AVE

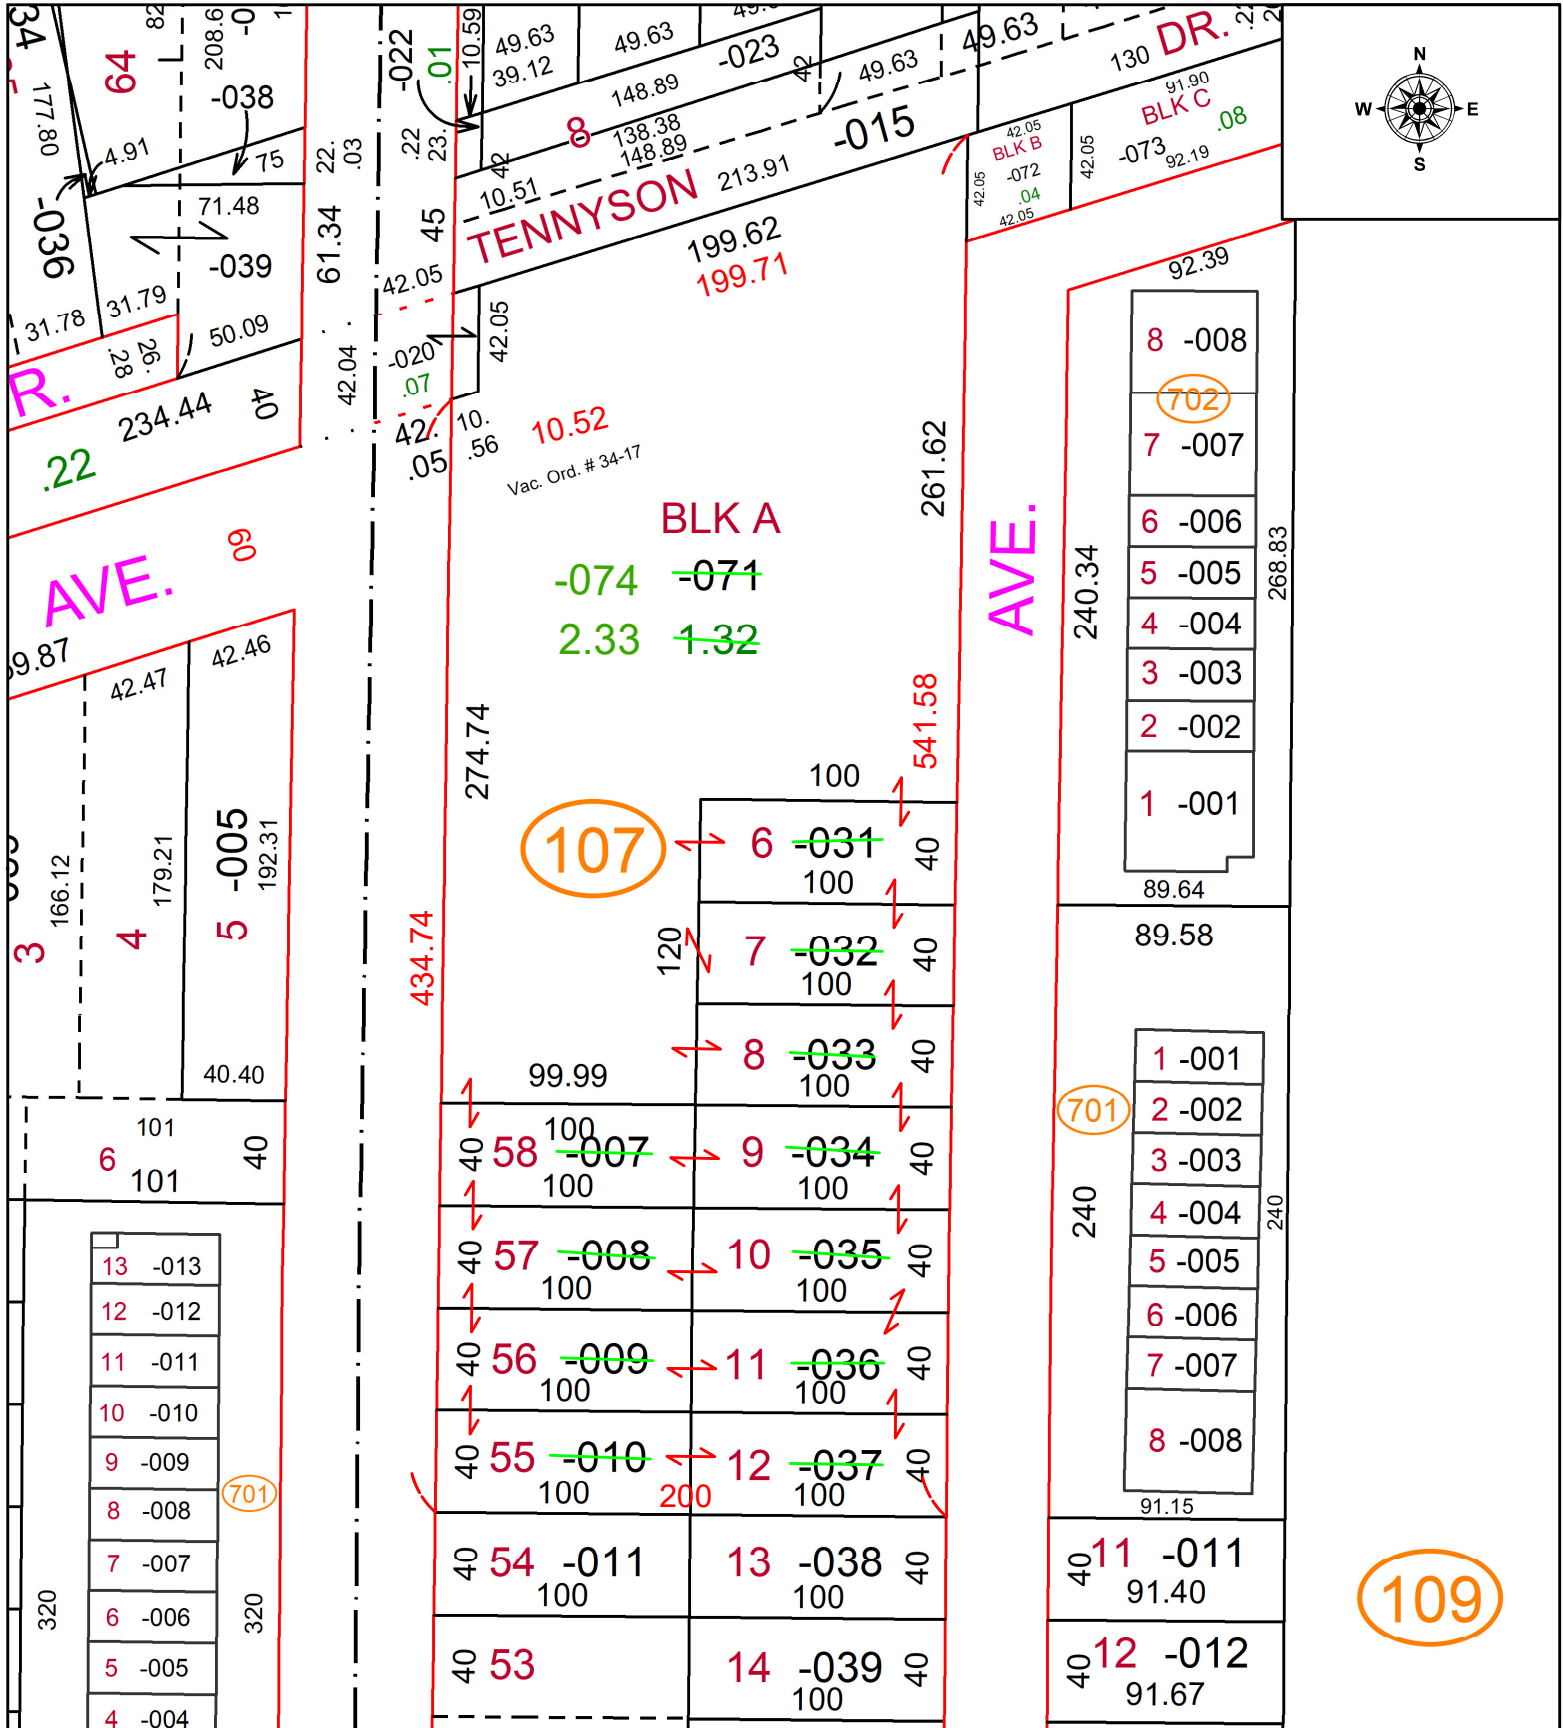

SPLITS/DEEDS PROCESSED

LORAIN COUNTY TAX MAP DEPARTMENT
226 MIDDLE AVE. ELYRIA, OH

SURVEYED BY: SEAN BOLAND SURVEY # 50917
 CLOSURE: 1: 514671
 MAP PAGE(S): 03-00-033
 APPROVED BY: WRZ DATE: 6/15/2023
 SCALE: 1" = 75 PRIOR INSTRUMENT: #2023-0911362