


PARENT PARCEL: CERT. OF CORRECTION PV. 93 PG. 15

CHILD PARCEL: XX-XX-XXX-XXX-XXX

STARTING POINT: XXXXXX

21-04714-C

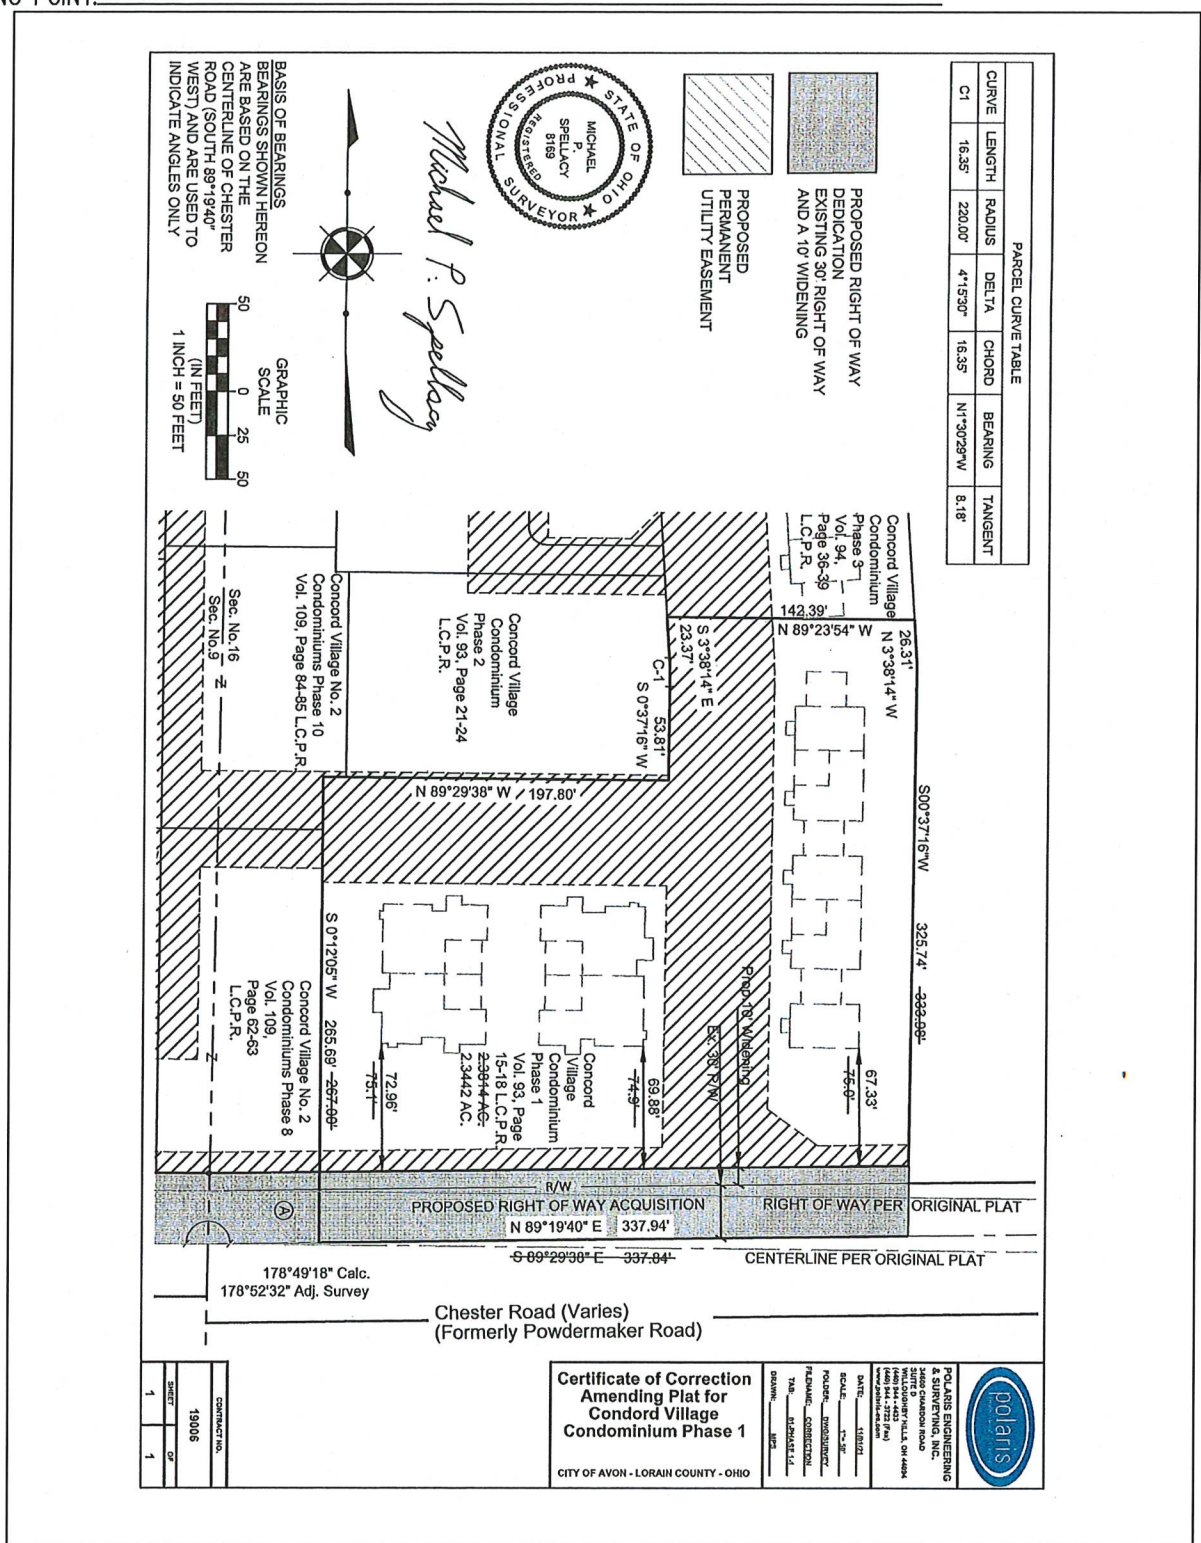

SPLITS/DEEDS PROCESSED

LORAIN COUNTY TAX MAP DEPARTMENT
 226 MIDDLE AVE. ELYRIA, OHIO

SURVEYED BY: MICHAEL SPELLACY
 CLOSURE: 0.01 : 10,000
 MAP PAGE(S): 04-00-016
 APPROVED BY: TJS DATE: 11/5/2021
 SCALE: 1" = 100' PRIOR INSTRUMENT: PV.93 PG.15