


PARENT PARCEL: 06-24-016-000-041

CHILD PARCEL: AC. CORR. PER PRIOR INSTR. # 2006182640 & SURVEY C.E. PENFOUND

STARTING POINT: XXXXXXXXXXXXXXXX

21-04716-A

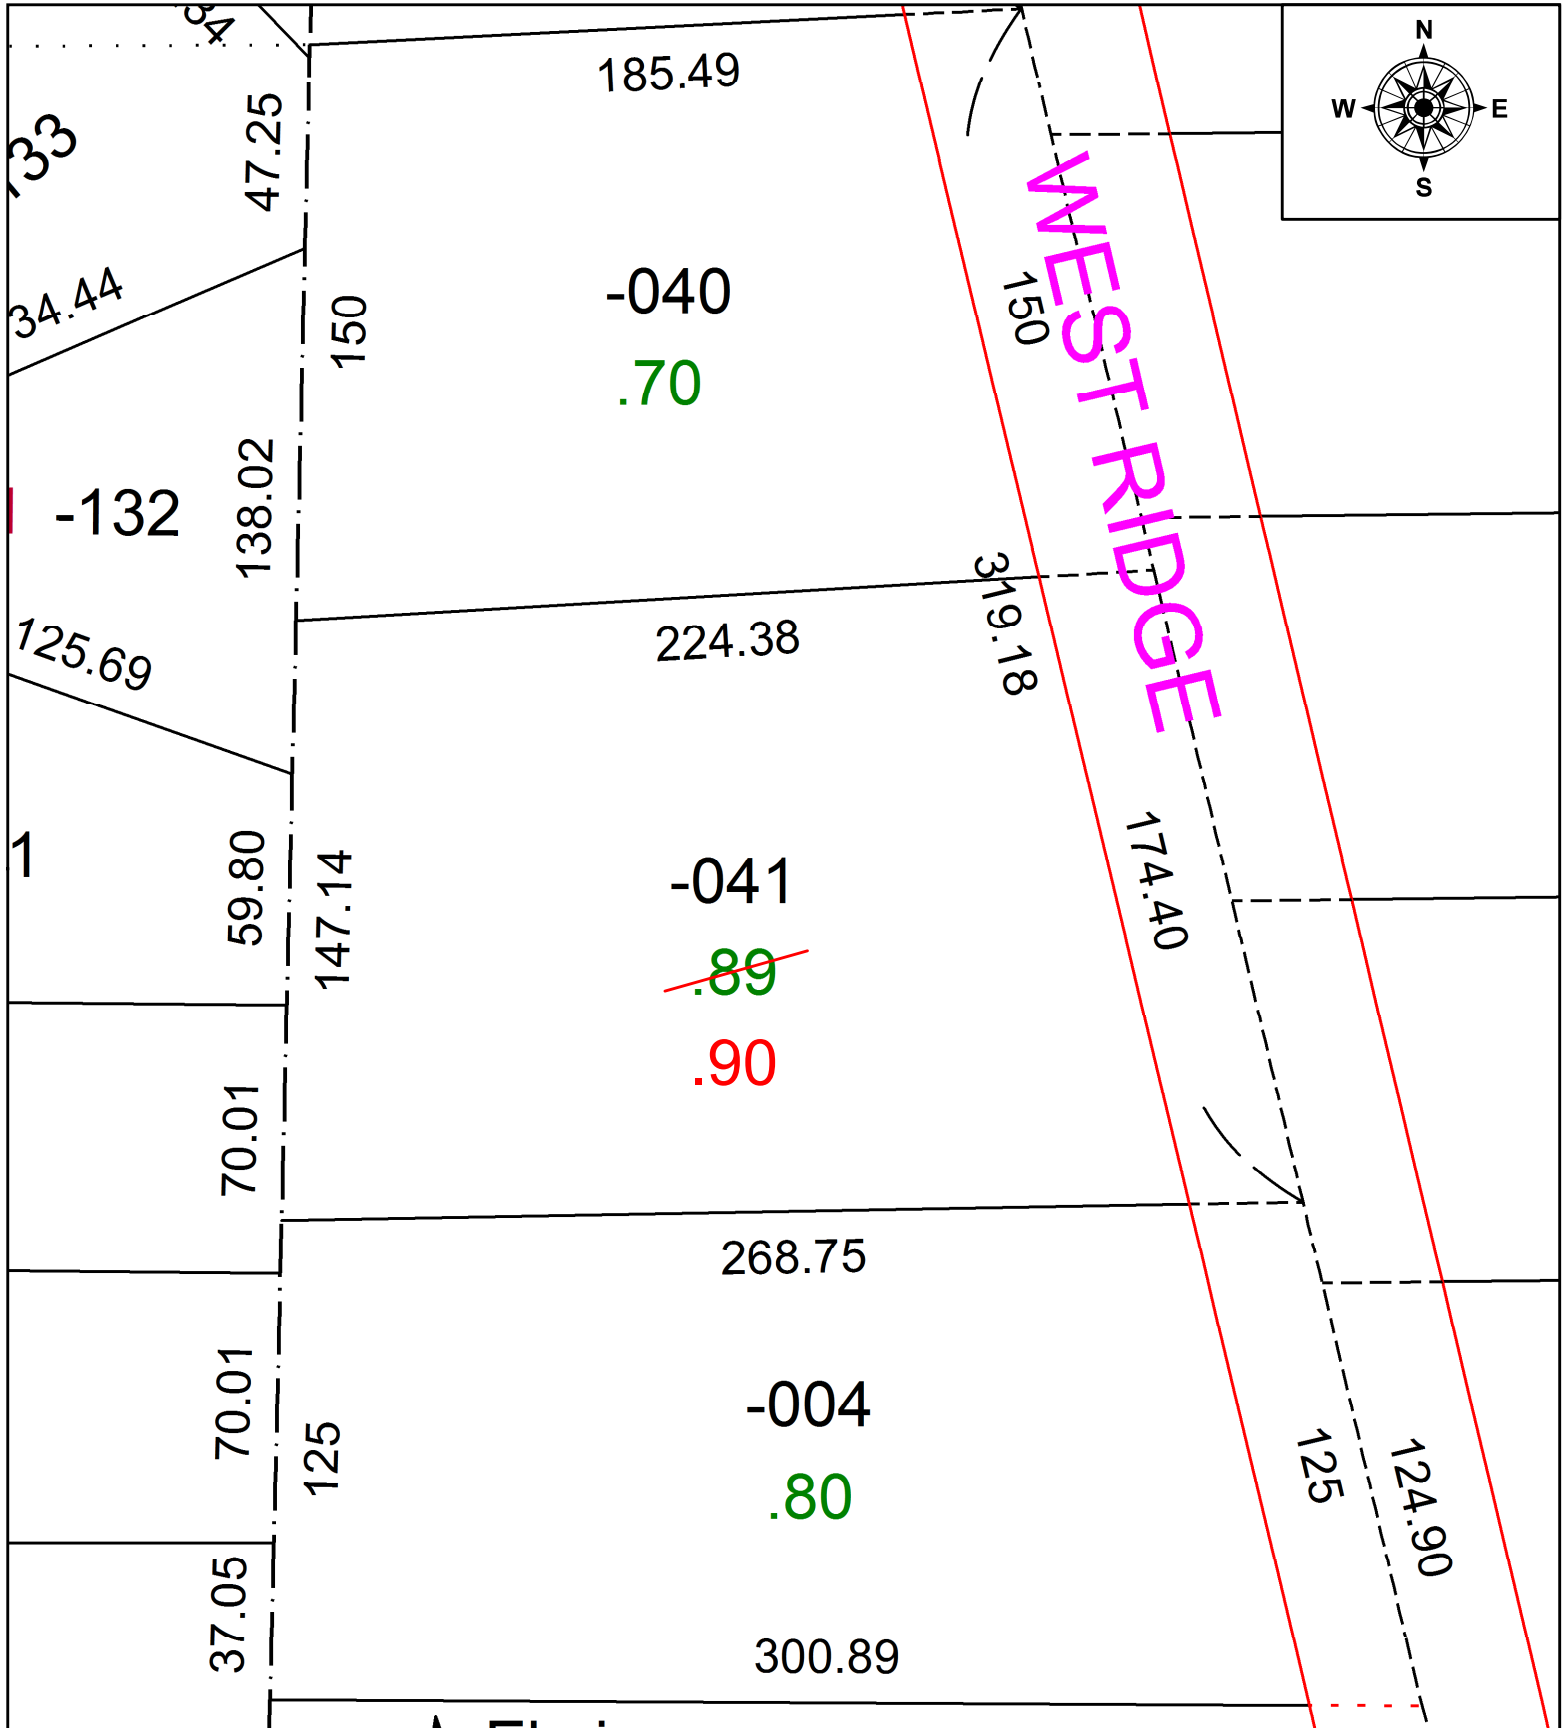

SPLITS/DEEDS PROCESSED
 LORAIN COUNTY TAX MAP DEPARTMENT
 226 MIDDLE AVE. ELYRIA, OH

SURVEYED BY: C.E. PENFOUND
 CLOSURE: 1: 53,151
 MAP PAGE(S): 06-24-016
 APPROVED BY: DMA DATE: 11/10/2021
 SCALE: 1" = 50' PRIOR INSTRUMENT: 20060182640