


PARENT PARCEL: 18-00-046-000-024

CHILD PARCEL: **AC CORR PER SURV BY THOMAS M. SNEZEK**

STARTING POINT: C/L OF QUARRY AND MEDINA-NORWALK RD

21-04719-A

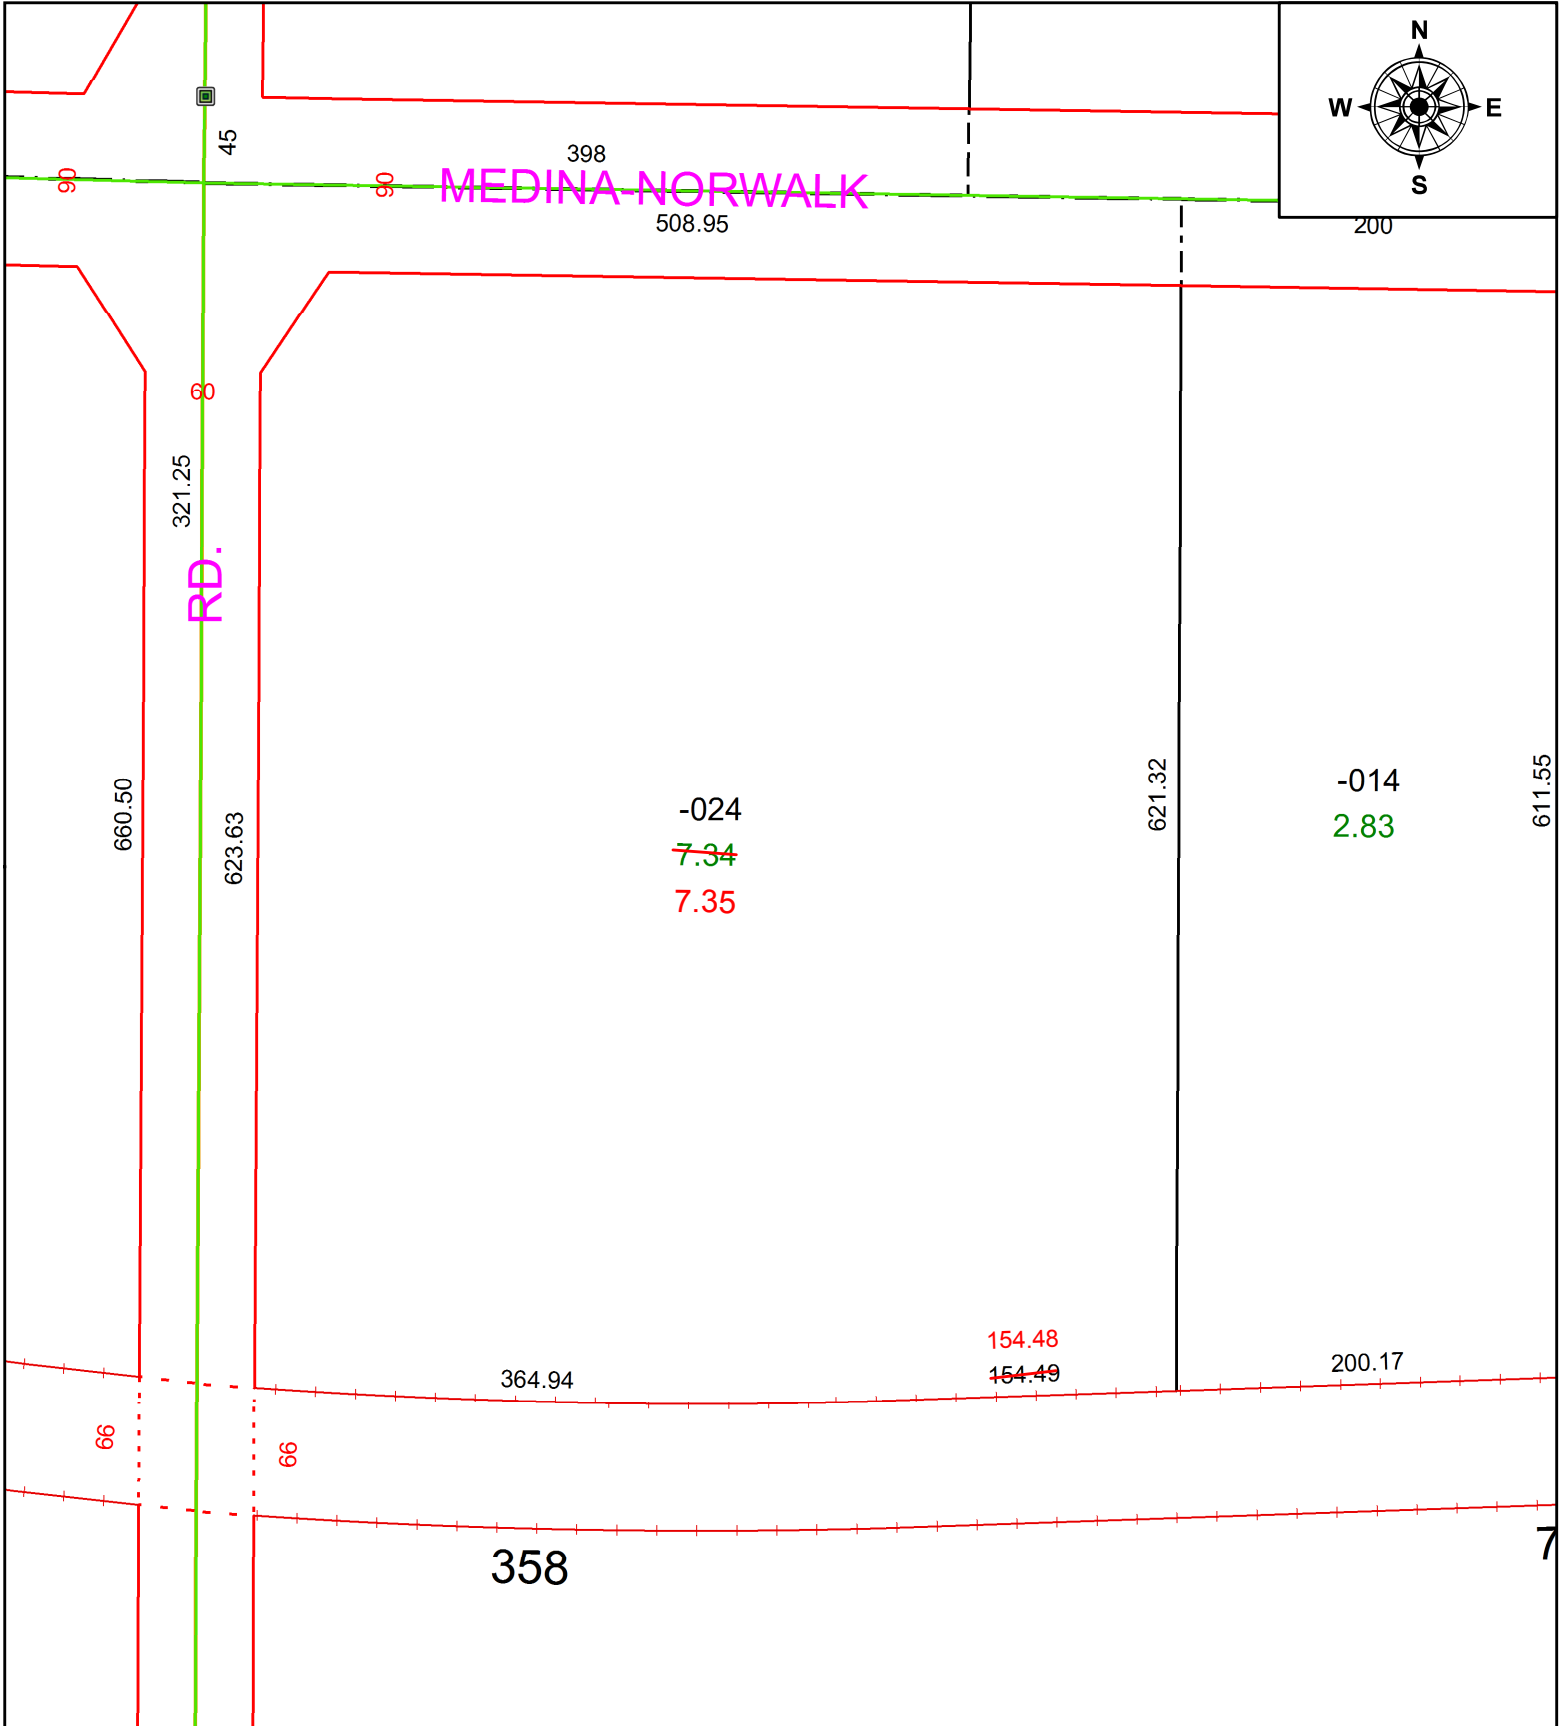

SPLITS/DEEDS PROCESSED
 LORAIN COUNTY TAX MAP DEPARTMENT
 226 MIDDLE AVE. ELYRIA, OH

SURVEYED BY: THOMAS M SNEZEK
CLOSURE: N/A
MAP PAGE(S): 18-00-046-A
APPROVED BY: AC **DATE:** 11/15/2021
SCALE: 1" = 100 **PRIOR INSTRUMENT:** PER SURV #7051