



PARENT PARCEL: 15-00-082-000-017 & -111

CHILD PARCEL: 15-00-082-000-264, -265, & -266

AC CORR PER SURVEYOR THEODORE SPILLMAN

23-04721

STARTING POINT: SOUTHEAST CORNER OF S/L 708 IN PHEASANT RUN VILLAGE PH. 2

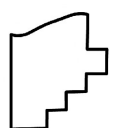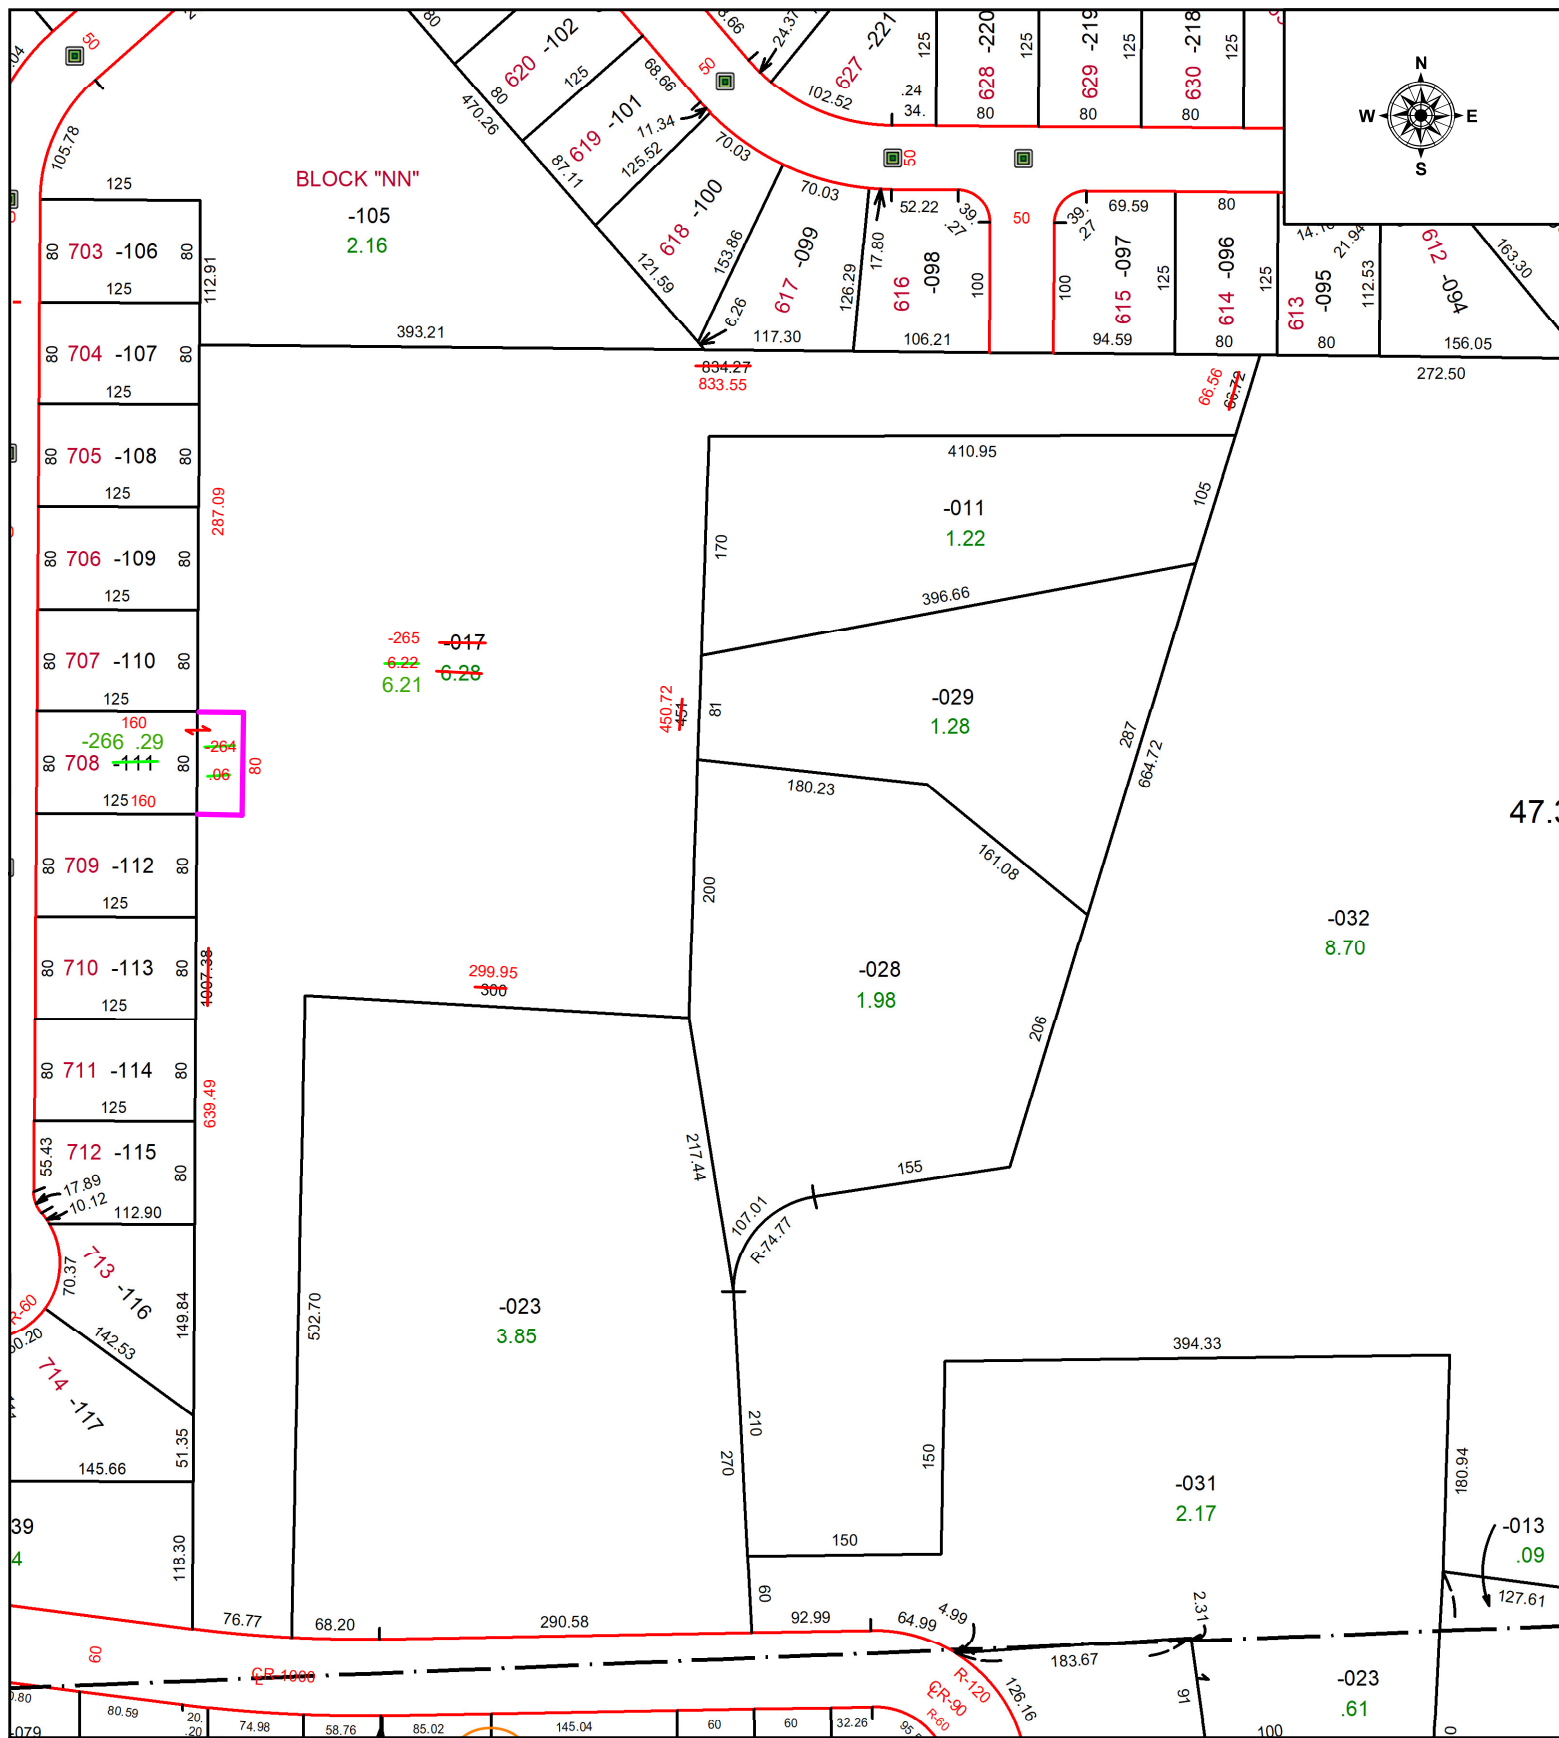

SPLITS/DEEDS PROCESSED
 LORAIN COUNTY TAX MAP DEPARTMENT
 226 MIDDLE AVE. ELYRIA, OH

SURVEYED BY: THEODORE SPILLMAN SURVEY # 50935
 CLOSURE: 1: INF
 MAP PAGE(S): 15-00-082
 APPROVED BY: WRZ DATE: 7/7/2023
 SCALE: 1" = 150 PRIOR INSTRUMENT: #2006-178429