
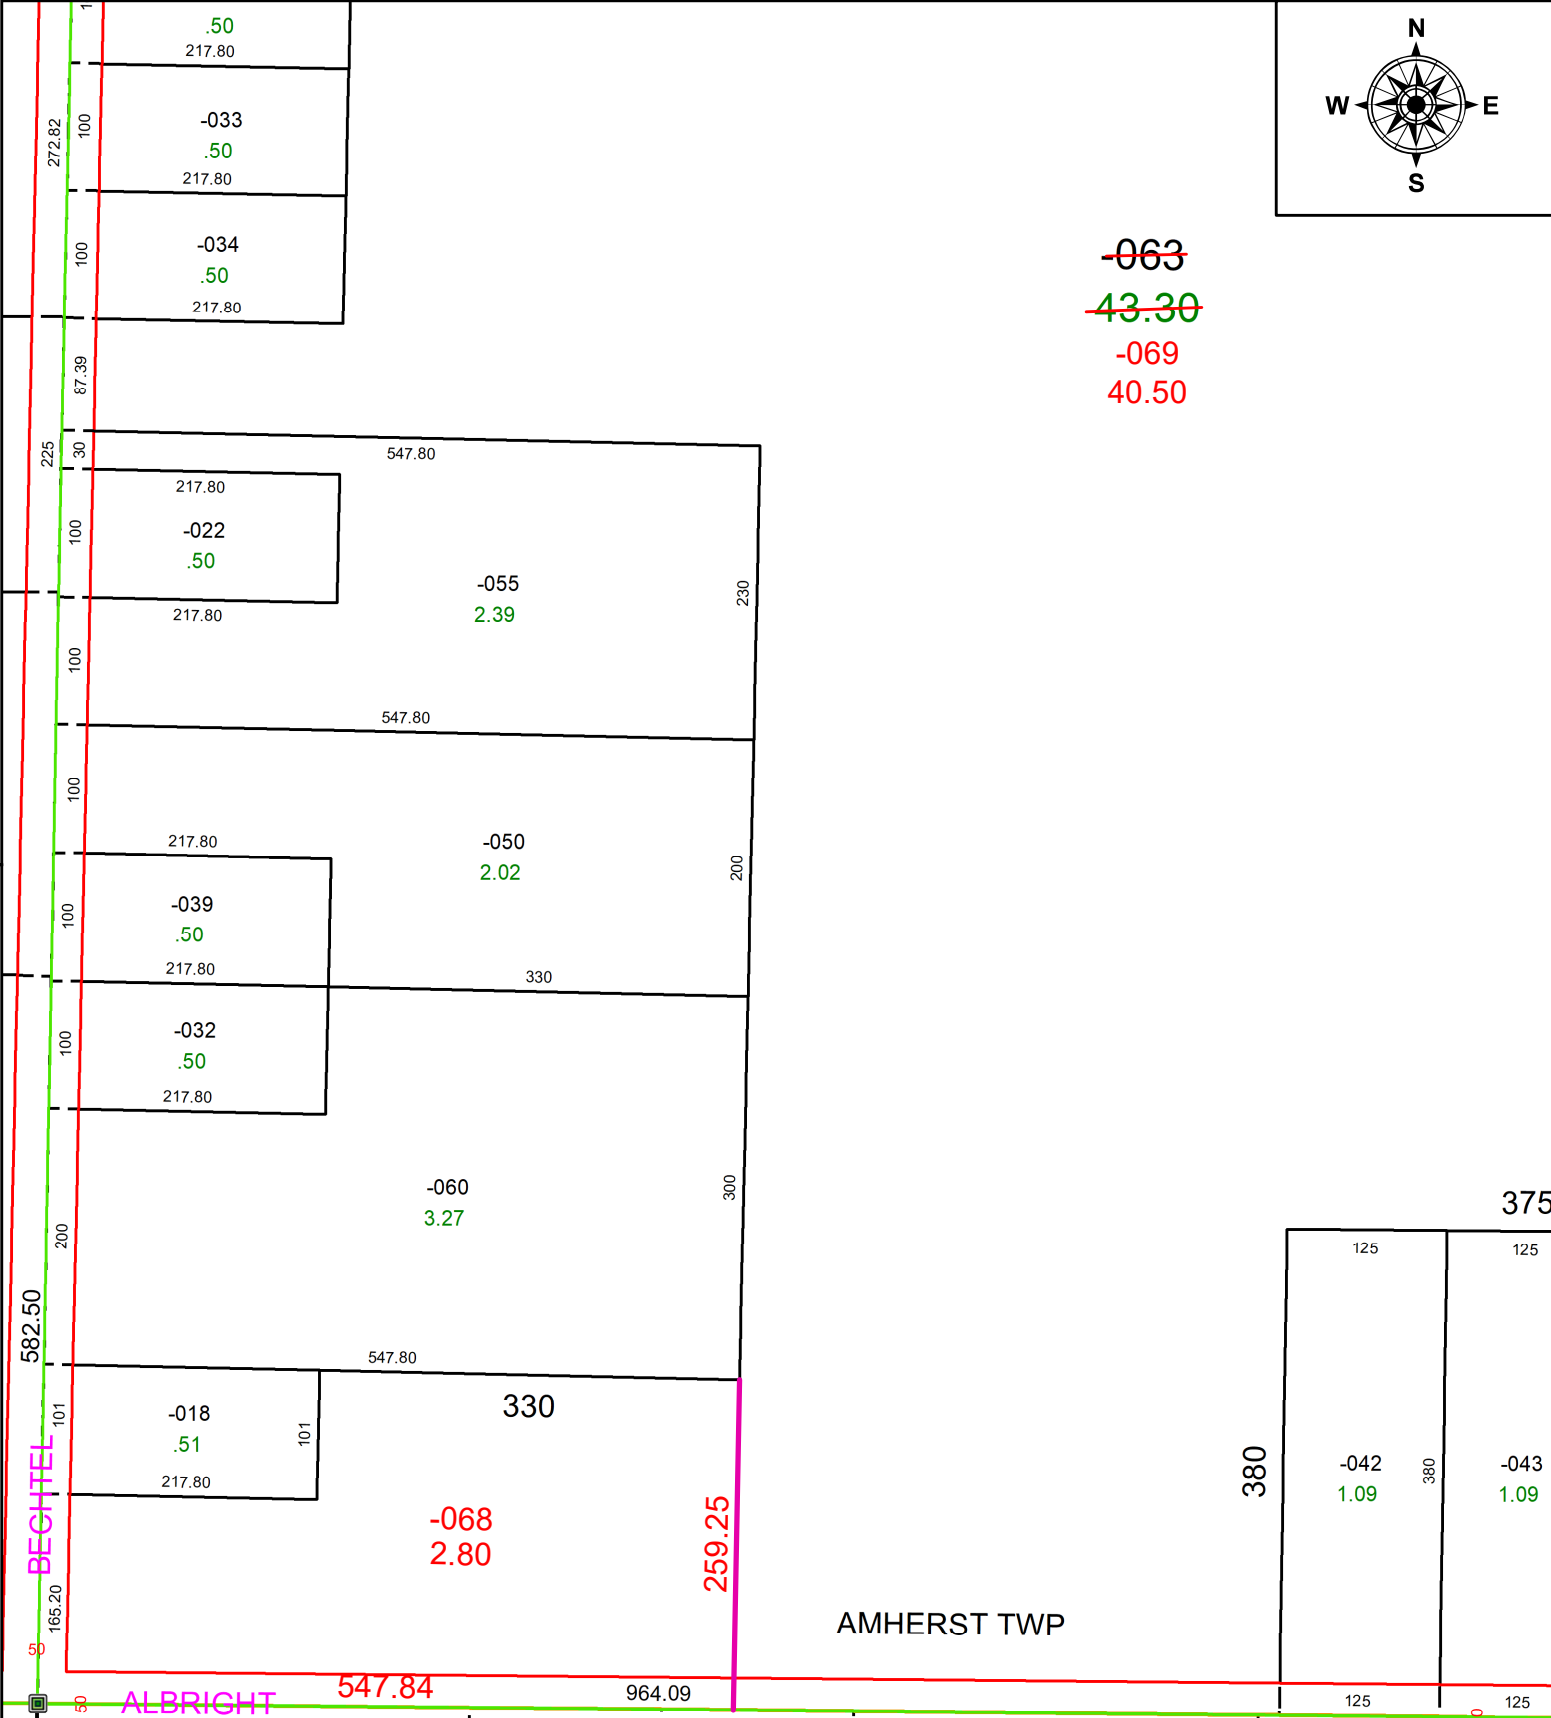


PARENT PARCEL: 05-00-071-000-063

CHILD PARCEL: 05-00-071-000-068 & -069

STARTING POINT: C/L OF ALBRECHT AND BECHTEL RD

23-04722

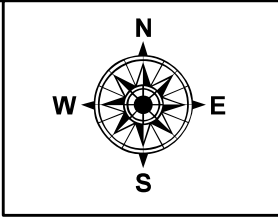

SPLITS/DEEDS PROCESSED
LORAIN COUNTY TAX MAP DEPARTMENT
226 MIDDLE AVE. ELYRIA, OH

SURVEYED BY: THOMAS A. SIMON SURV # 50937
CLOSURE: 1: 82,508
MAP PAGE(S): 05-00-071
APPROVED BY: AC DATE: July 10, 2023
SCALE: 1 in = 150 ft PRIOR INSTRUMENT: 2007- 0189435