


PARENT PARCEL: 01-00-033-000-018 & 01-00-048-000-004

CHILD PARCEL: **ACREAGE CORRECTION PER SURVEY DANIEL HARTUNG JR.**

STARTING POINT: C/L DARROW RD. & WEST RIVER RD.

21-04723-A

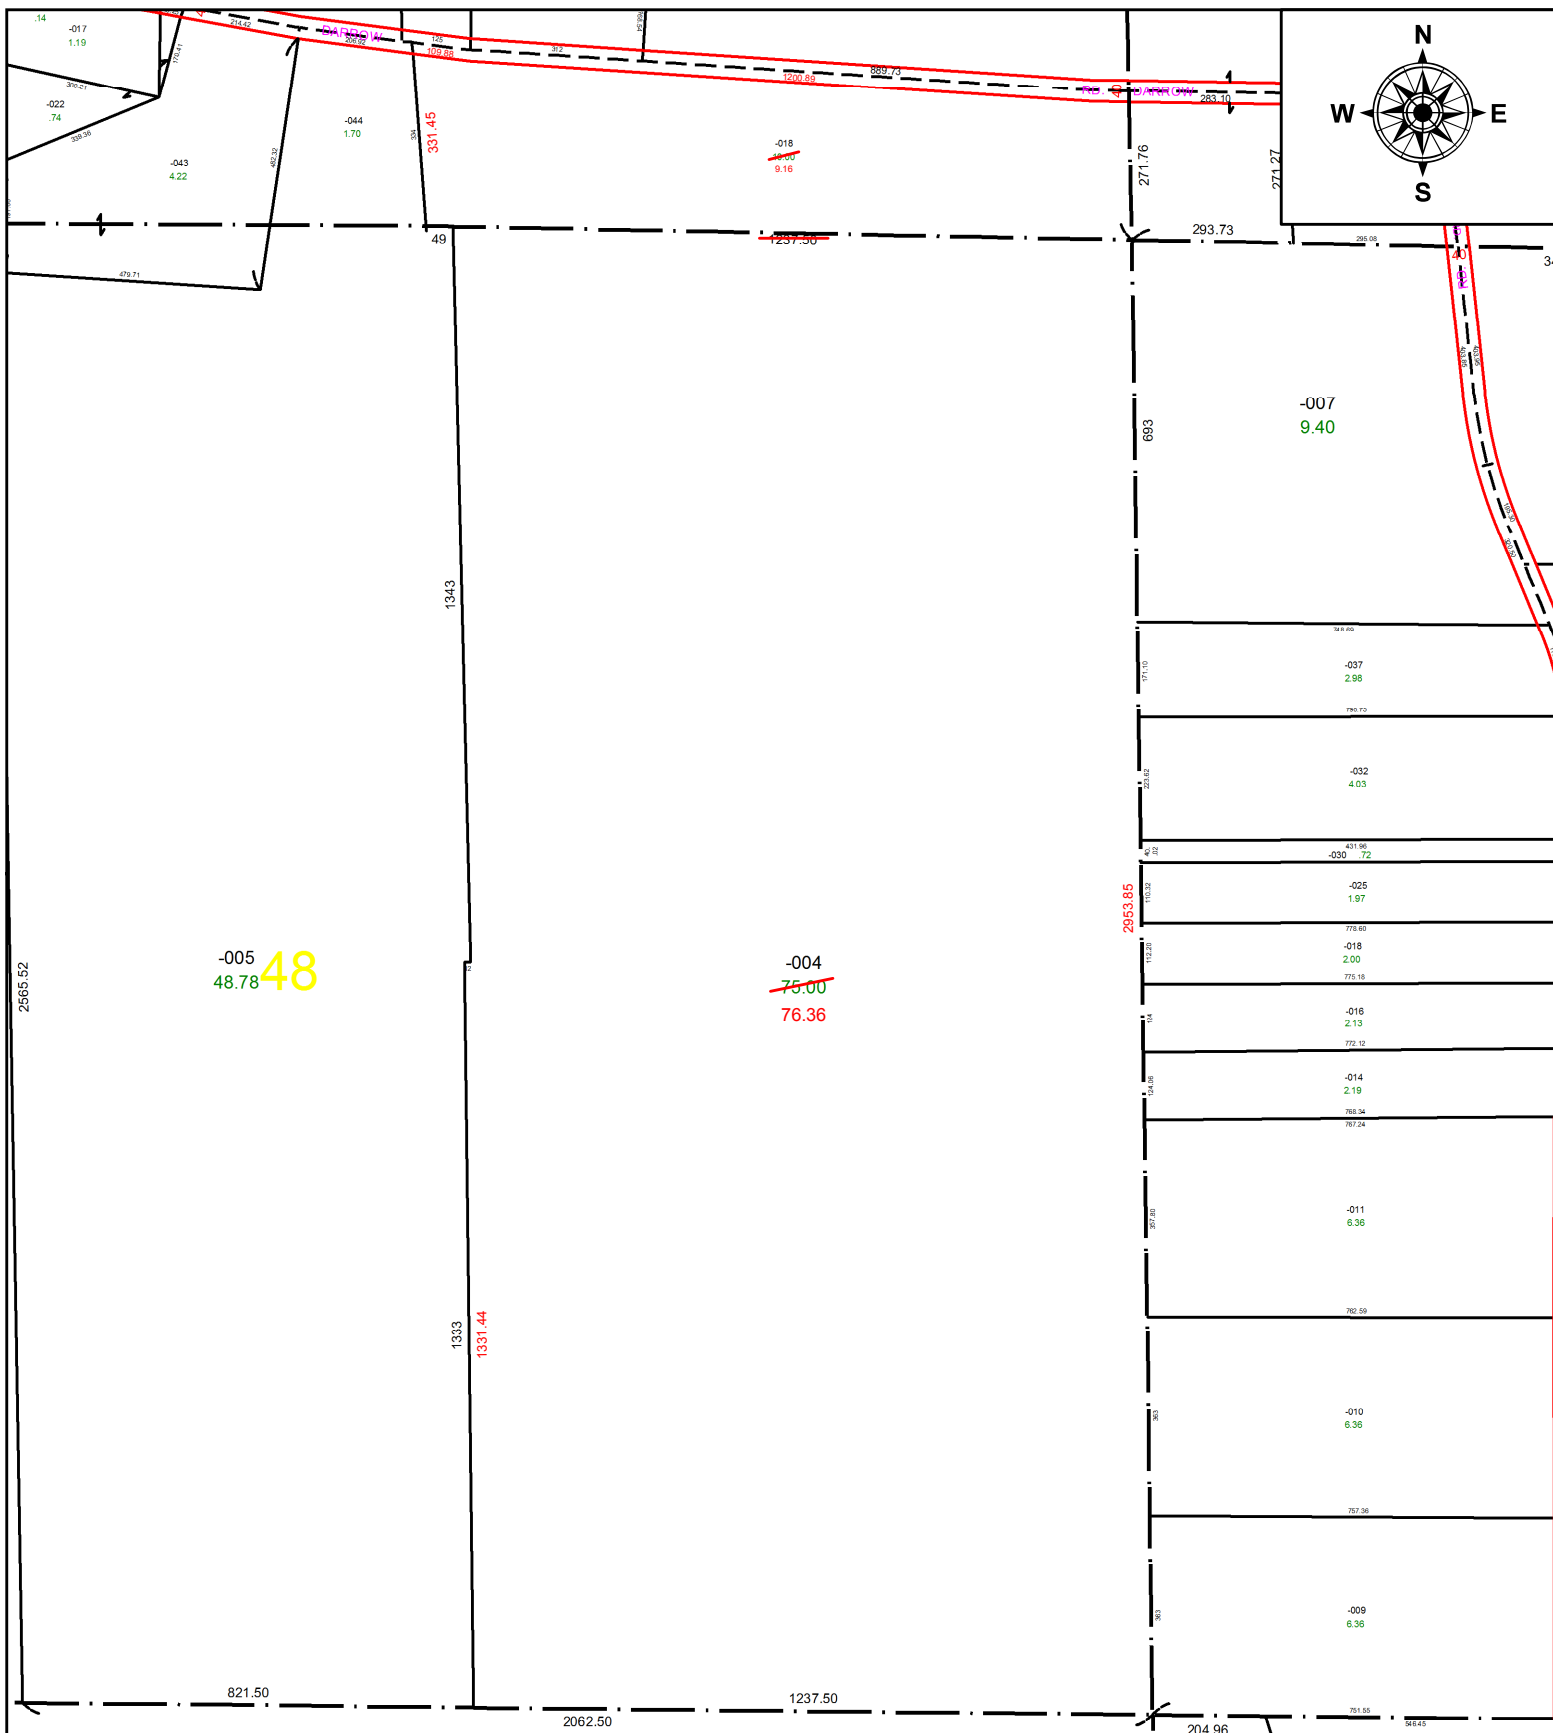

SPLITS/DEEDS PROCESSED
 LORAIN COUNTY TAX MAP DEPARTMENT
 226 MIDDLE AVE. ELYRIA, OH

SURVEYED BY: DANIEL HARTUNG JR.

CLOSURE: 1: 920,294

MAP PAGE(S): 01-00-048

APPROVED BY: DMA DATE: 11/16/2021

SCALE: 1" = 350' PRIOR INSTRUMENT: 20200764225