


PARENT PARCEL: 02-02-005-112-017

CHILD PARCEL: **MAP CORRECTION ONLY**

STARTING POINT: CL OF OBERLIN AVE. & COOPER FOSTER PARK RD.

21-04725-C

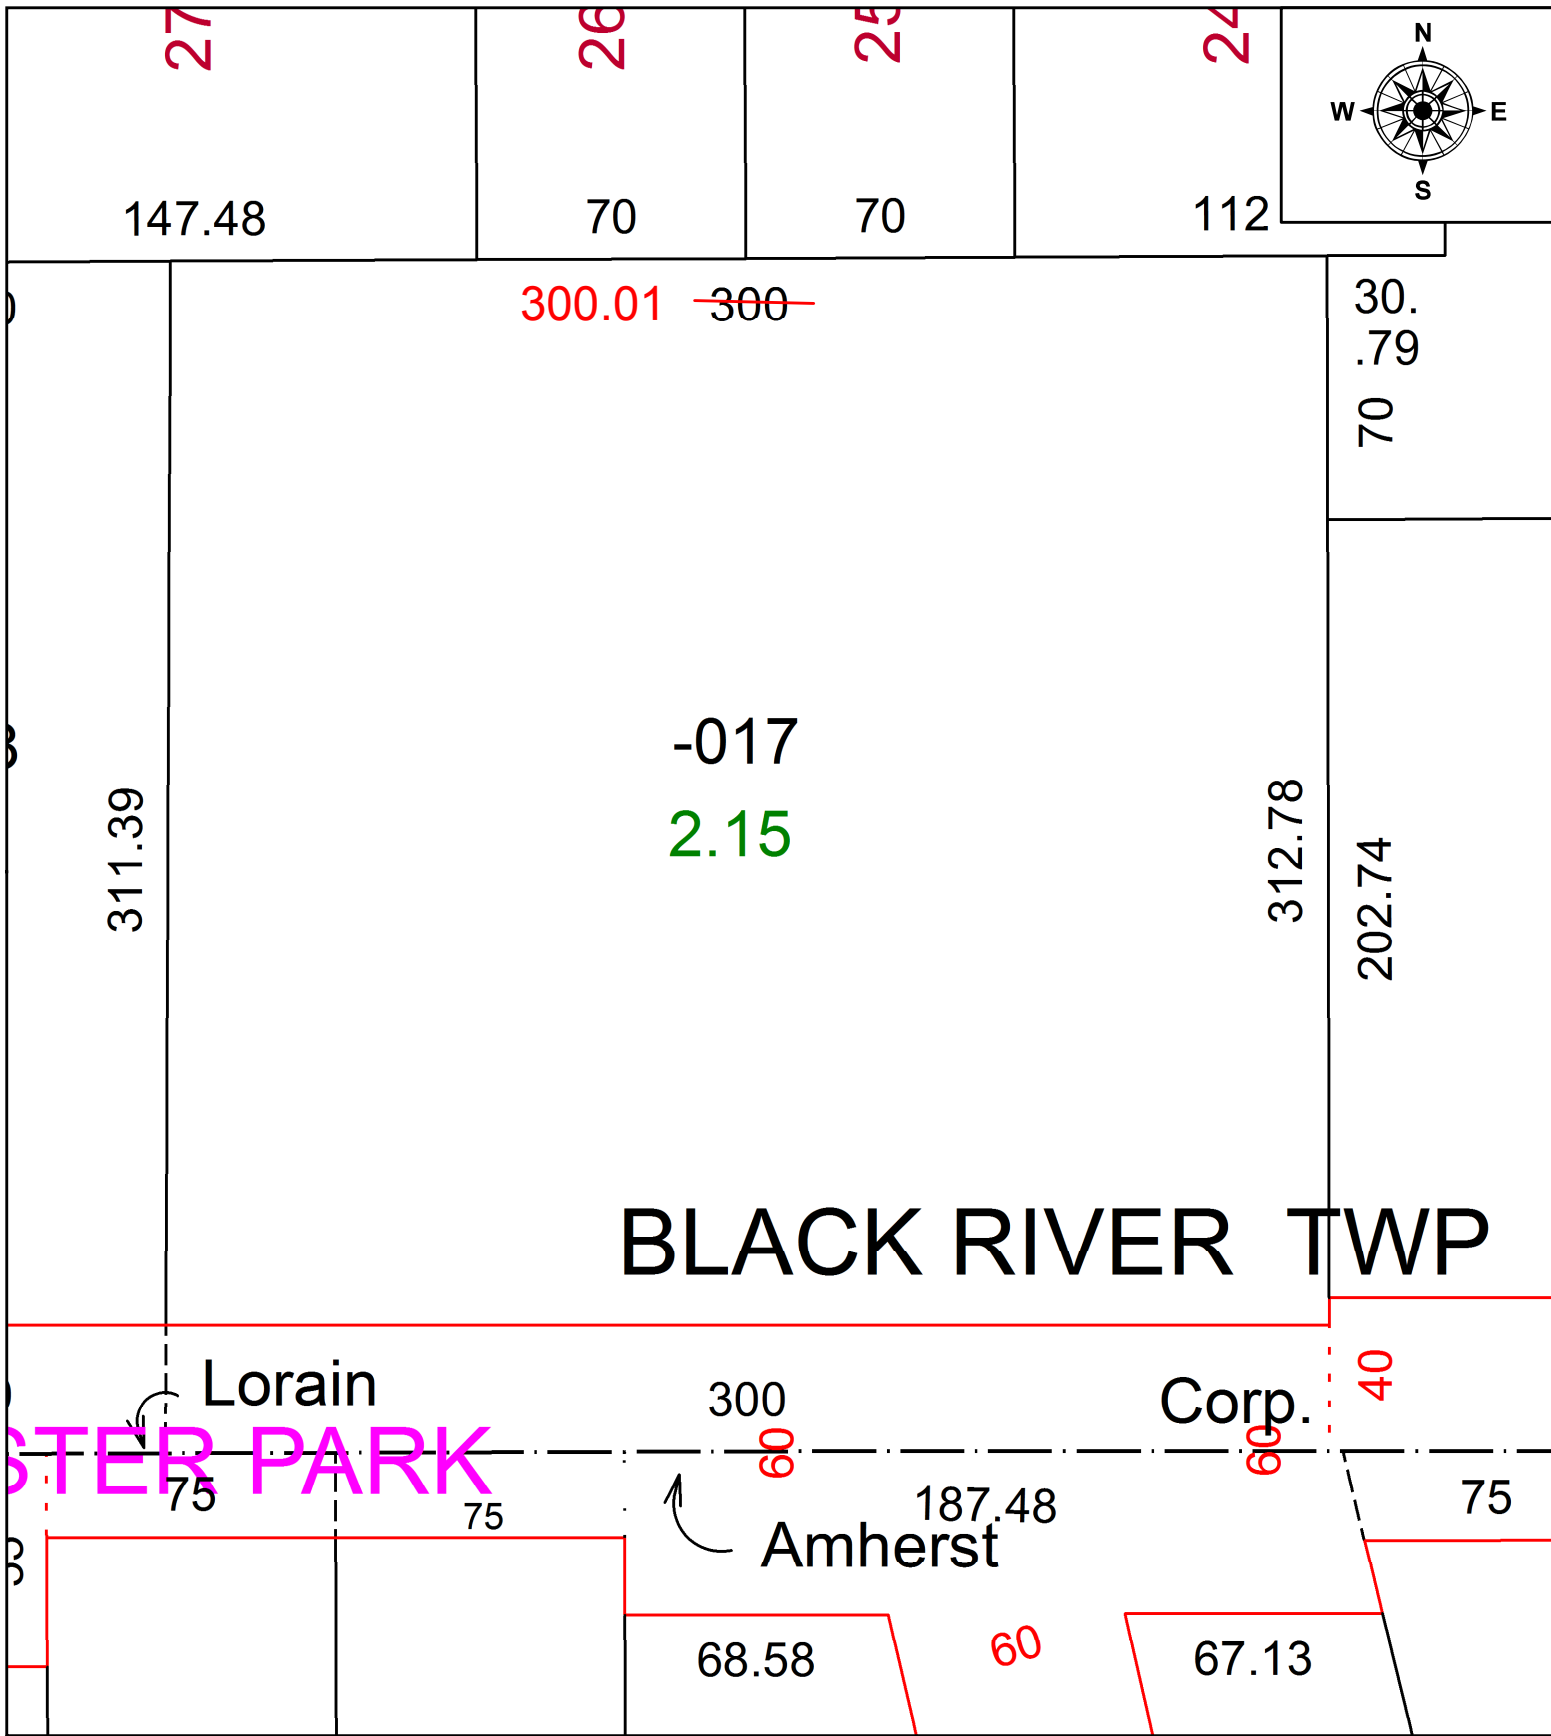

SPLITS/DEEDS PROCESSED
 LORAIN COUNTY TAX MAP DEPARTMENT
 226 MIDDLE AVE. ELYRIA, OH

SURVEYED BY: PATRICK MCGANNON
 CLOSURE: 1: 401,484
 MAP PAGE(S): 02-02-005
 APPROVED BY: DMA DATE: 11/19/2021
 SCALE: 1" = 50' PRIOR INSTRUMENT: 20200753090