


PARENT PARCEL: 03-00-038-113-020 THRU -026

CHILD PARCEL: 03-00-038-113-067 & -068

STARTING POINT: COMBINATION PER DEED

23-04728

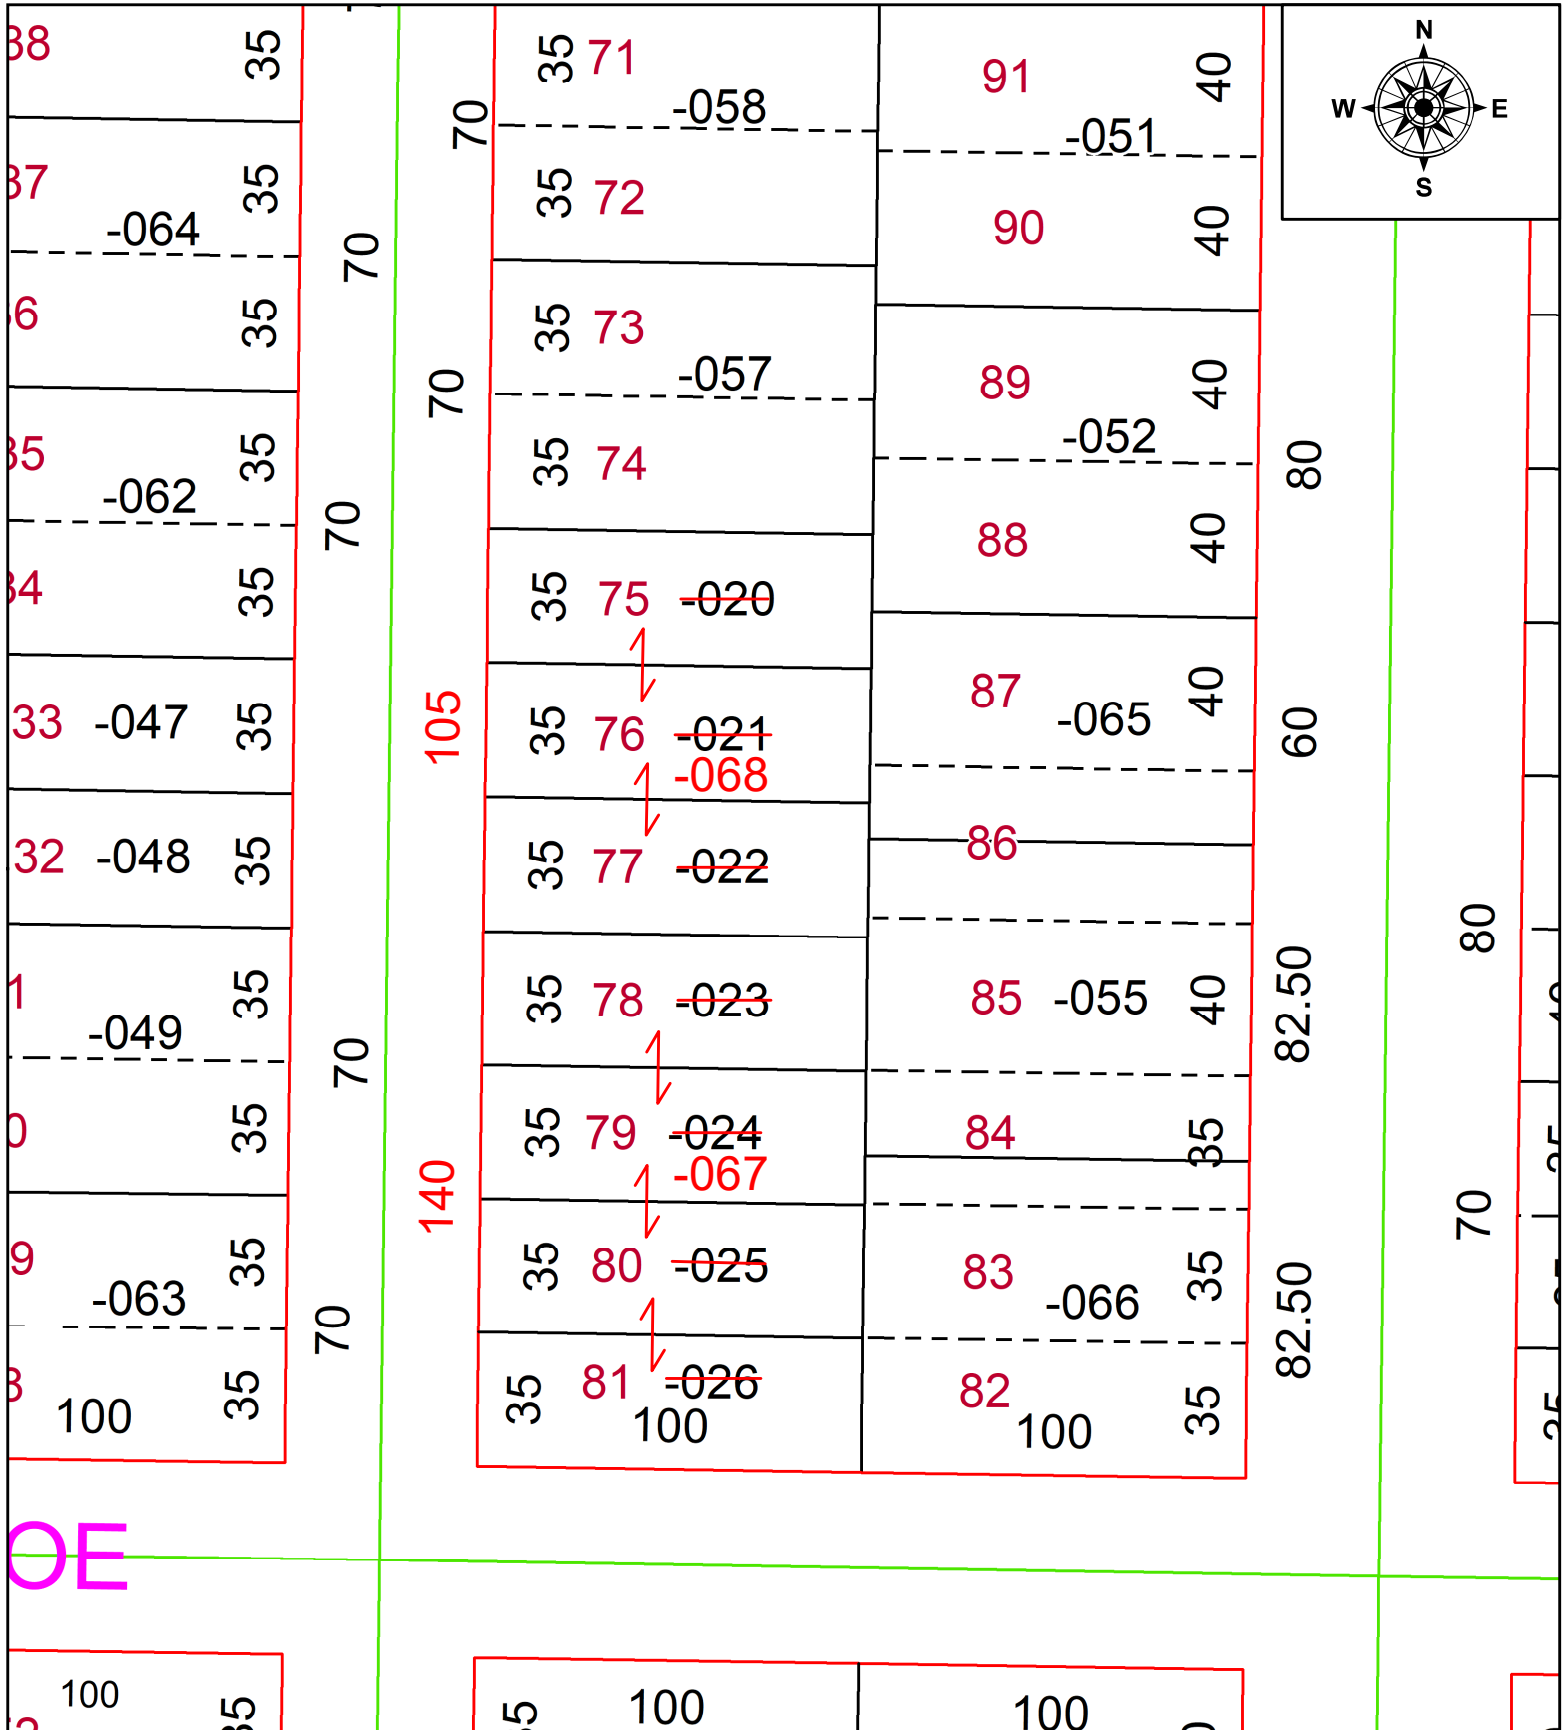

SPLITS/DEEDS PROCESSED
 LORAIN COUNTY TAX MAP DEPARTMENT
 226 MIDDLE AVE. ELYRIA, OH

SURVEYED BY: N/A SURV # N/A
 CLOSURE: N/A
 MAP PAGE(S): 03-00-038-B
 APPROVED BY: AC DATE: July 21, 2023
 SCALE: 1 in = 50 ft PRIOR INSTRUMENT: 2020- 0783780