


PARENT PARCEL: 01-00-073-000-025

CHILD PARCEL: **AC CORR PER SURV BY TIMOTHY D. HOZALSKI**

21-04729-A

STARTING POINT: SW CORNER OF O/L 73

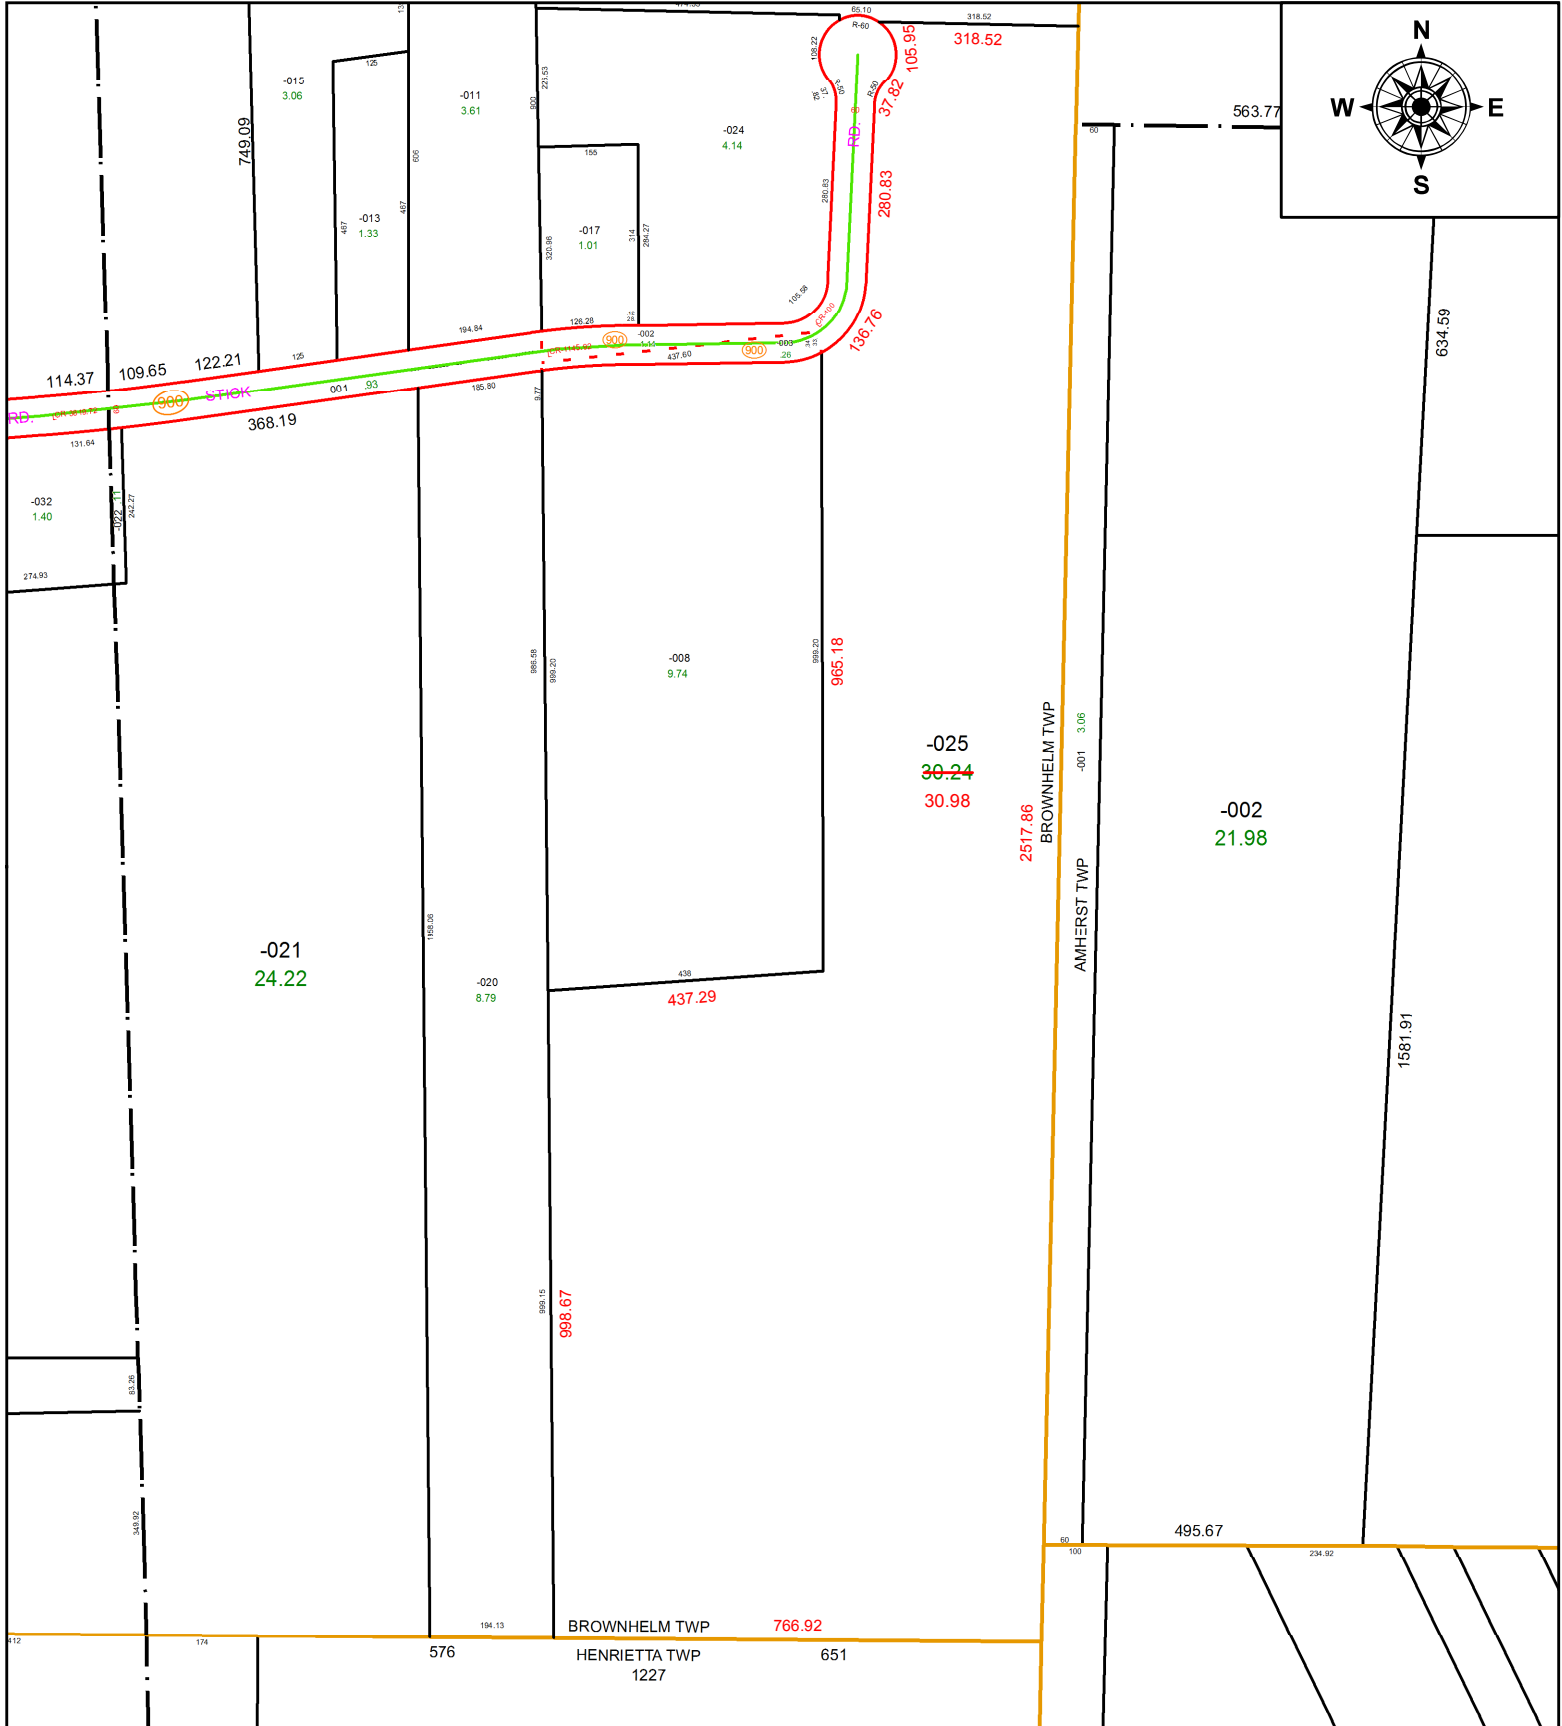

SPLITS/DEEDS PROCESSED
 LORAIN COUNTY TAX MAP DEPARTMENT
 226 MIDDLE AVE. ELYRIA, OH

SURVEYED BY: TIMOTHY D. HOZALSKI

CLOSURE: 1: 586357

MAP PAGE(S): 01-00-073

APPROVED BY: AC **DATE:** 11/23/2021

SCALE: 1" = 300 **PRIOR INSTRUMENT:** 1985- 0197003