


PARENT PARCEL: 12-00-020-102-001 & -003

CHILD PARCEL: **DEPTH CORR. PER SURVEY**



STARTING POINT: CL OF SPRAGUE RD. & WESTERLY LONE OF O.L. 20

21-04730-C

# CUYAHOGA

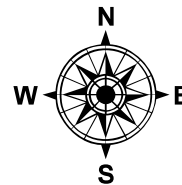

70

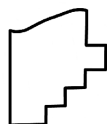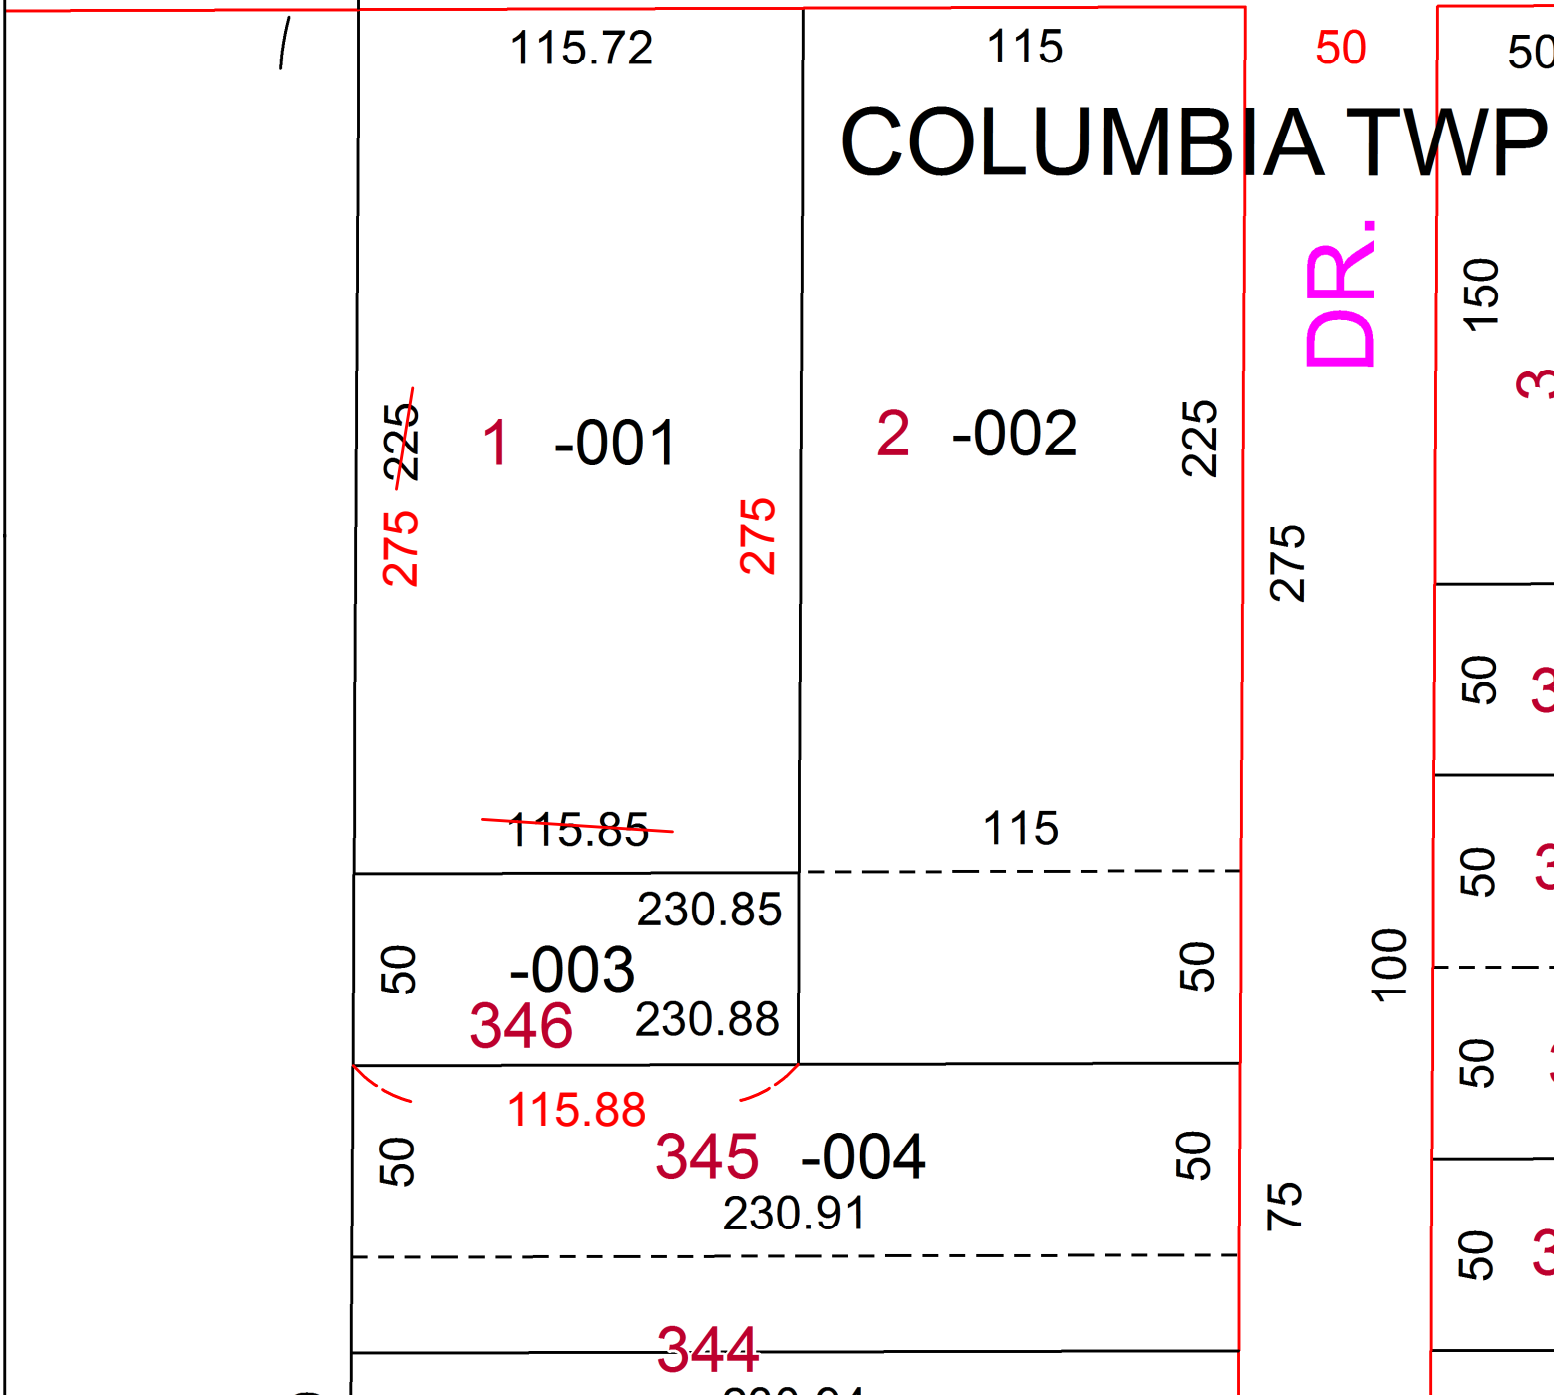

**SPLITS/DEEDS PROCESSED**  
 LORAIN COUNTY TAX MAP DEPARTMENT  
 226 MIDDLE AVE. ELYRIA, OH

SURVEYED BY: SEAN BOLAND  
 CLOSURE: 1: 579084  
 MAP PAGE(S): 12-00-020  
 APPROVED BY: DMA DATE: 11/23/2021  
 SCALE: 1" = 50' PRIOR INSTRUMENT: 20210838219