


PARENT PARCEL: 03-00-056-123-020 & -021

CHILD PARCEL: 03-00-056-123-022

STARTING POINT:

23-04731

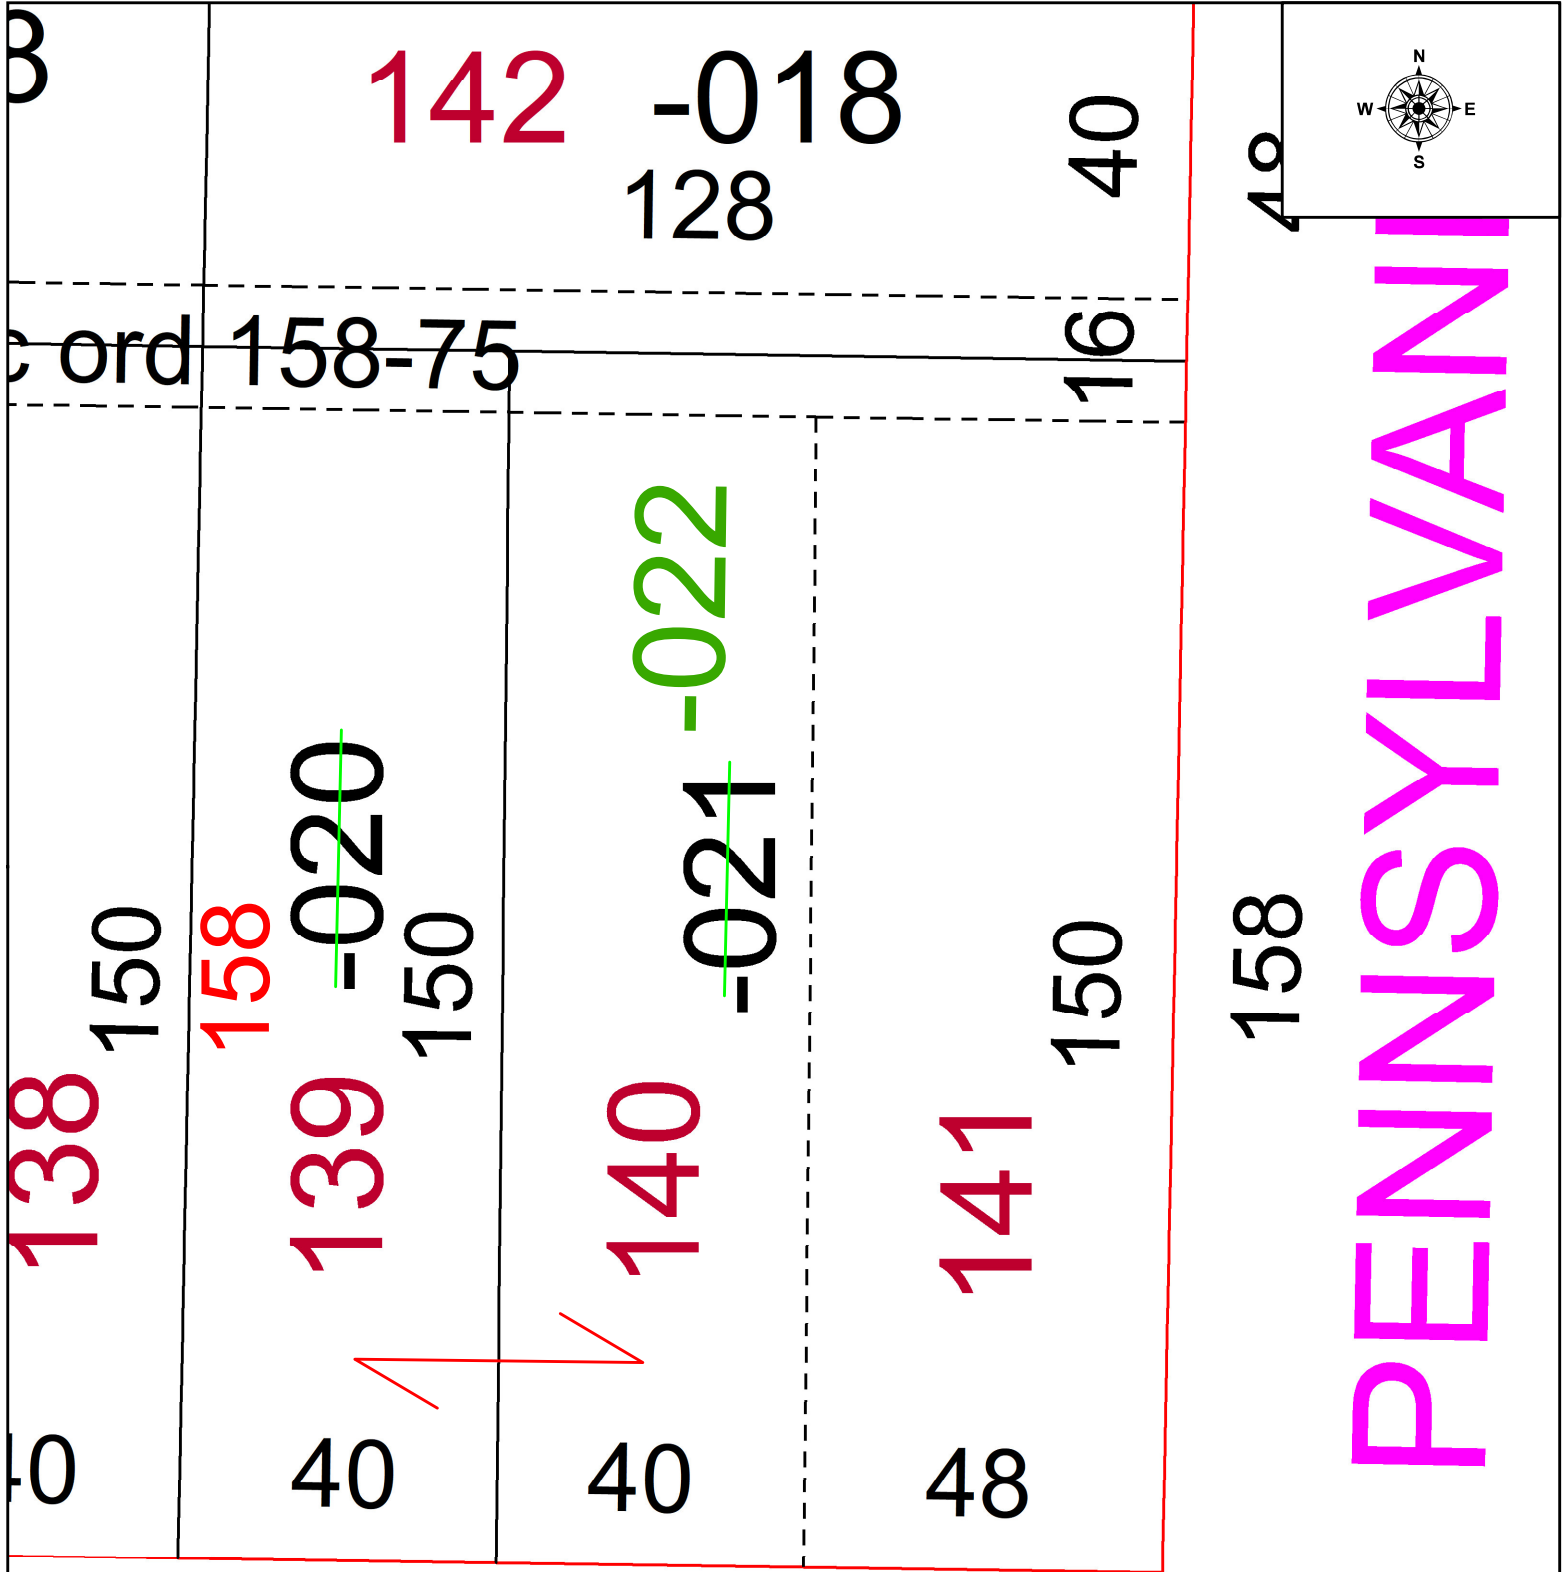

SPLITS/DEEDS PROCESSED
 LORAIN COUNTY TAX MAP DEPARTMENT
 226 MIDDLE AVE. ELYRIA, OH

SURVEYED BY: _____ N/A SURVEY # N/A
 CLOSURE: _____ 1:
 MAP PAGE(S): _____ 03-00-056
 APPROVED BY: _____ WRZ DATE: 7/26/2023
 SCALE: 1" = 25' PRIOR INSTRUMENT: #2023-0920120