


PARENT PARCEL: 08-00-086-000-023

CHILD PARCEL: **AC. CORR. PER SURVEY**

STARTING POINT: CL OF GIFFORD RD. & MILAN-ELYRIA RD.

21-04733-A

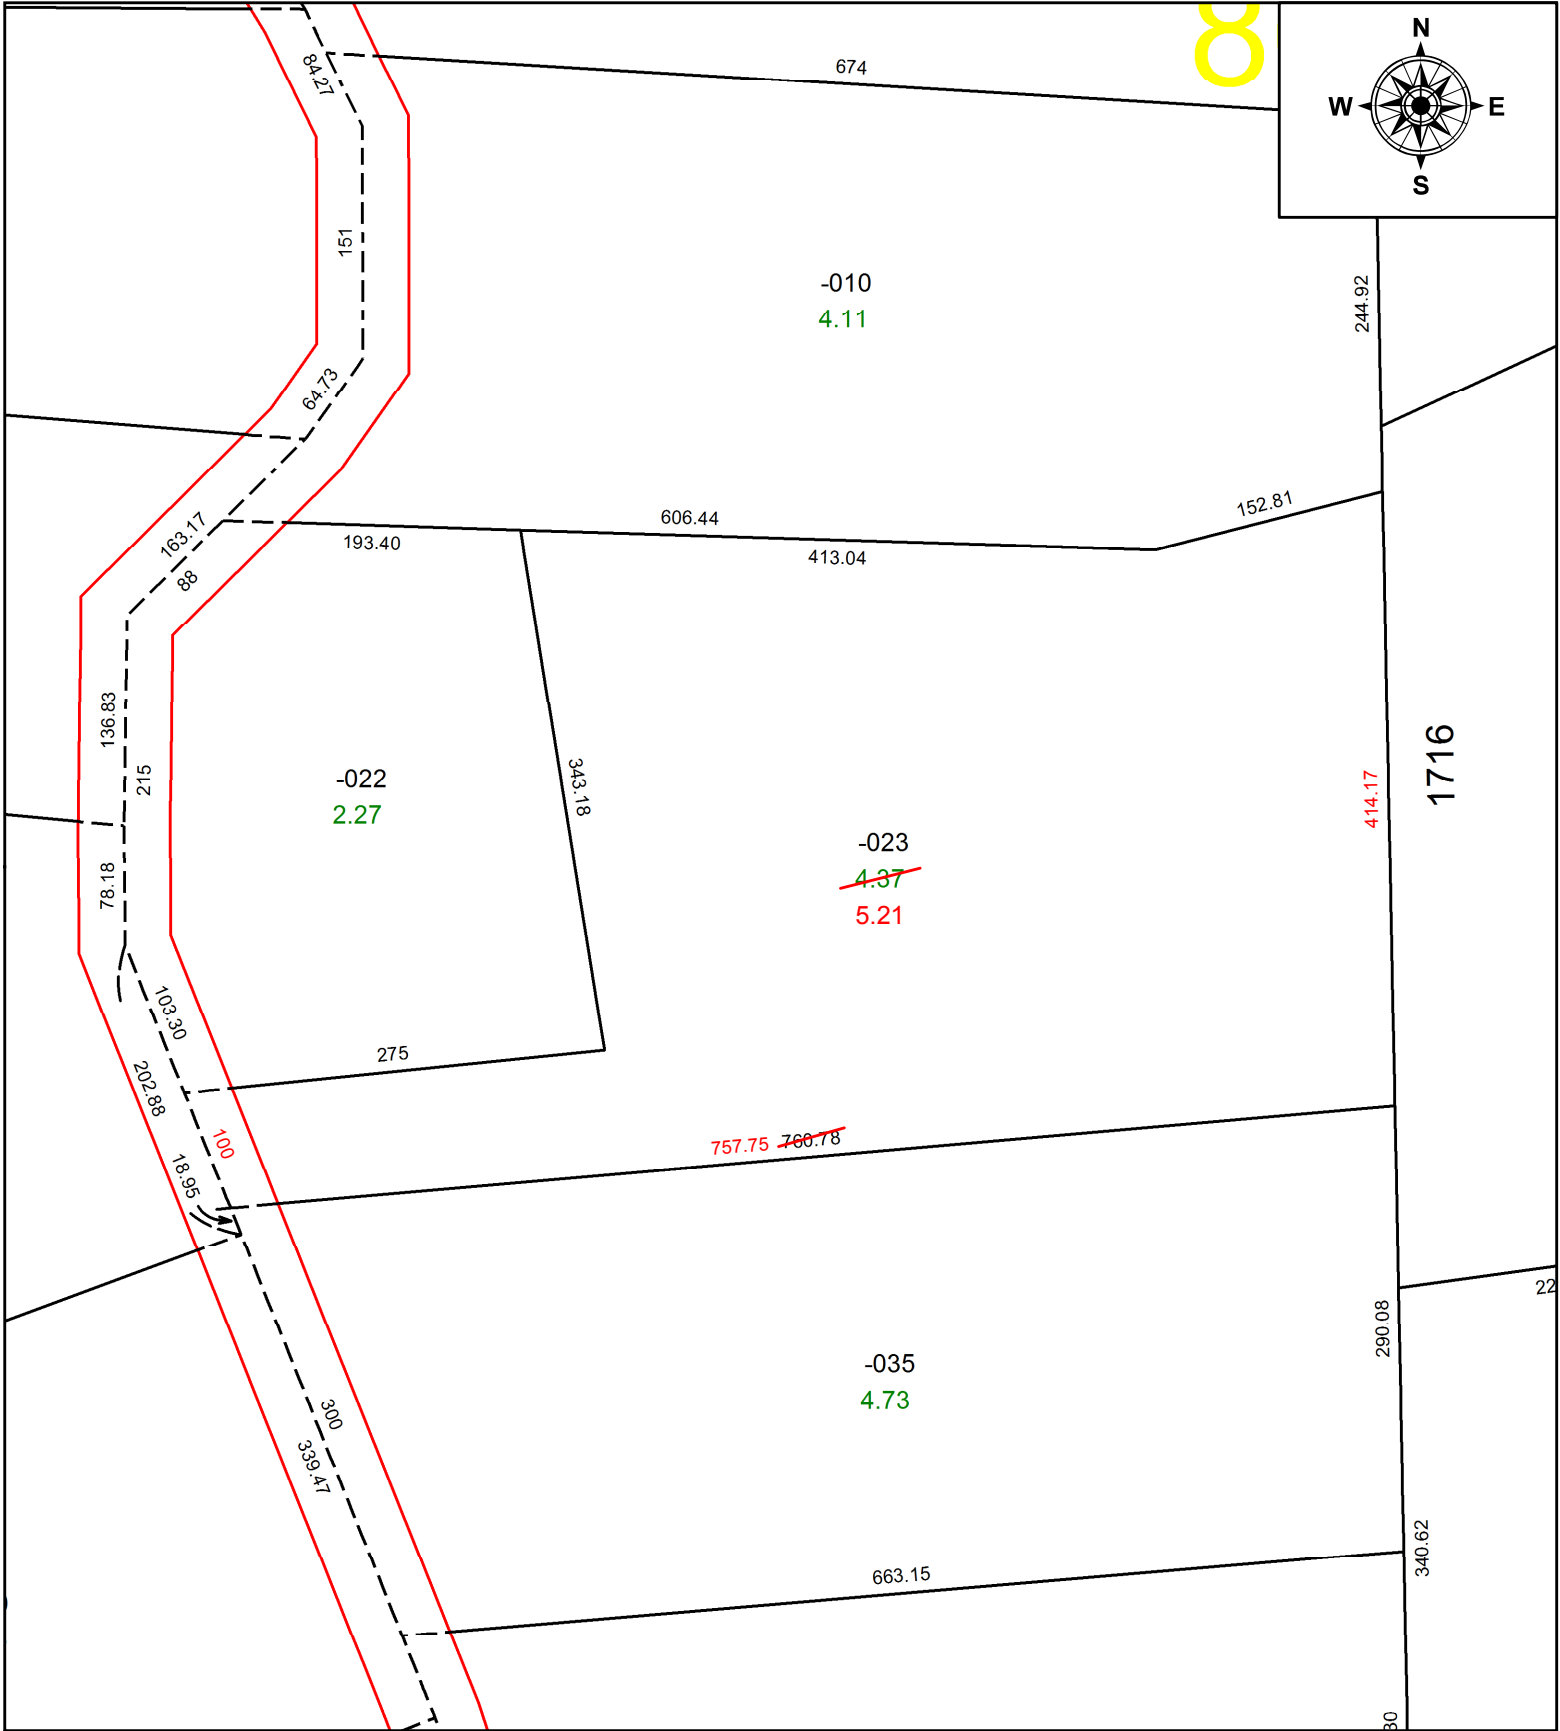

**SPLITS/DEEDS PROCESSED**  
 LORAIN COUNTY TAX MAP DEPARTMENT  
 226 MIDDLE AVE. ELYRIA, OH

**SURVEYED BY:** THOMAS SNEZEK  
**CLOSURE:** 1: 770,431  
**MAP PAGE(S):** 08-00-086  
**APPROVED BY:** DMA **DATE:** 11/24/2021  
**SCALE:** 1" = 125' **PRIOR INSTRUMENT:** 20160610614